

#12844

APPROVED
LORAIN CO.
MAP DEPT.

DATE 6-29-79

PAGE 400-019L


BY *Bohndy*

VOID
AFTER

NOV 23 1979

Bo

LEARN NAGLE

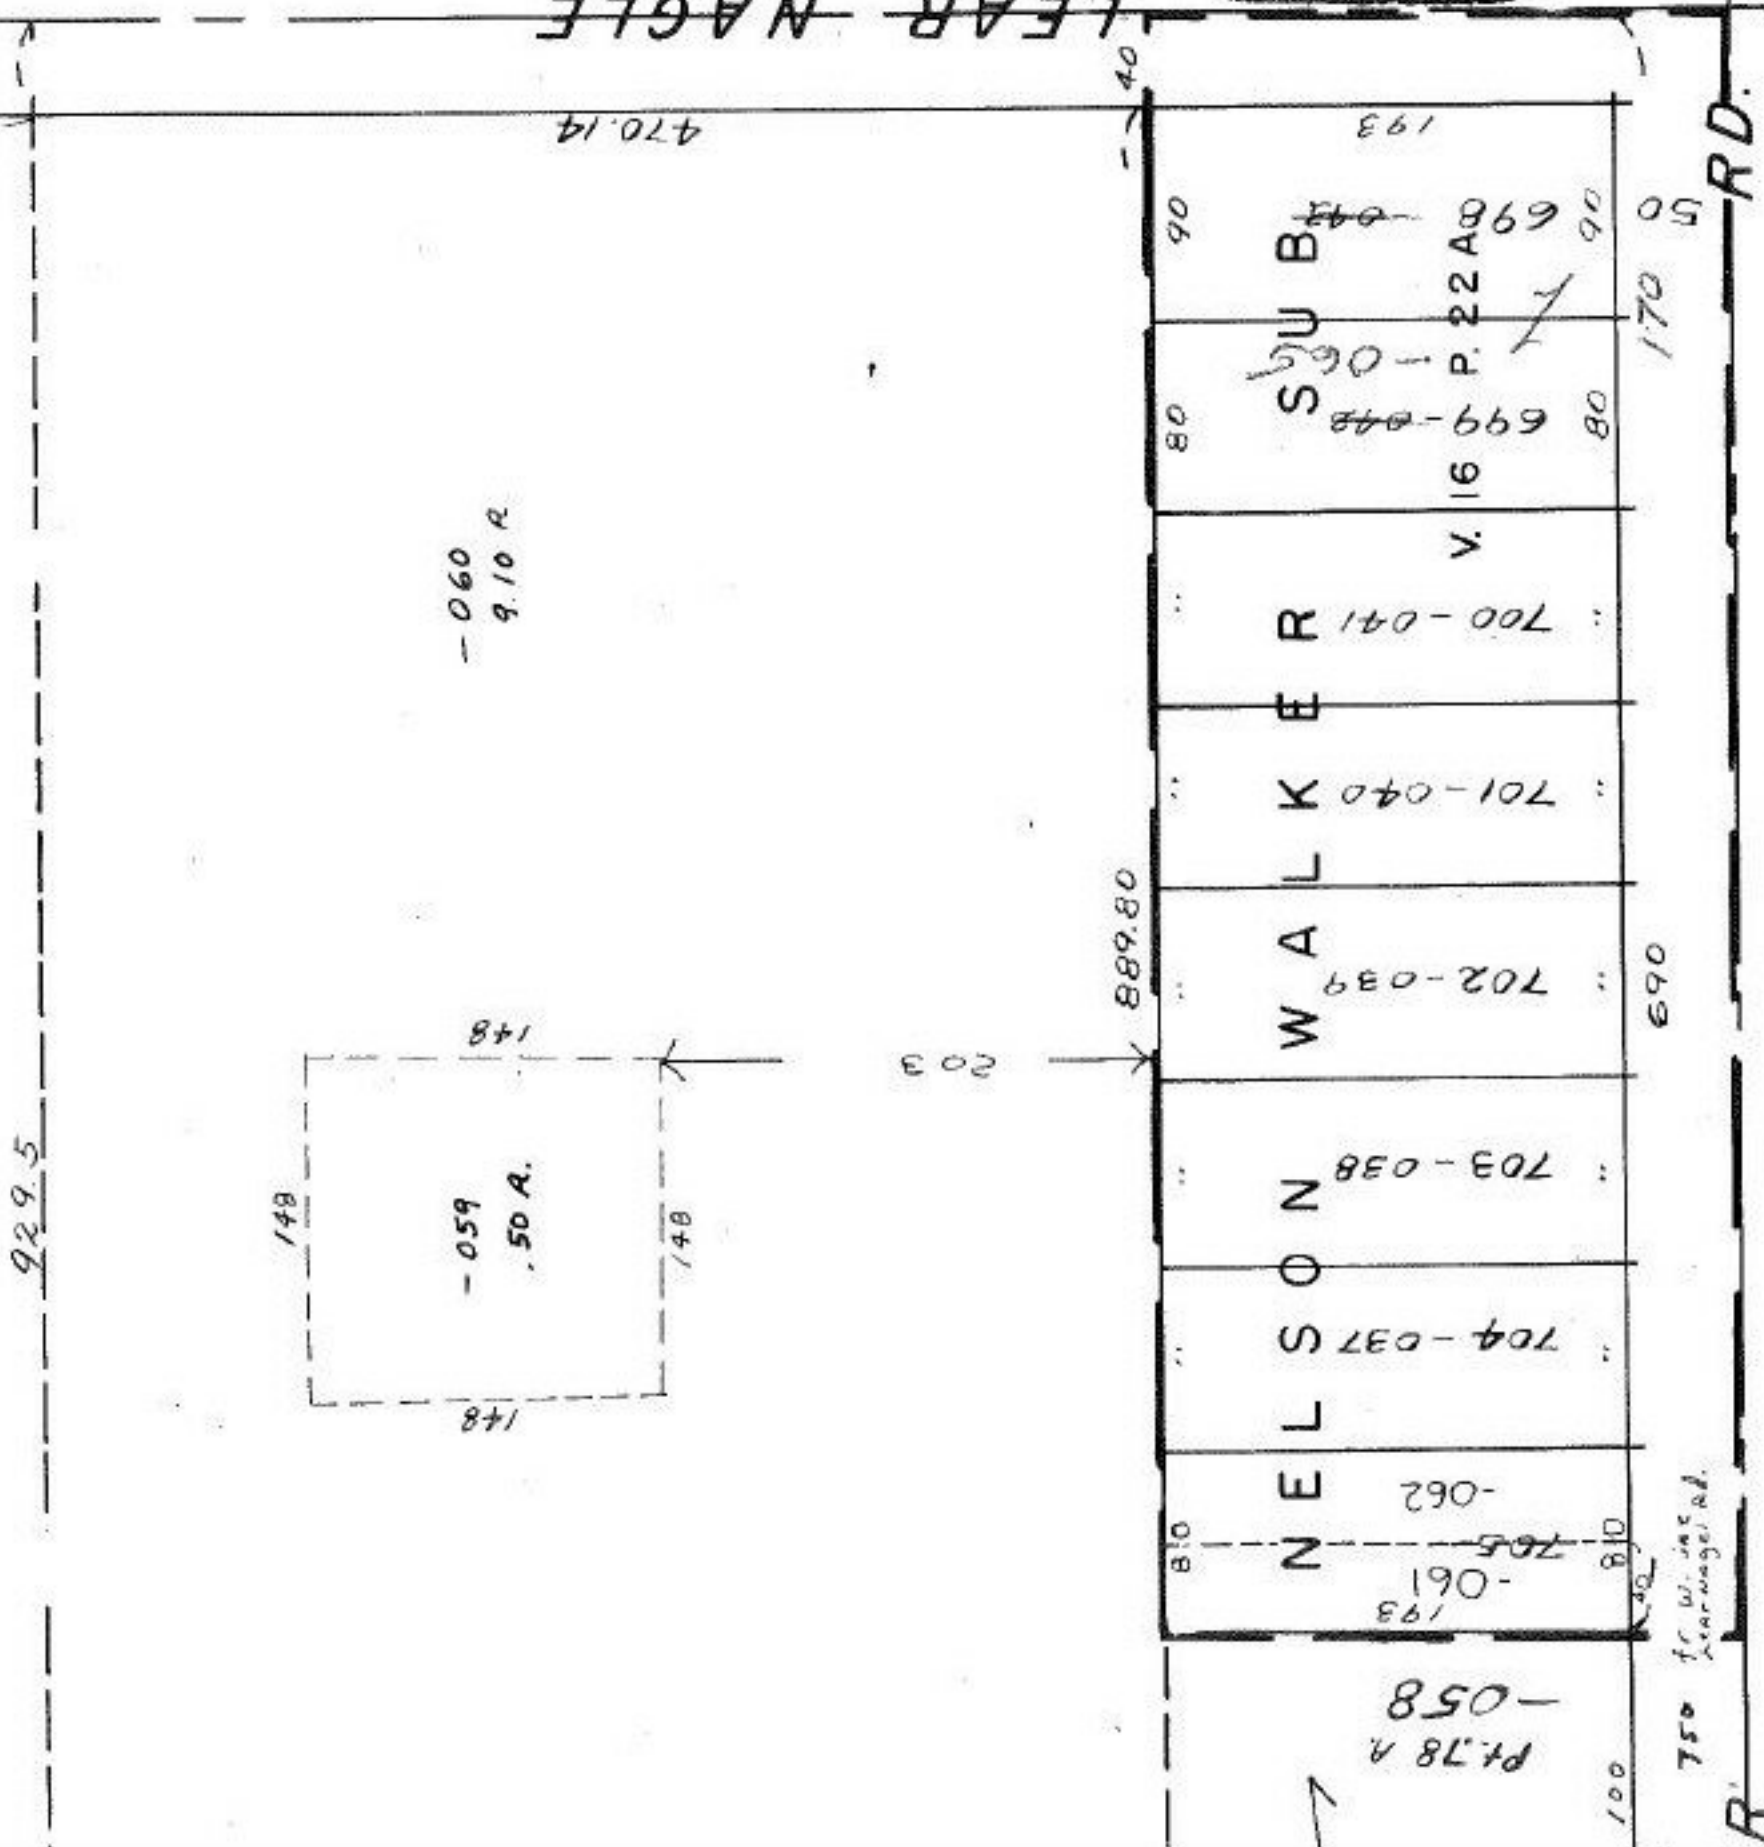

SEE 4-C