

2.98

06
4F.

NOV 1 1979

#12854

APPROVED	
LORAIN CO.	
MAP DEPT.	
DATE	7-5-79
PAGE	9-00-076-B
BY	T. McNeil
VOID AFTER	

#12854


- 010
3.00F.

ALSO SEE SPILT 12705

46.48

296.85

341.85

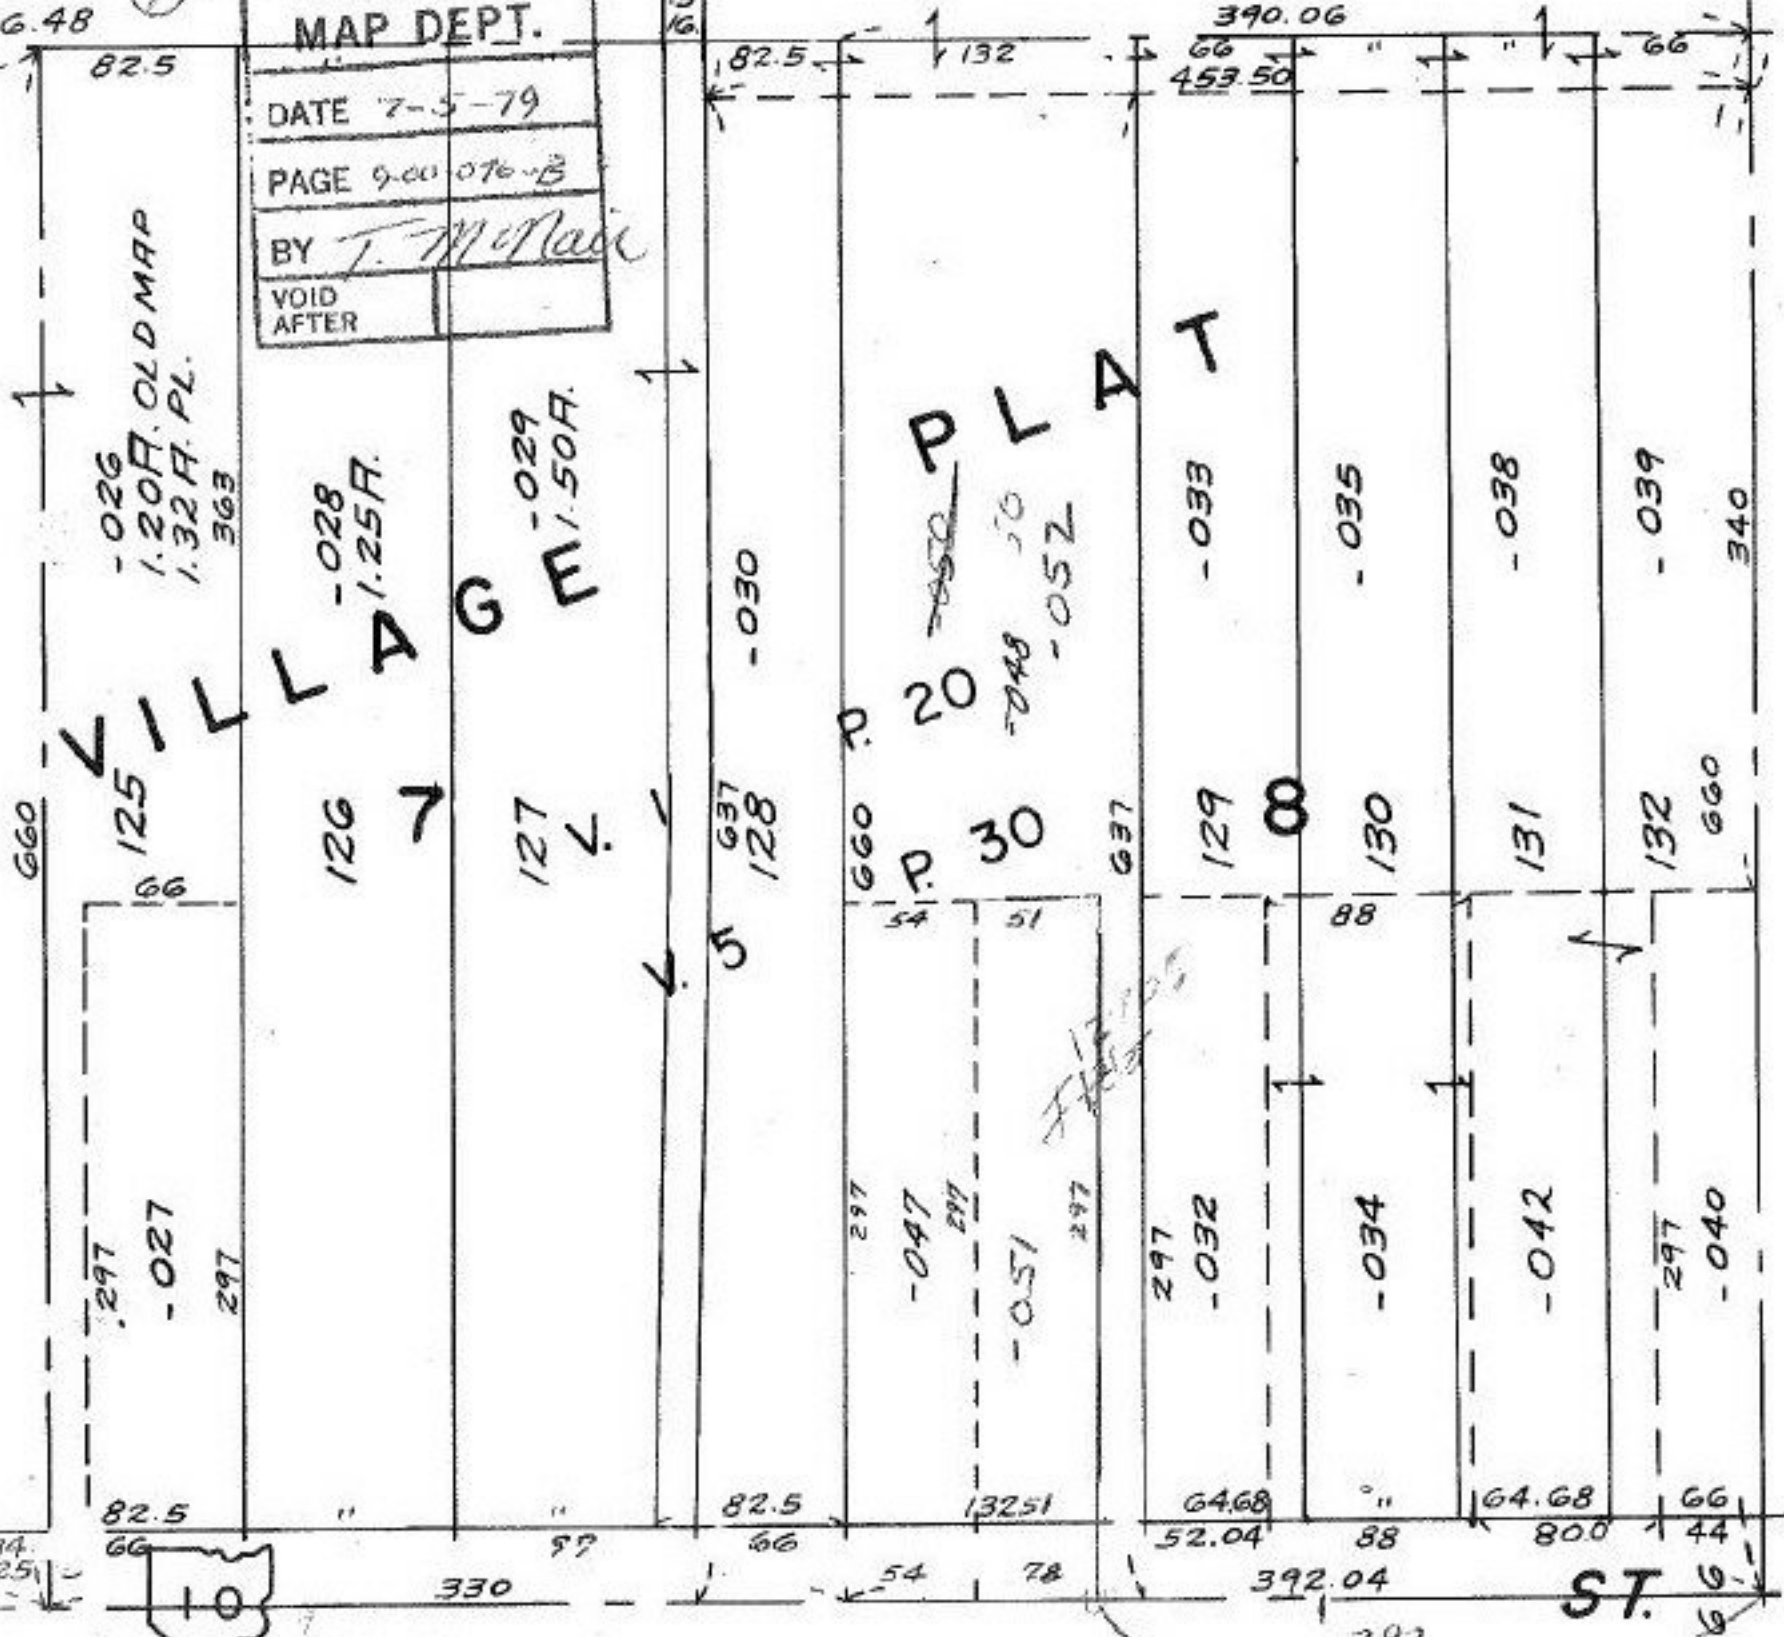

7-00-086-B

282