

#12863

54.63	54.21
42	41
<hr/>	<hr/>
54.21	53.80
41	
<hr/>	
53.80	


- 093
53.80A

#12863

#12863

APPROVED LORAIN CO. MAP DEPT.
DATE 7-6-79
PAGE 4-00-003-F
BY T. McMain
VOID AFTER

NOV 23 1979

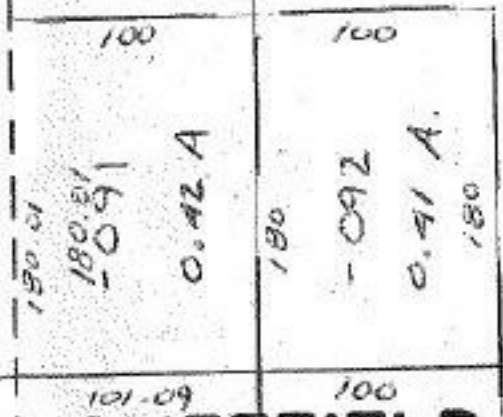

SHEFFIELD - FRENCH CREEK
SEE 4-00-002-B