


#12882

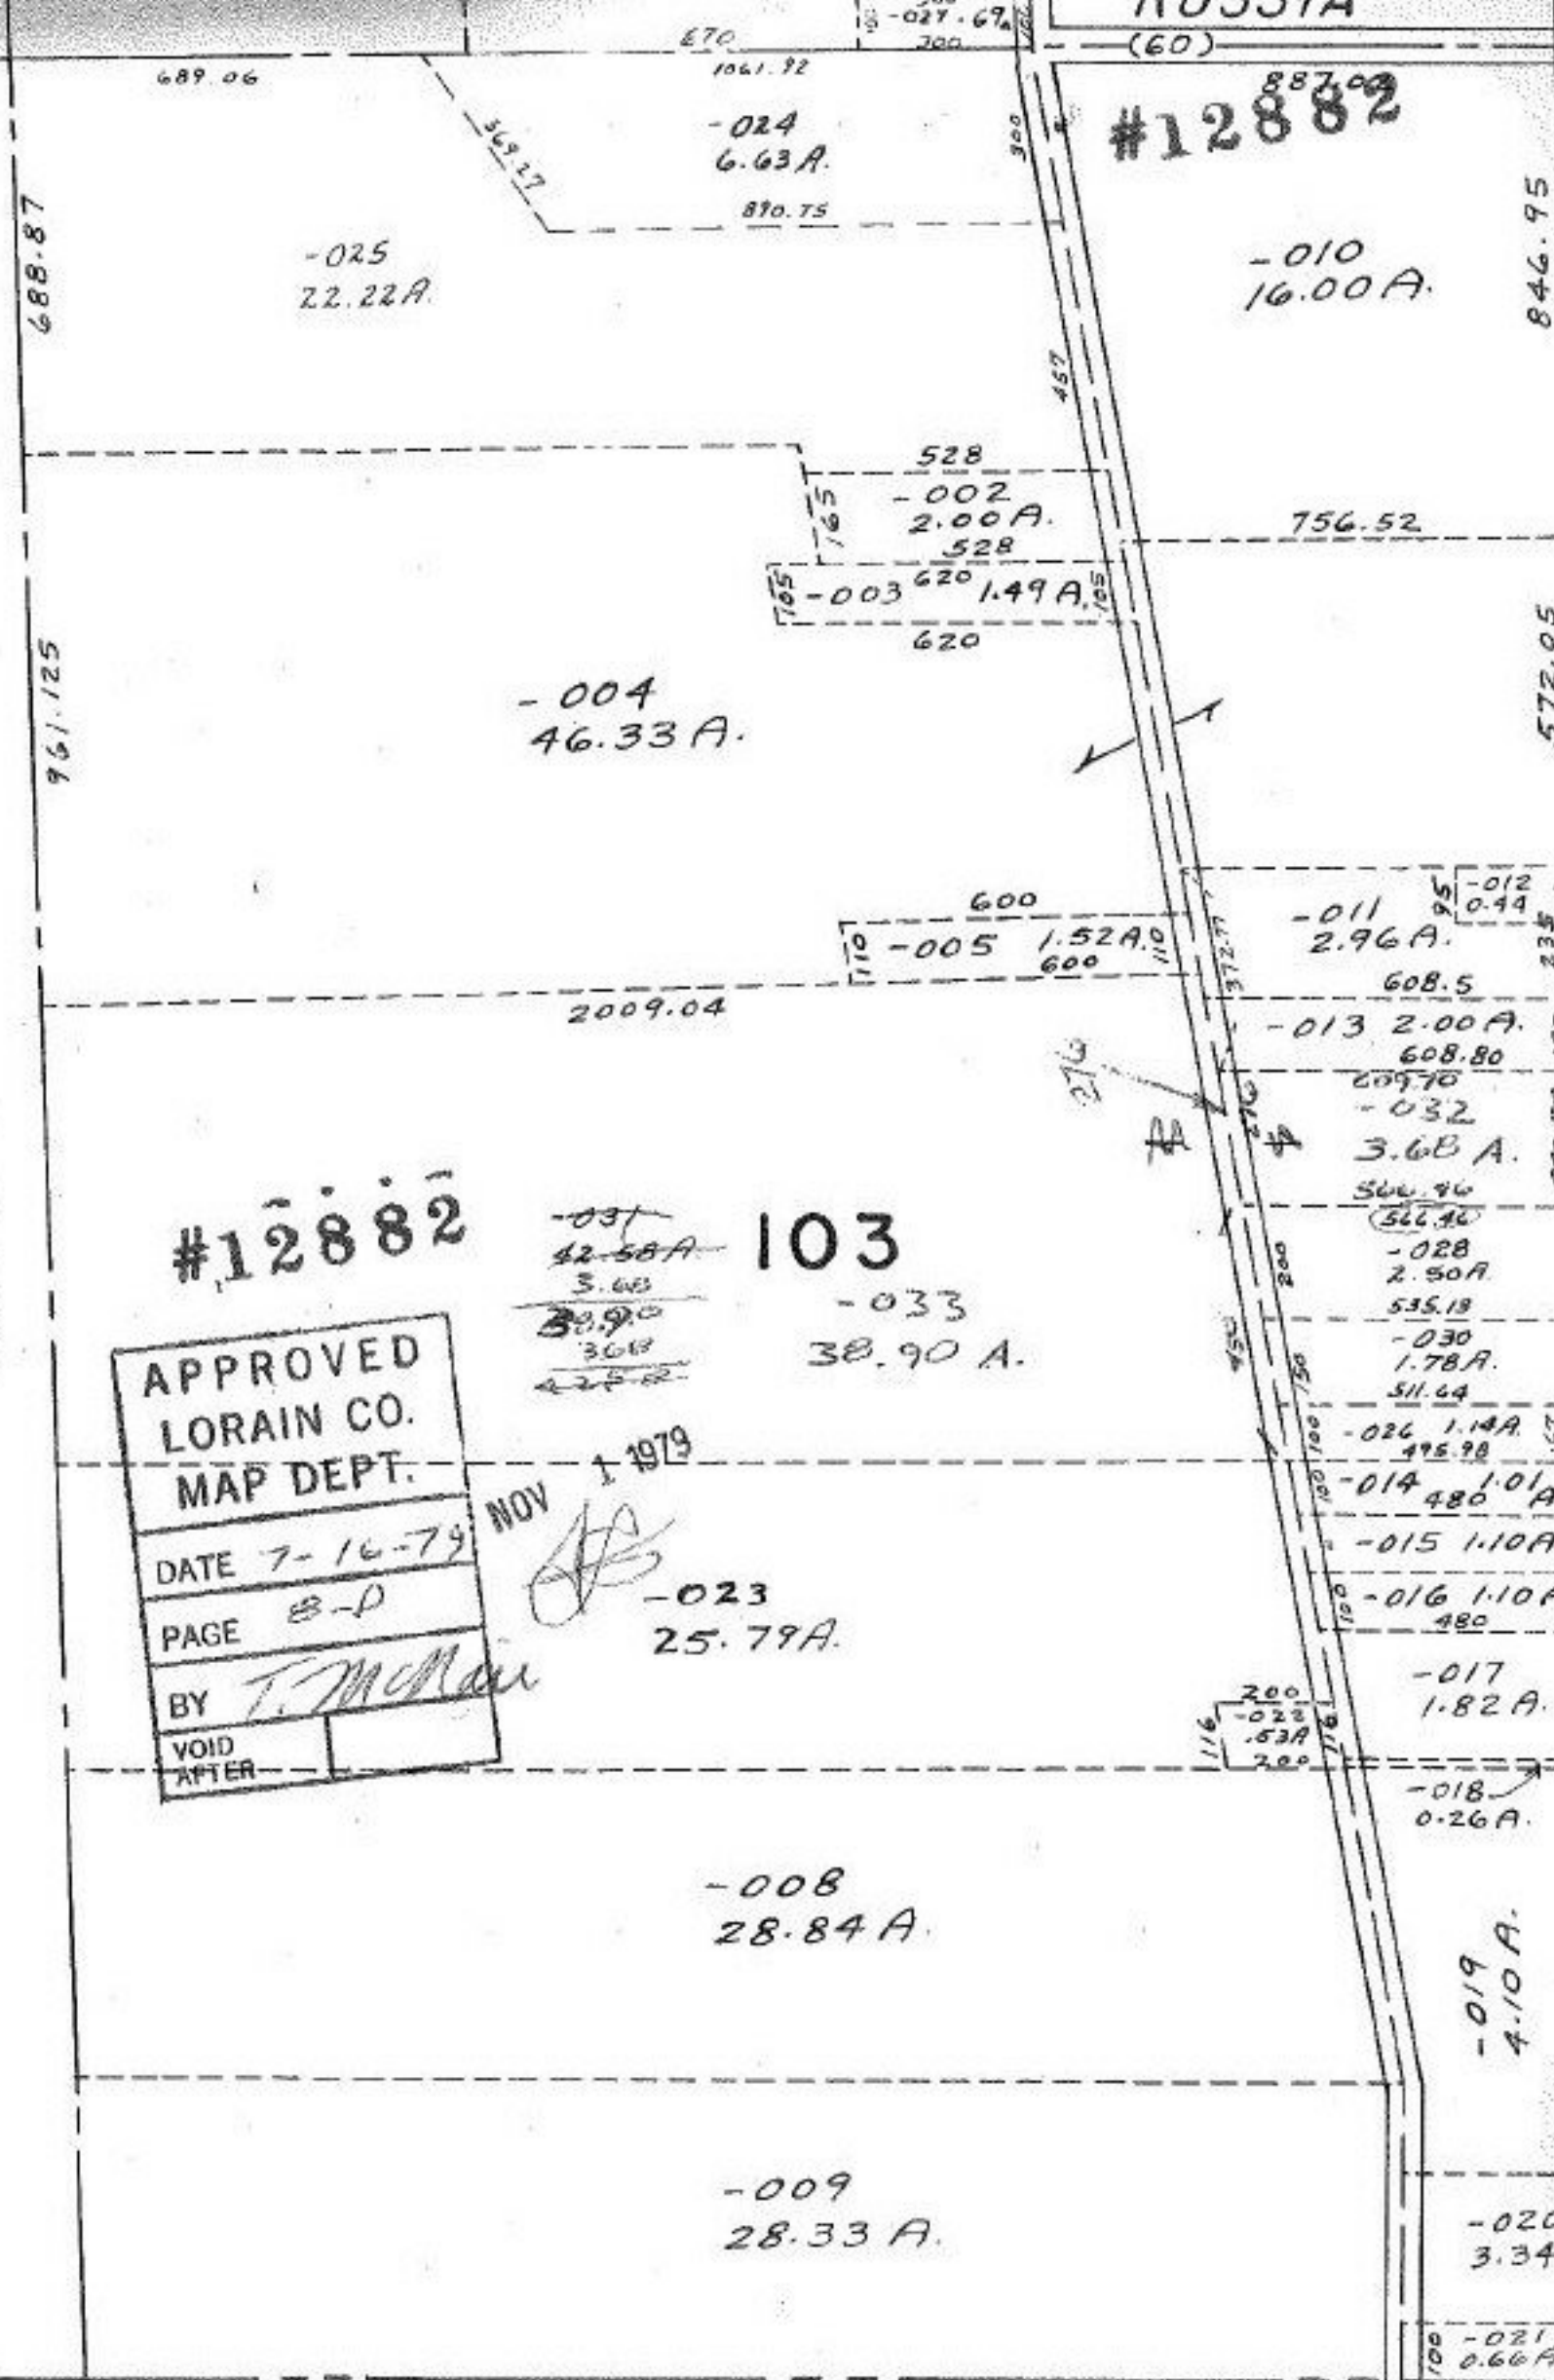

SEE B-C

#12882

103

APPROVED  
LORAIN CO.  
MAP DEPT.

DATE 7-16-79

PAGE B-D

BY T. McMan

VOID AFTER

NOV 1 1979

*[Signature]*

-023  
25.79 A.