


1593.68

3-900-001
6A.

#12890 LANE

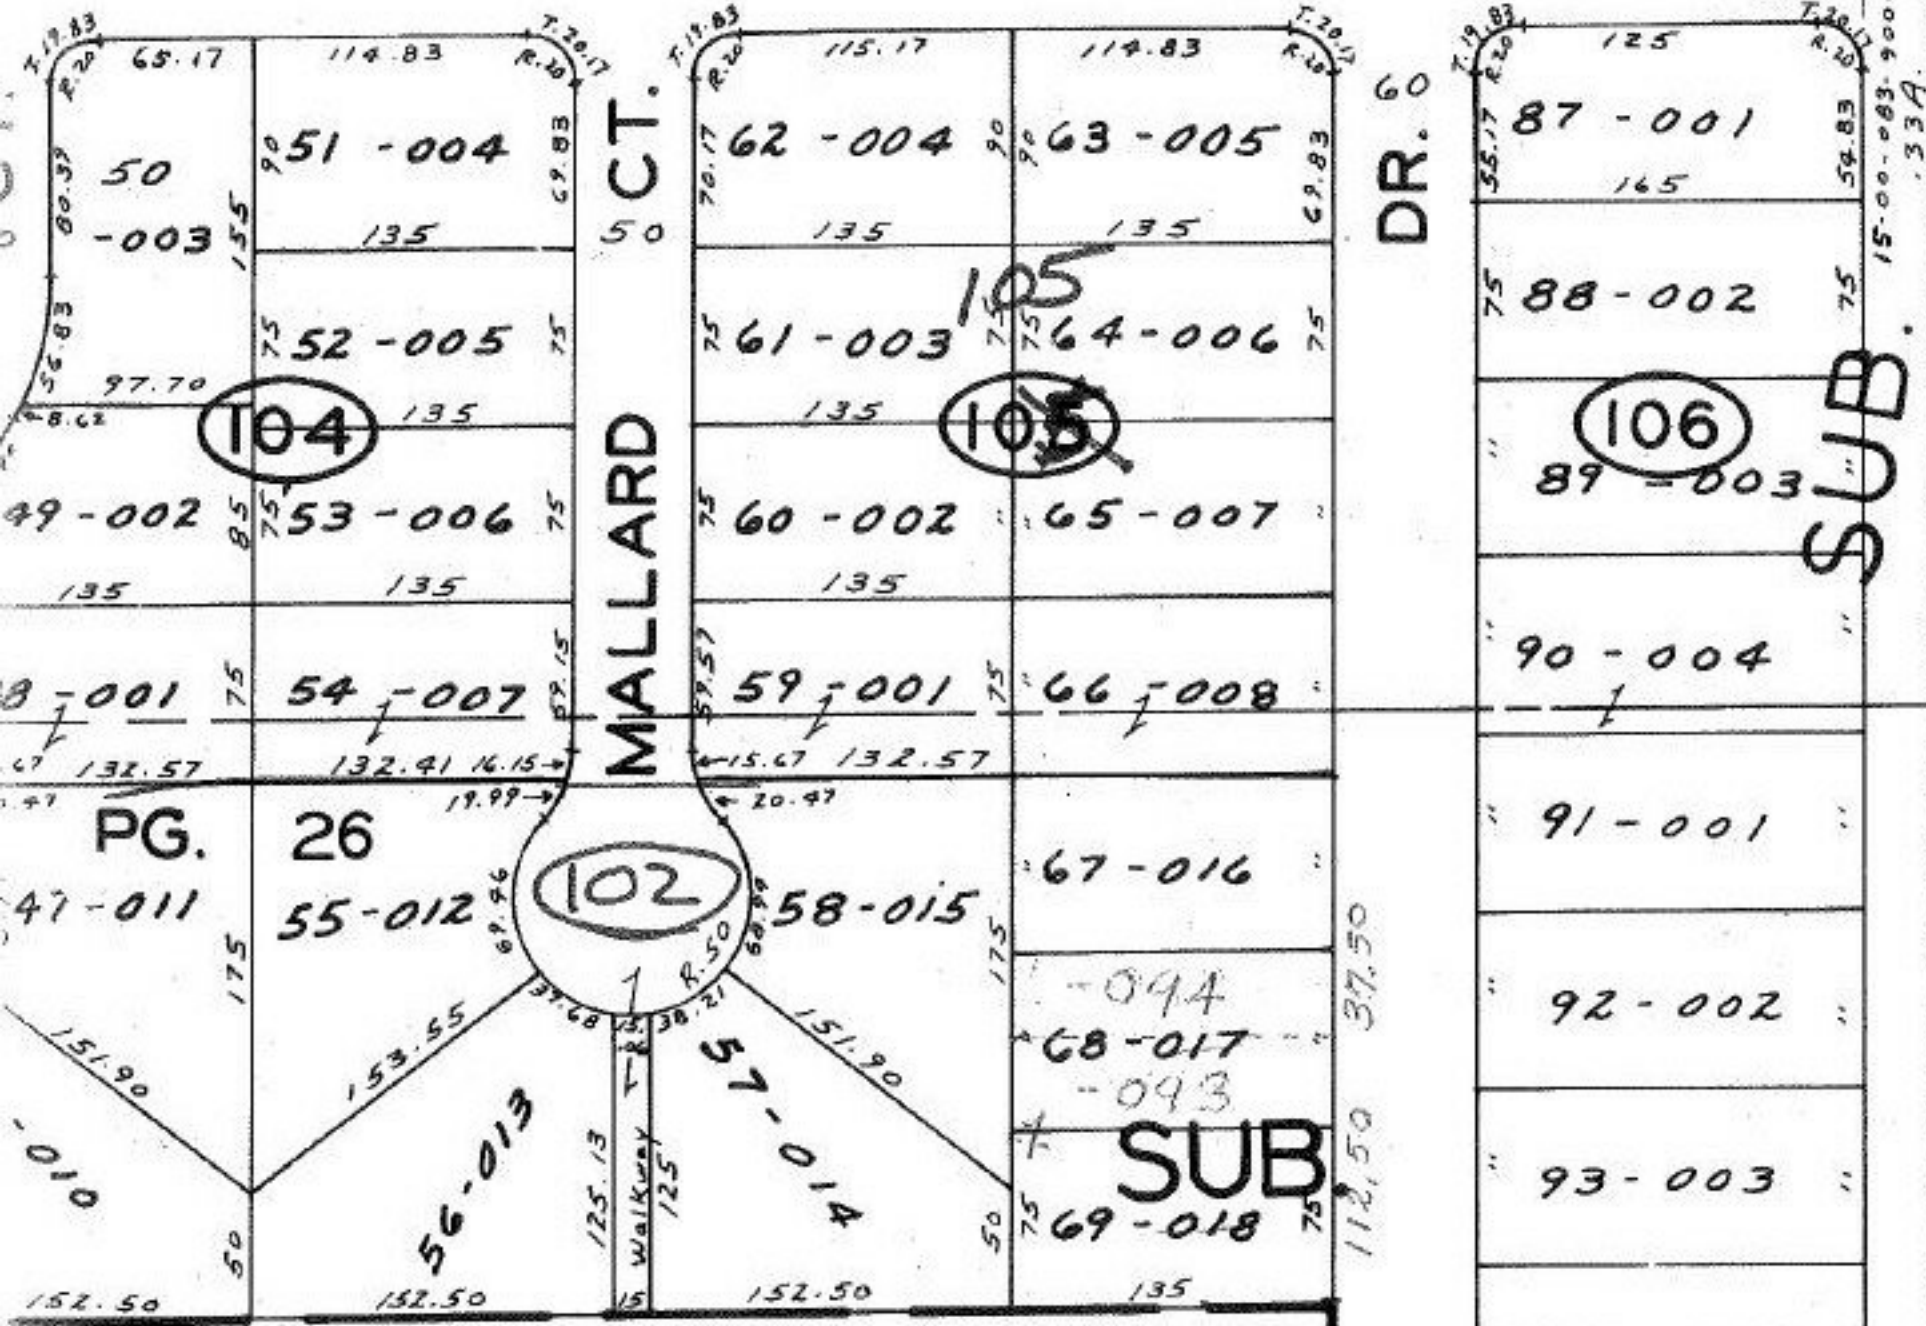

#12890

OCT 22 1979

APPROVED
TO MAIN U.S.
MAP DEPT.
DATE 7-17-79
PAGE 15-00-098-B
BY Carolyn J.
VOID AFTER 12890

98-008