

#12896

APPROVED
LORAIN CO.
MAP DEPT.

DATE 7-18-79


PAGE 10-00-004G

BY *[Signature]*

VOID
AFTER

NOV 1 1979

VAC.
COMM. RES. No.
79-117

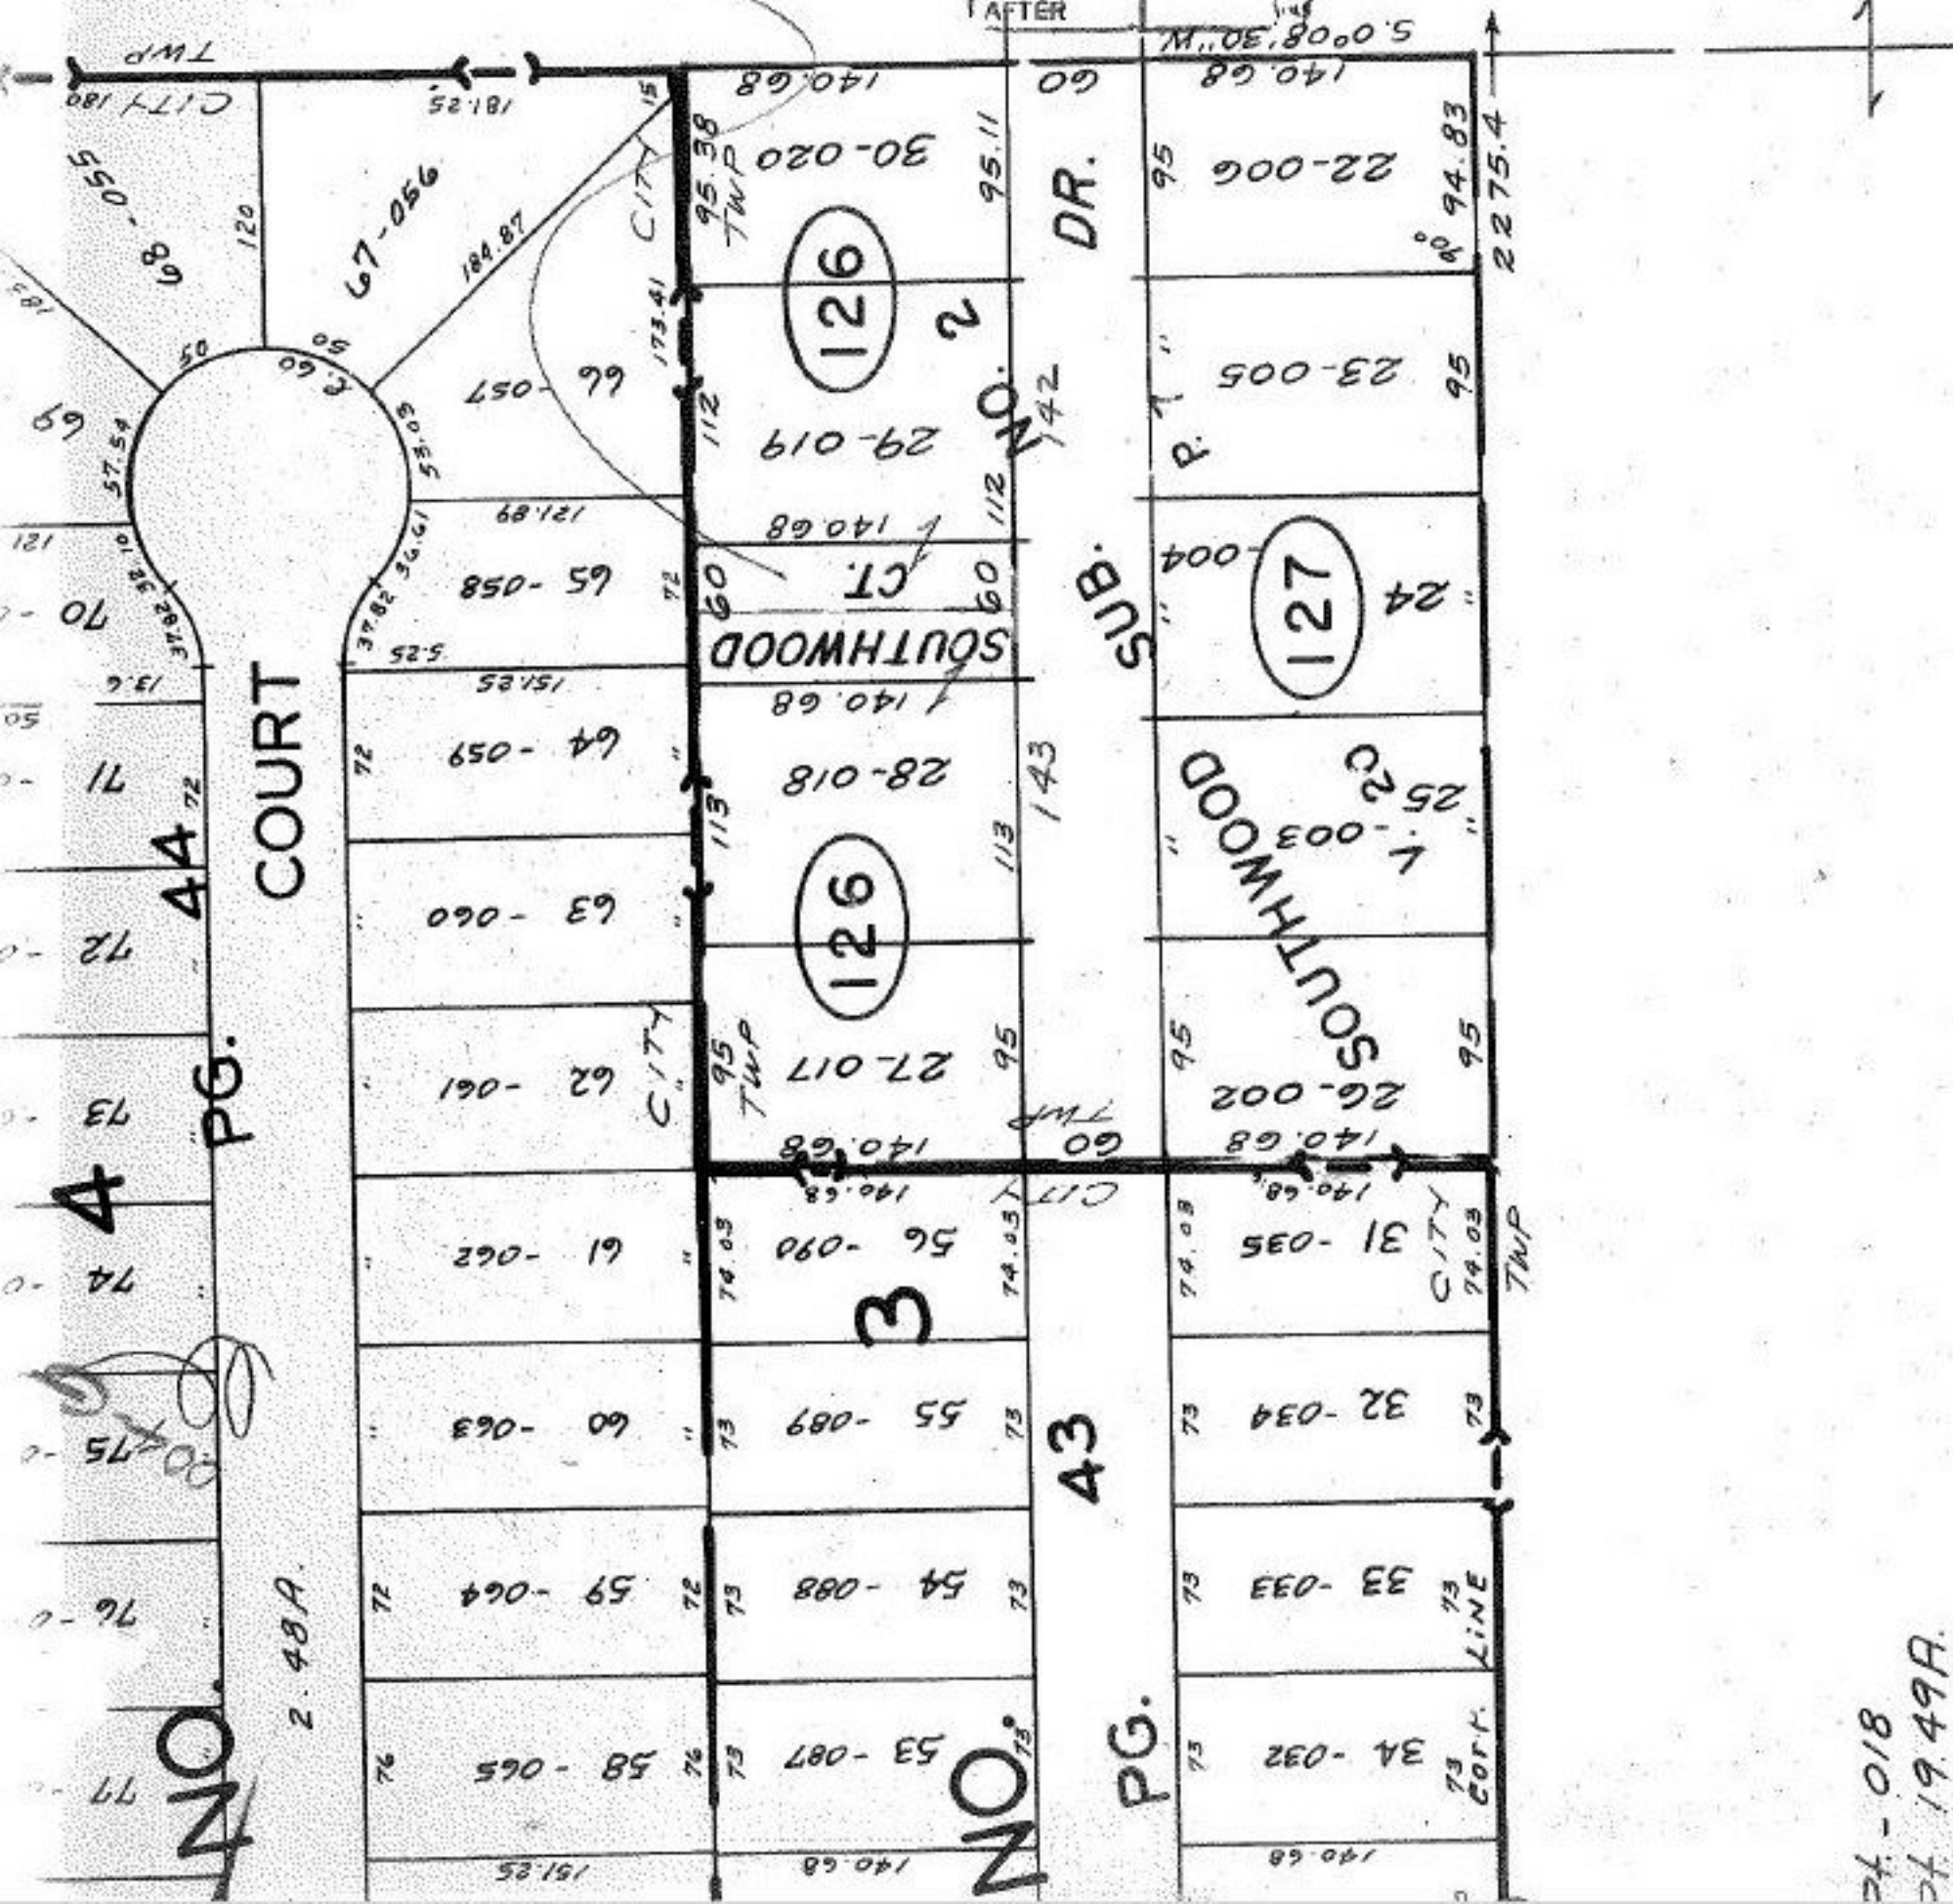

74-018
74-1949A