


RIDGE

07-00-047-000-015
Pt 1.00A

#12919

See Vol 100
50A Part

SEC

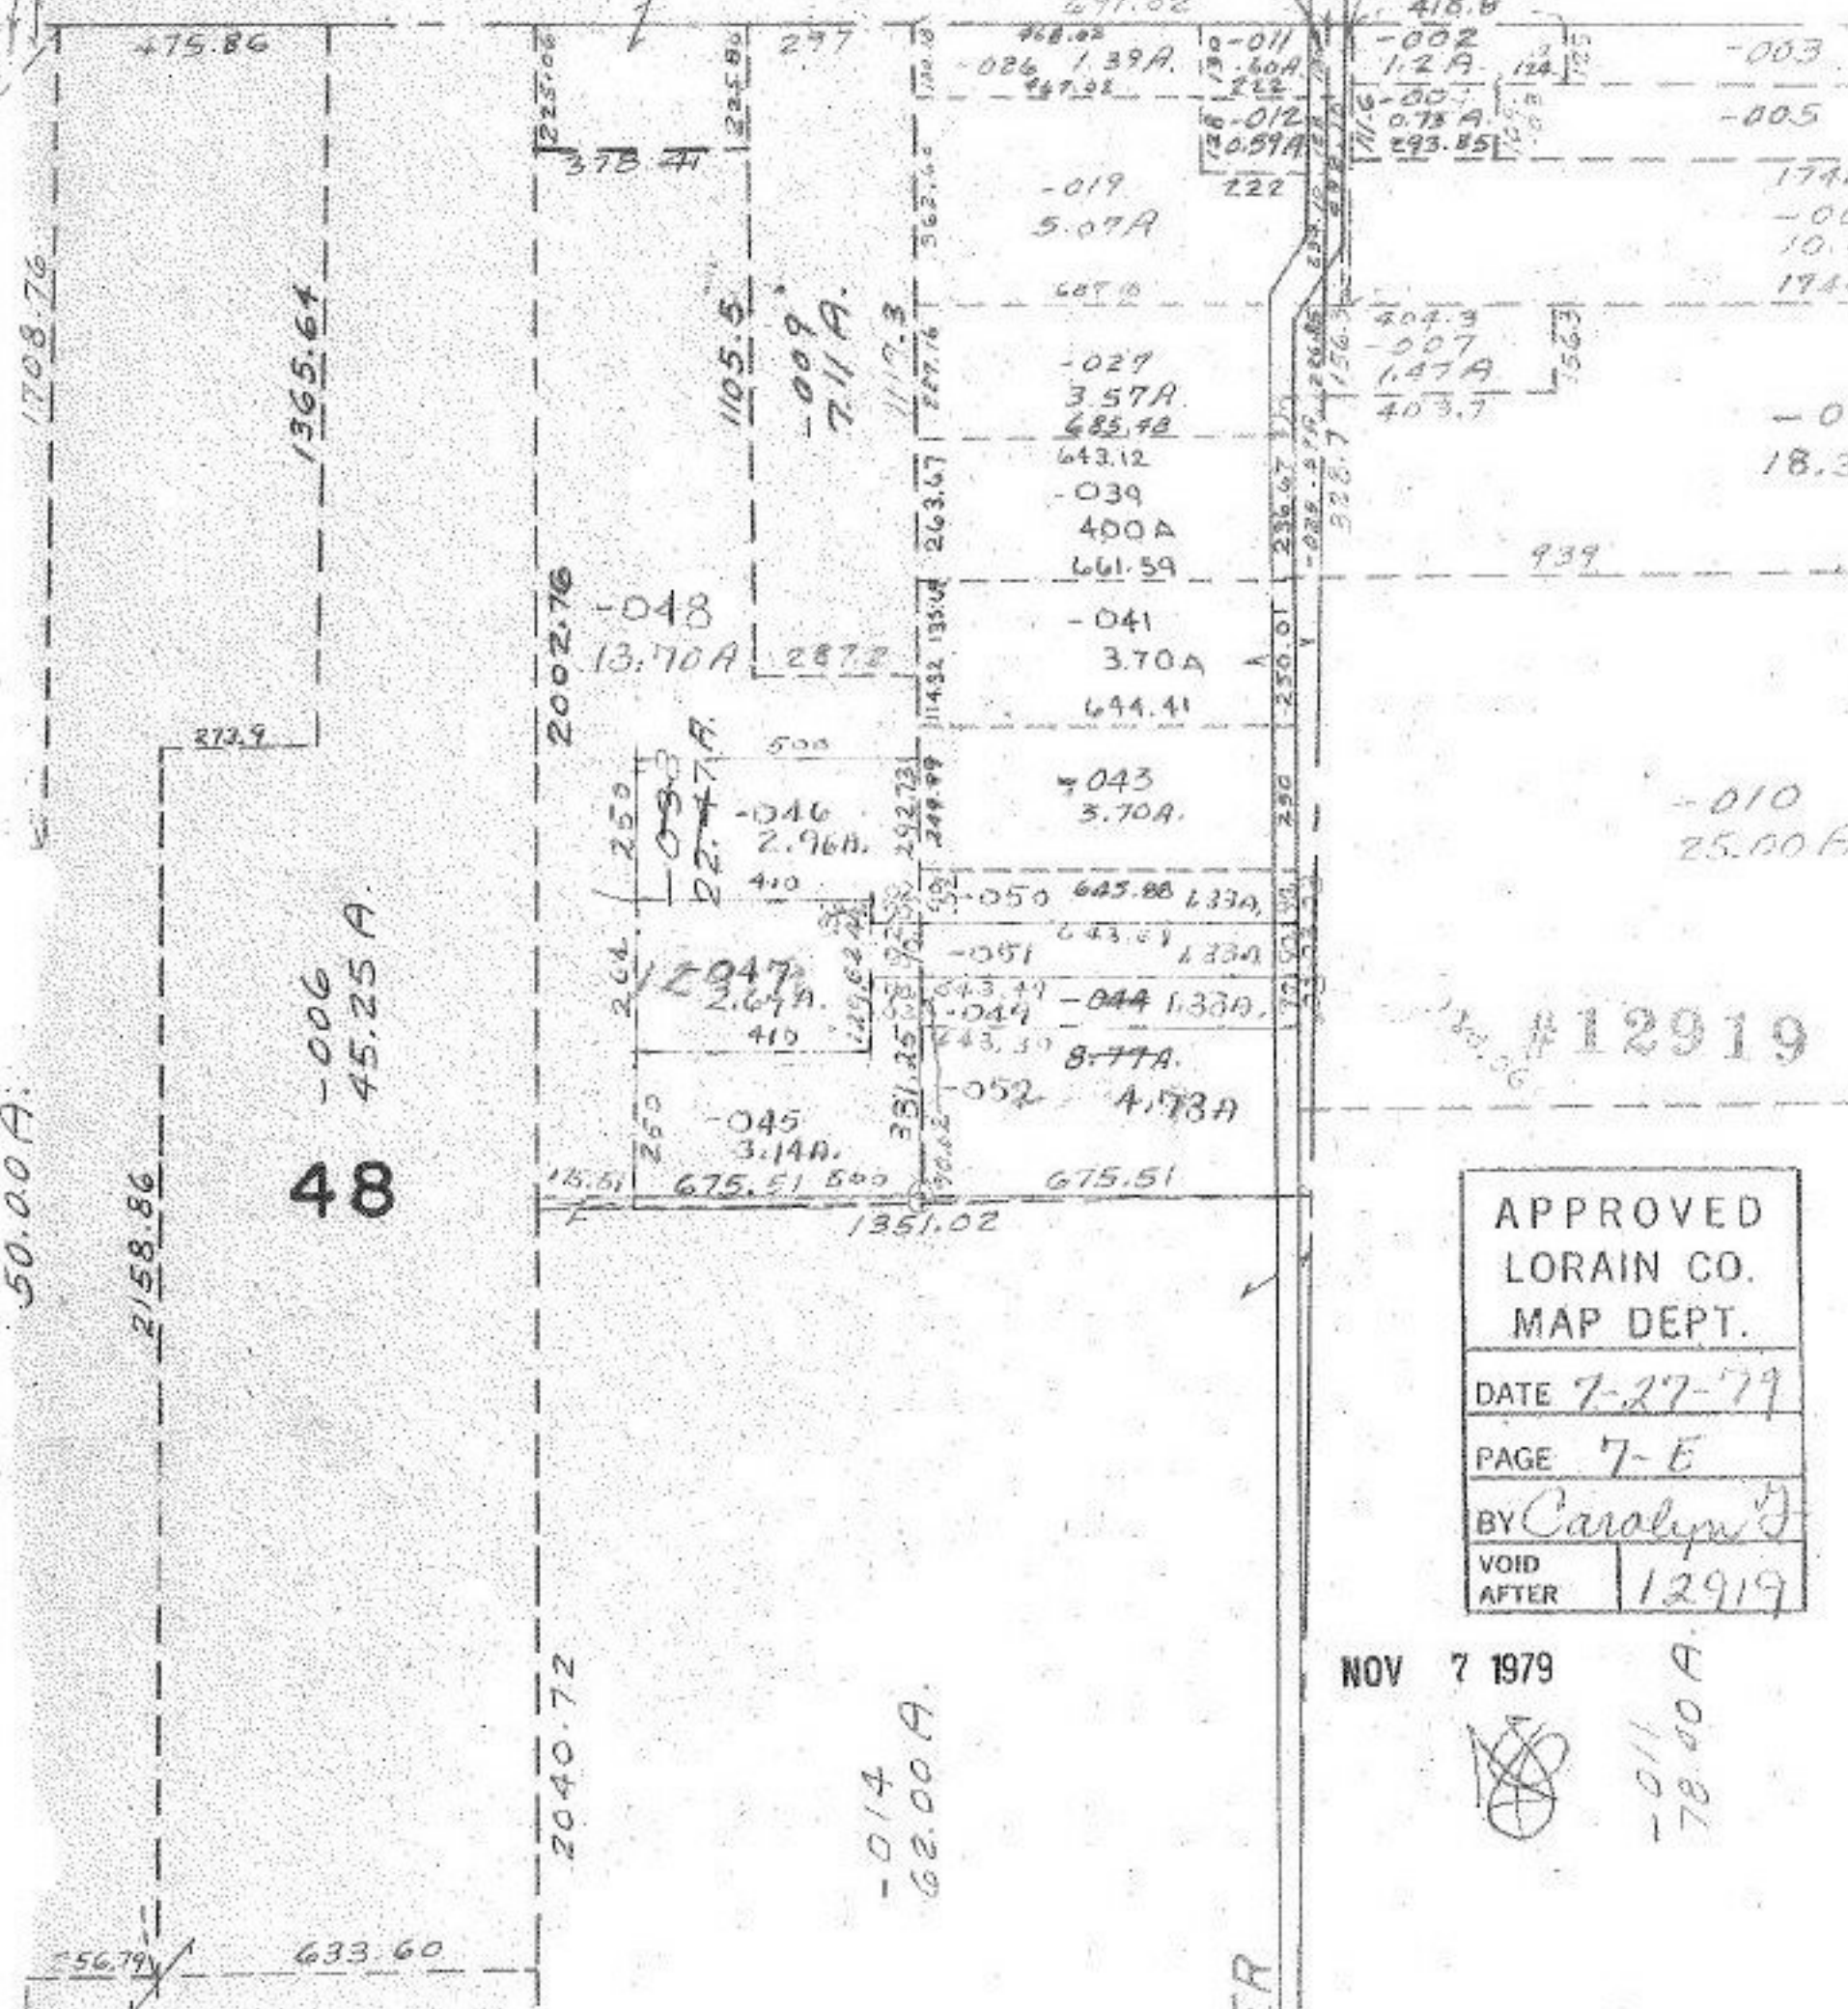

#12919

APPROVED	
LORAIN CO.	
MAP DEPT.	
DATE	7-27-79
PAGE	7-E
BY	Carolyn J
VOID AFTER	12919

NOV 7 1979



-011
78.00A