


MAPLE-ST

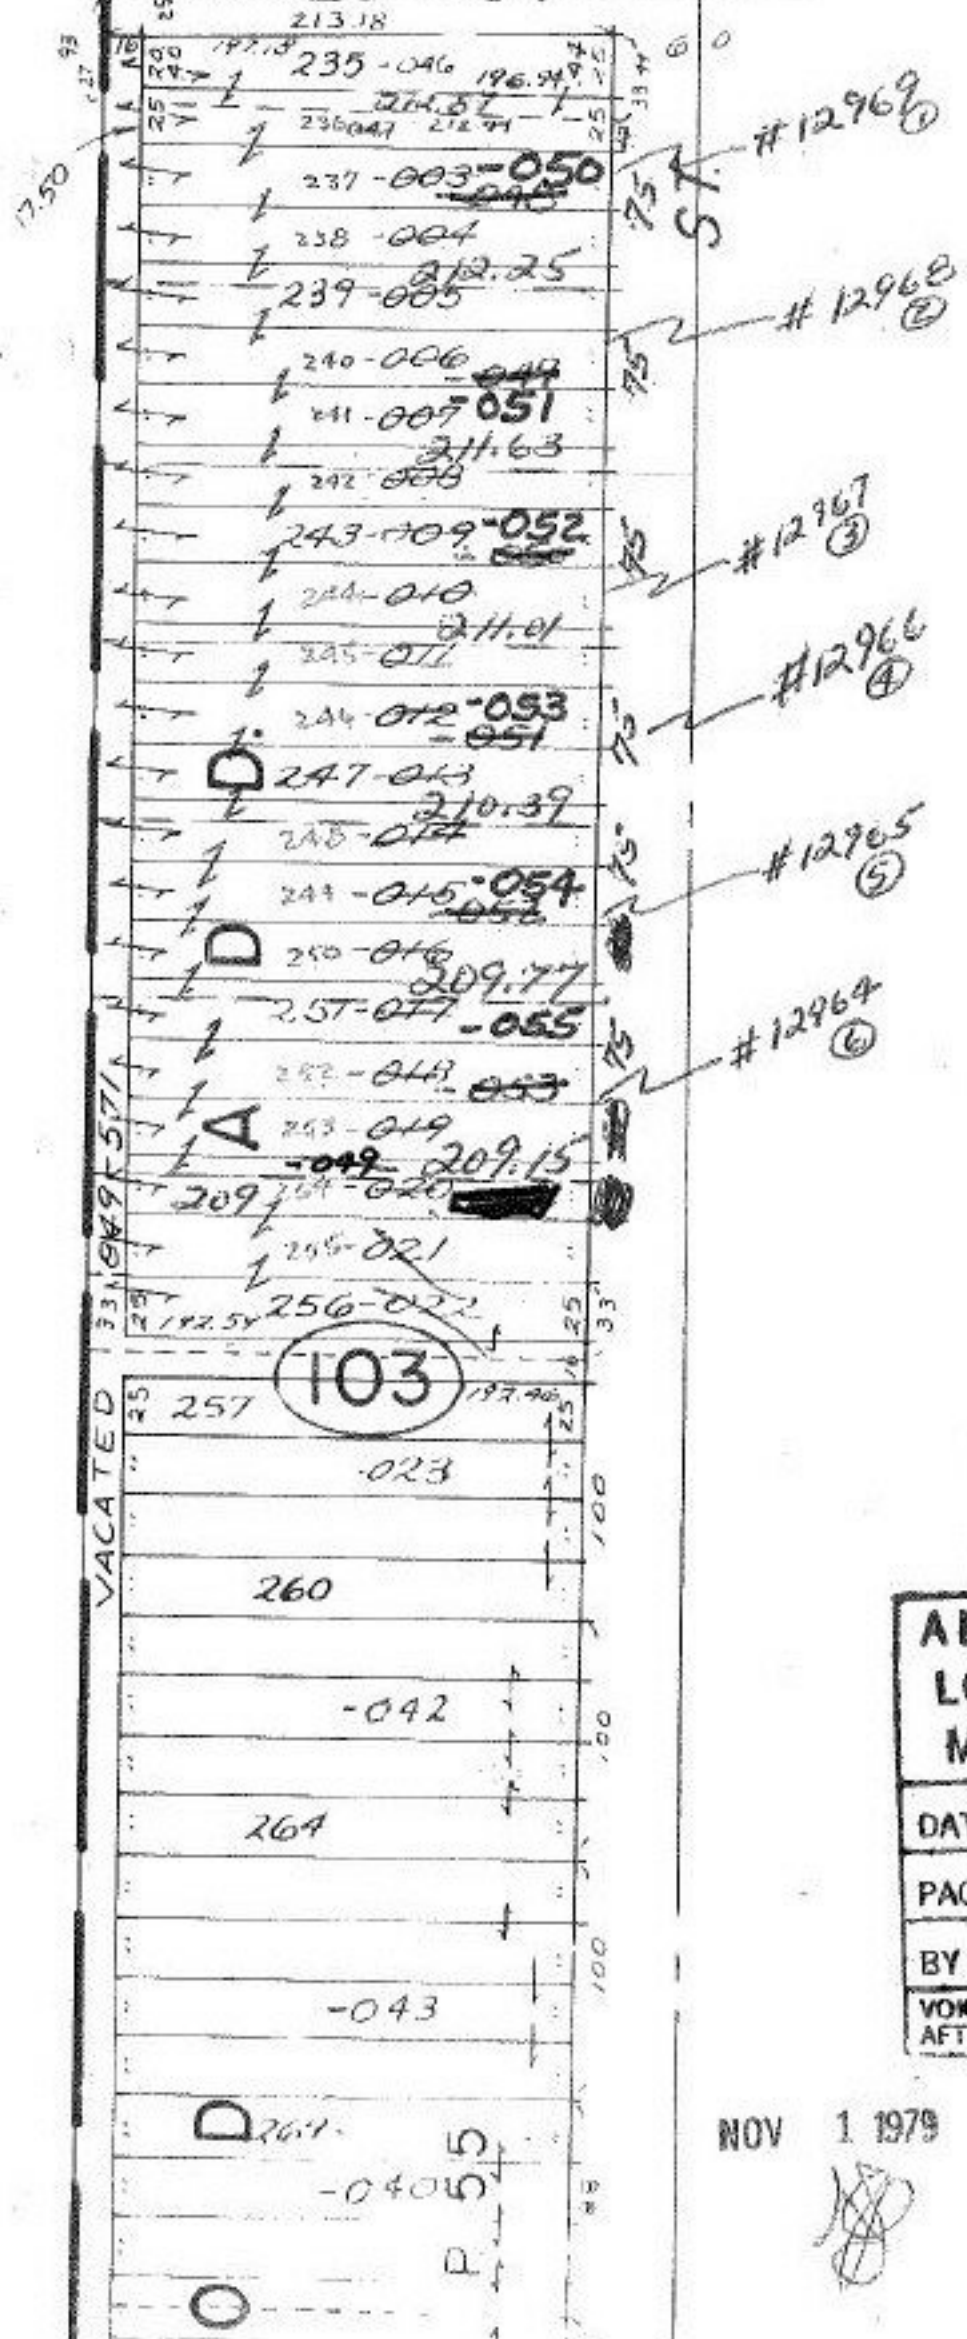

- #12964
- #12965
- #12966
- #12967
- #12968
- #12969

APPROVED.	
LORAIN CO.	
MAP DEPT.	
DATE	8-20-79
PAGE	9-00-074B
BY	<i>[Signature]</i>
VOID AFTER	

NOV 1 1979

