

#12979

APPROVED  
LORAIN CO.  
MAP DEPT.

DATE 8-13-79


PAGE 10-00-005-14

BY T.M. Nair

VOID  
AFTER

NOV 1 1979

SEE 10-00-00

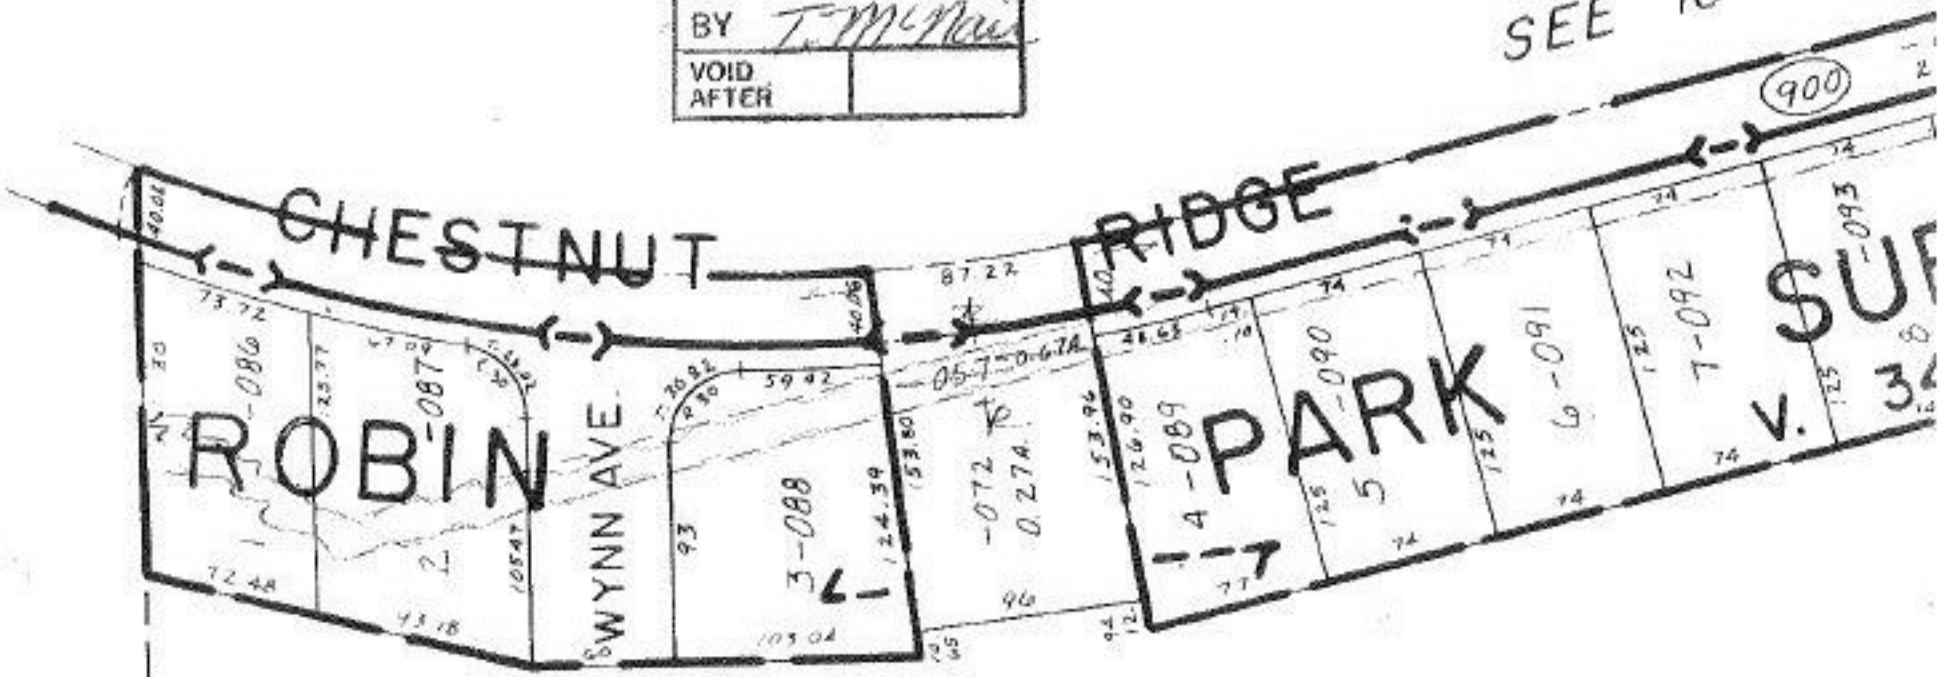

CORRECTION: DROP FROM

DUPLICATE 10-00-005-107-057

PER JOURNAL ENTRY 218/525

963.05

Pt  
Pt