


088
3.12 A

#12988

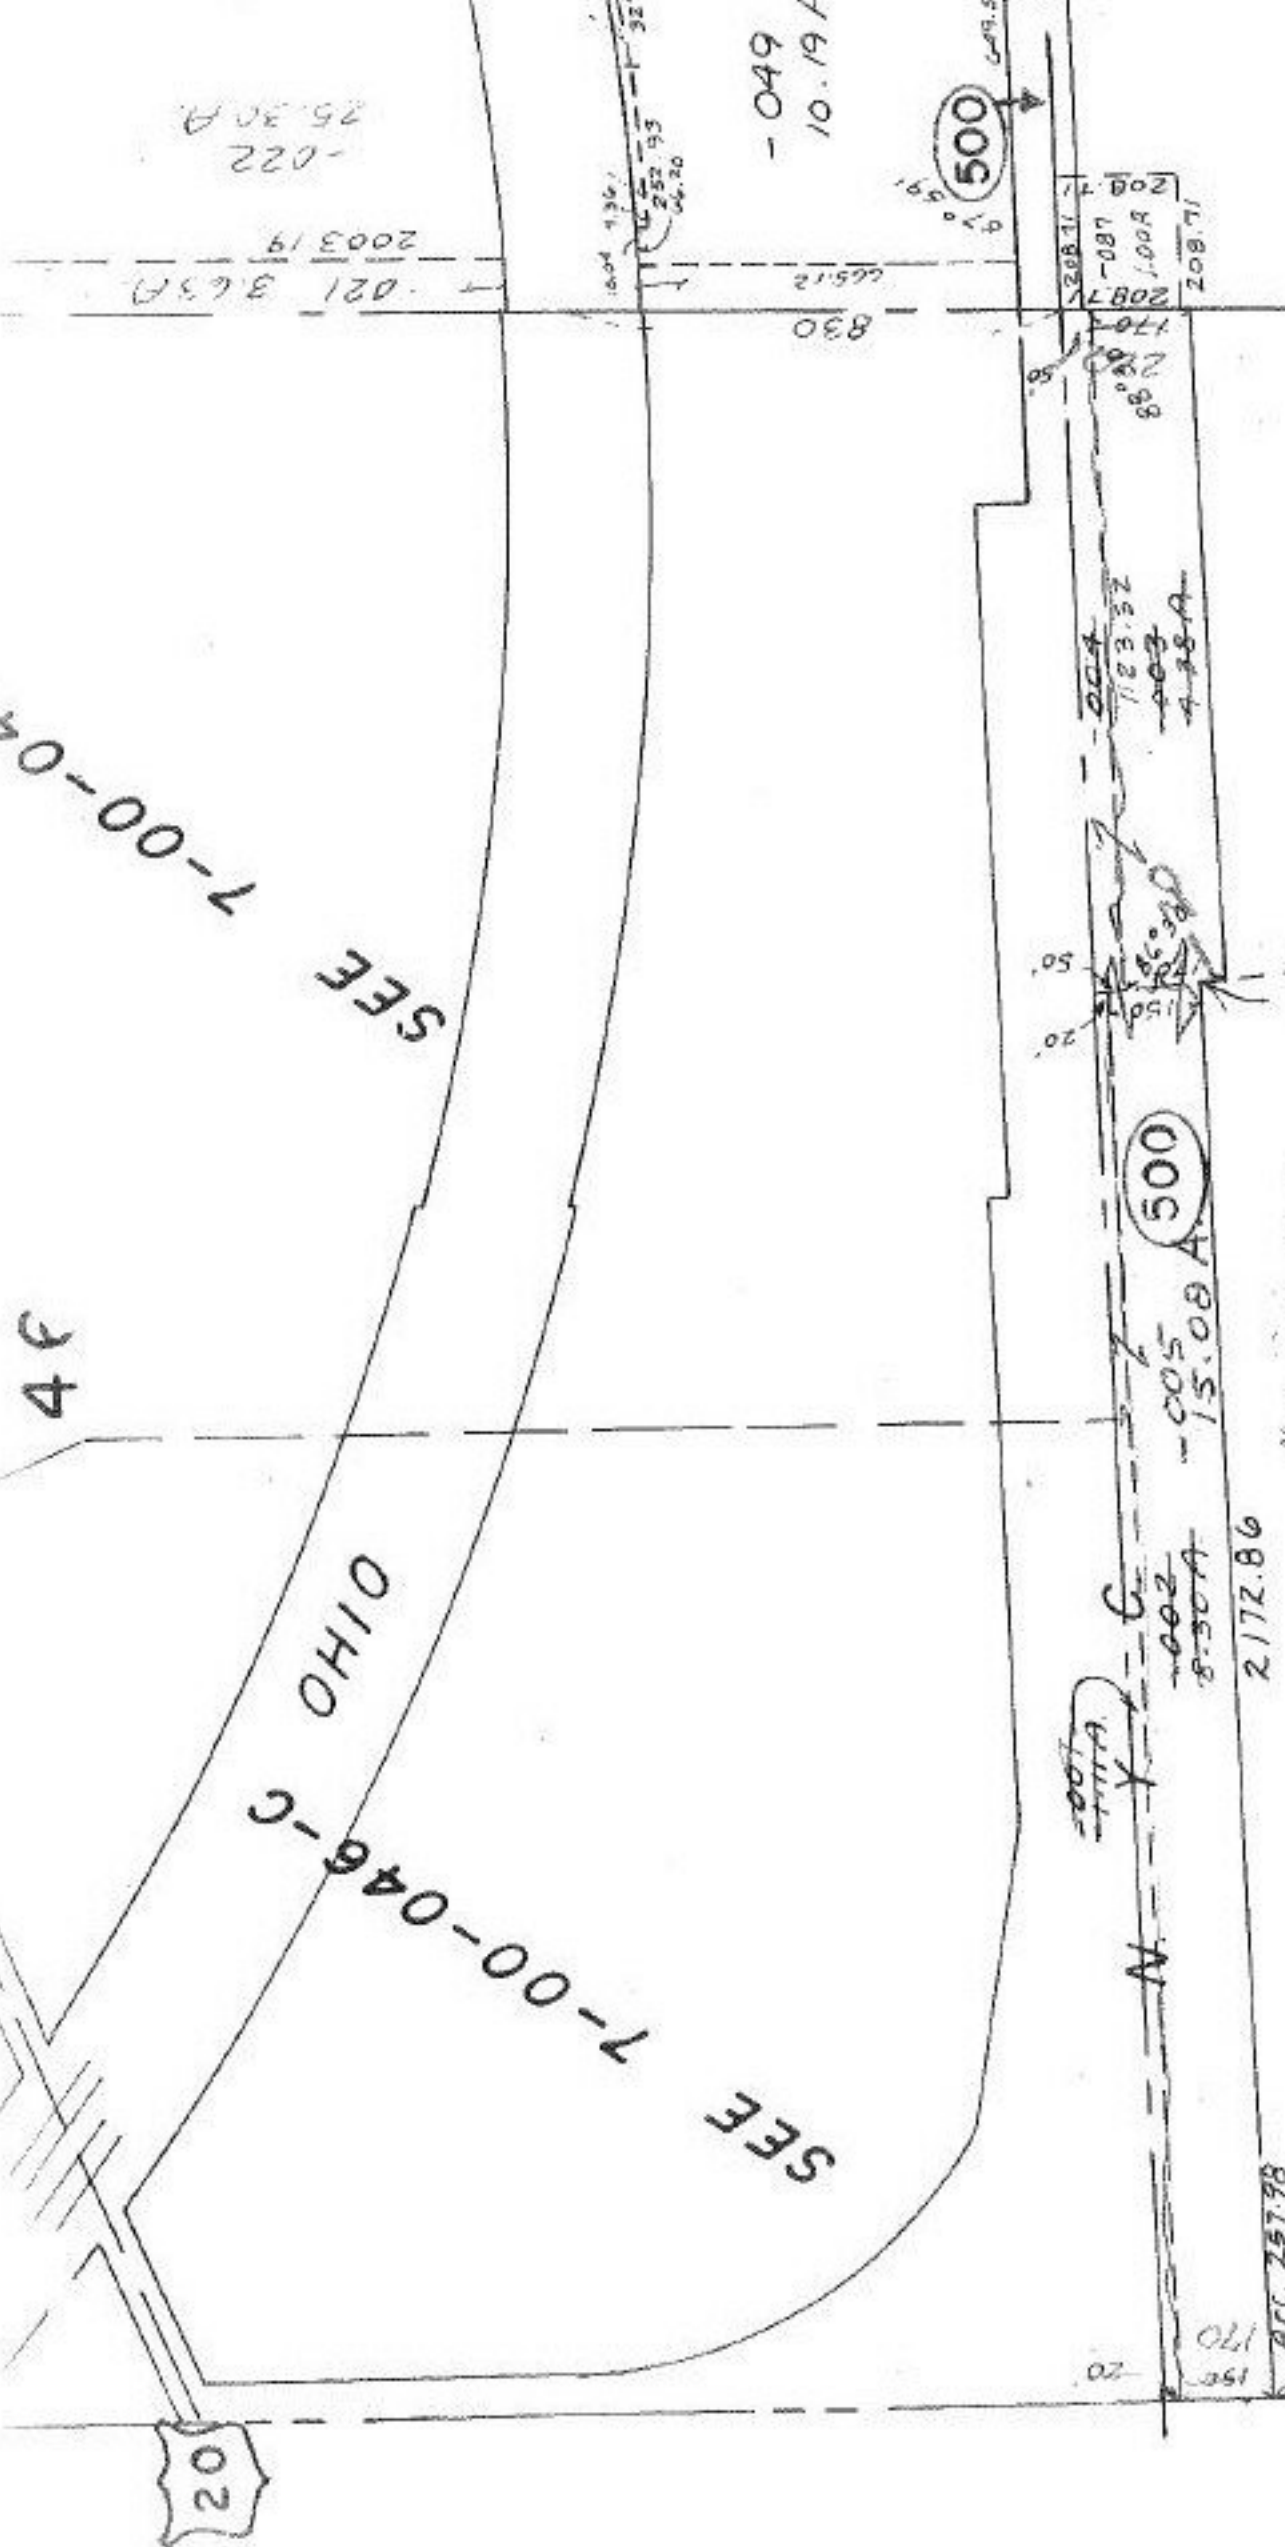

COMBINATION

#12988

APPROVED	
LORAIN CO.	
MAP DEPT.	
DATE 8-15-79	
PAGE 7-E	
BY T. McRAE	
VOID AFTER	

NOV 7 1979

1-11
8-30
4-38
1-29
15-08

-001
102.59 A

-002
41.27 A

SEE 7-00-046-C

SEE 7-00-046-C
OHIO

-049
10.19 A

-002
8-30 A
2.172.86

-005
15.08 A
500

-004
1123.32
-003
4-28 A

-087
1-00 A
500

-022
25.30 A
2003 19



1800.03

APR. 25 1978

170
150
20