
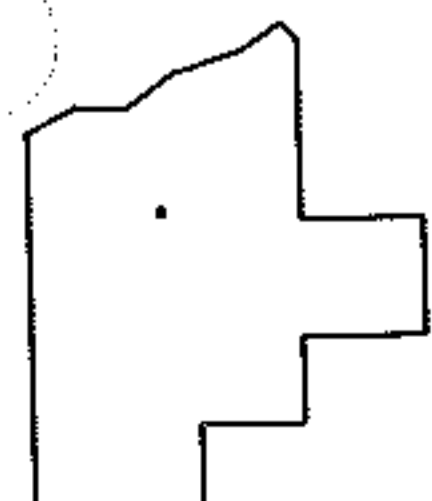
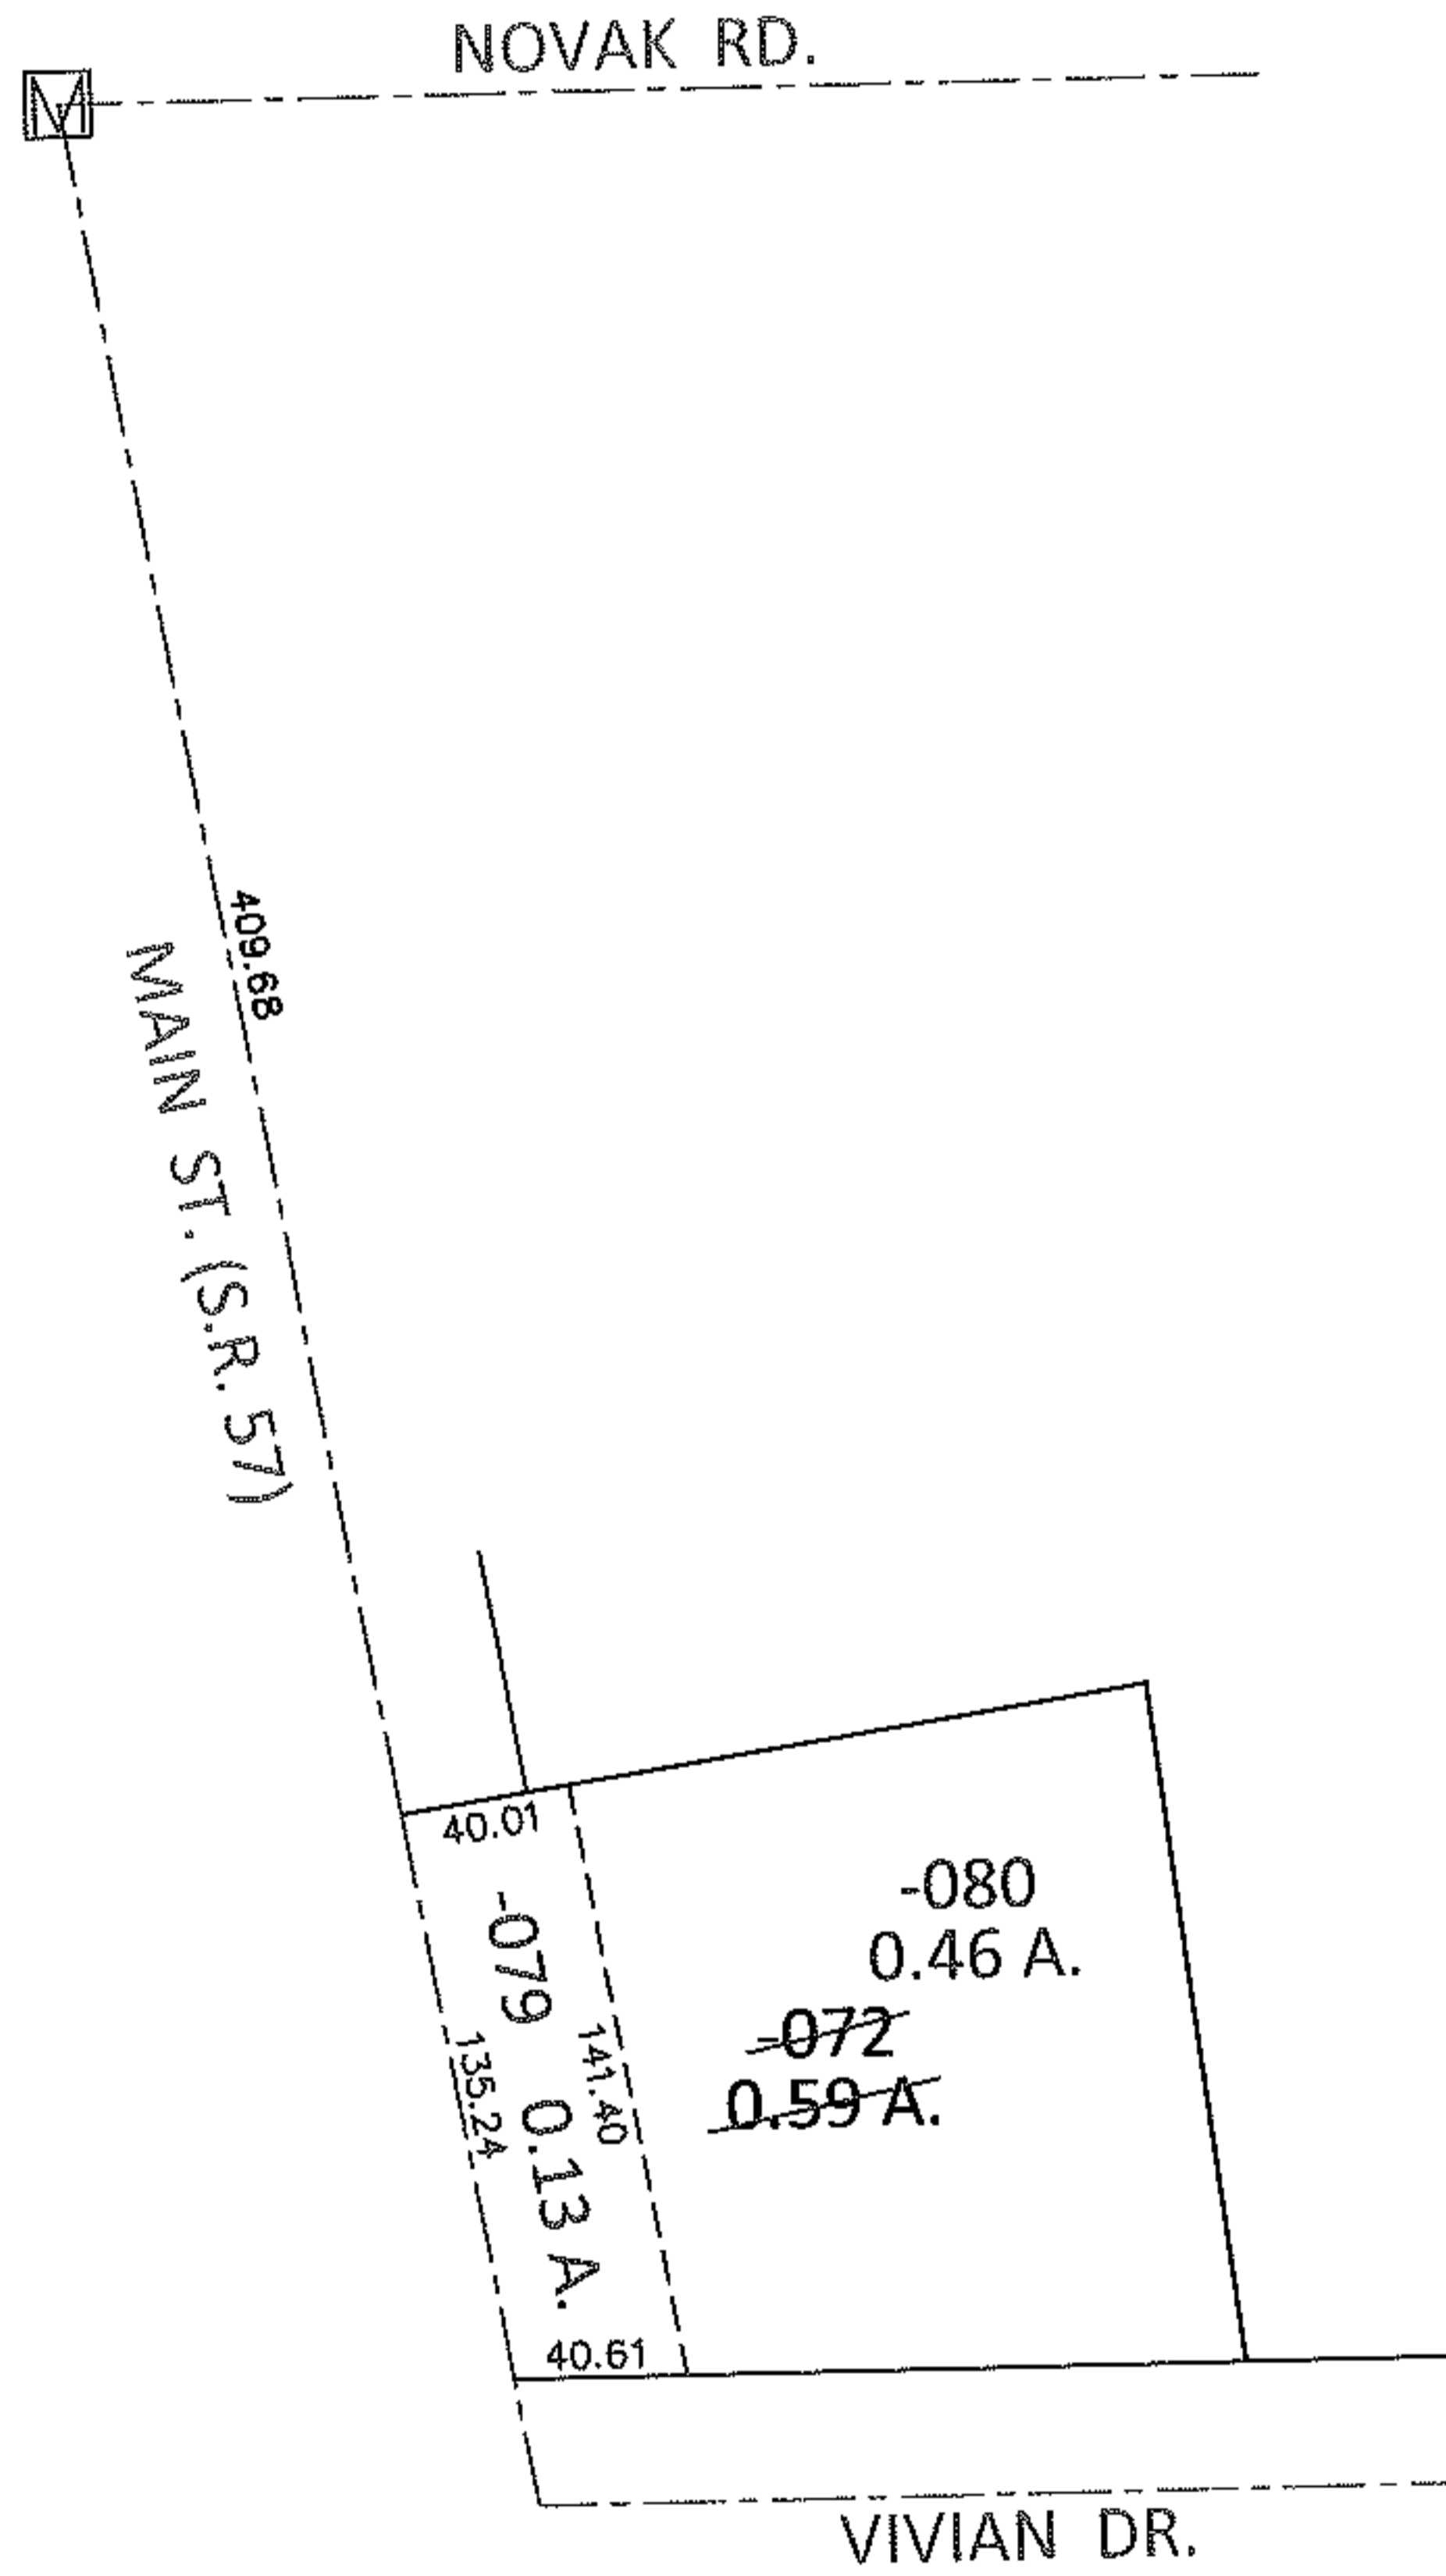


PARENT PARCEL: 11-00-100-102-072

CHILD PARCEL: 11-00-100-102-079, -080

STARTING POINT: AT A MON BOX AT THE INTERSECTION OF C/L OF NOVAK RD. AND C/L OF S.R.57

13-00359

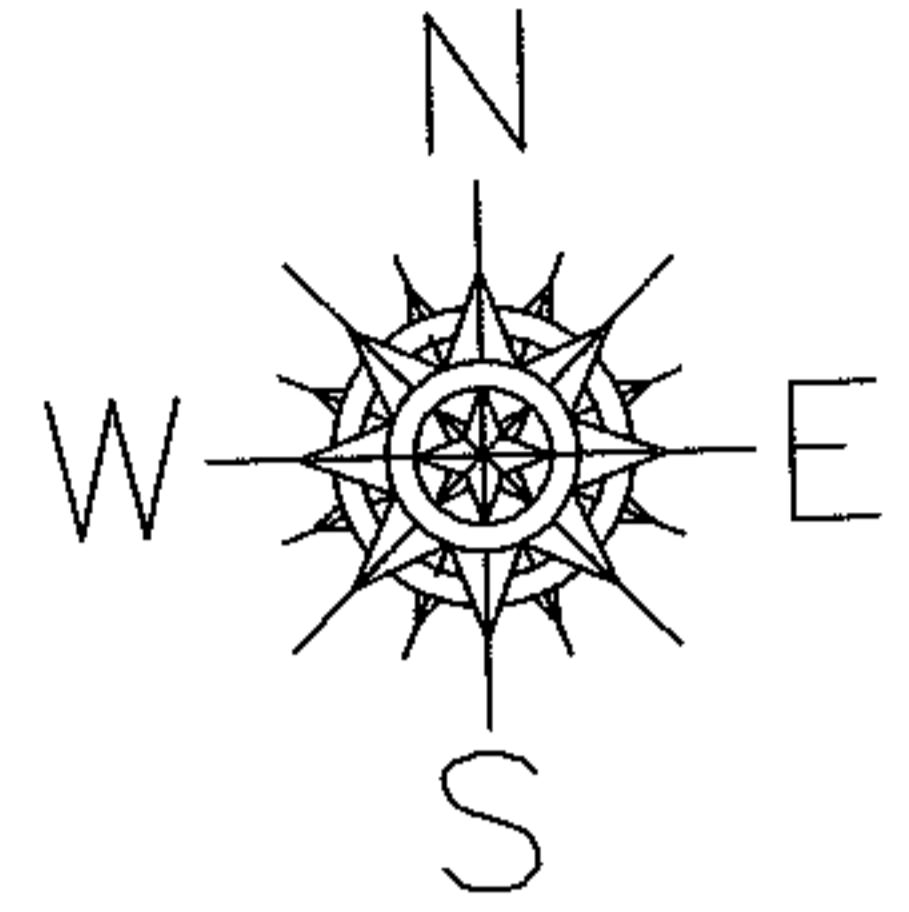

SPLITS/DEEDS PROCESSED

LORAIN COUNTY TAX MAP DEPARTMENT
226 MIDDLE AVE. ELYRIA, OHIO

SURVEYED BY: KENNETH C. DEAN JR.

CLOSURE: .01:10,000

MAP PAGE(S): 11-00-100-B

APPROVED BY: RRM DATE: 1-2-13

SCALE: 1"= 100 PRIOR INST.: OR 466/598