
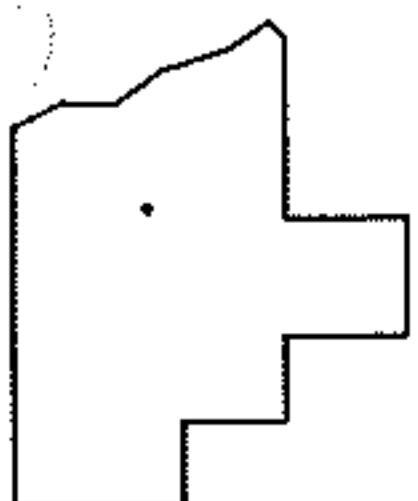
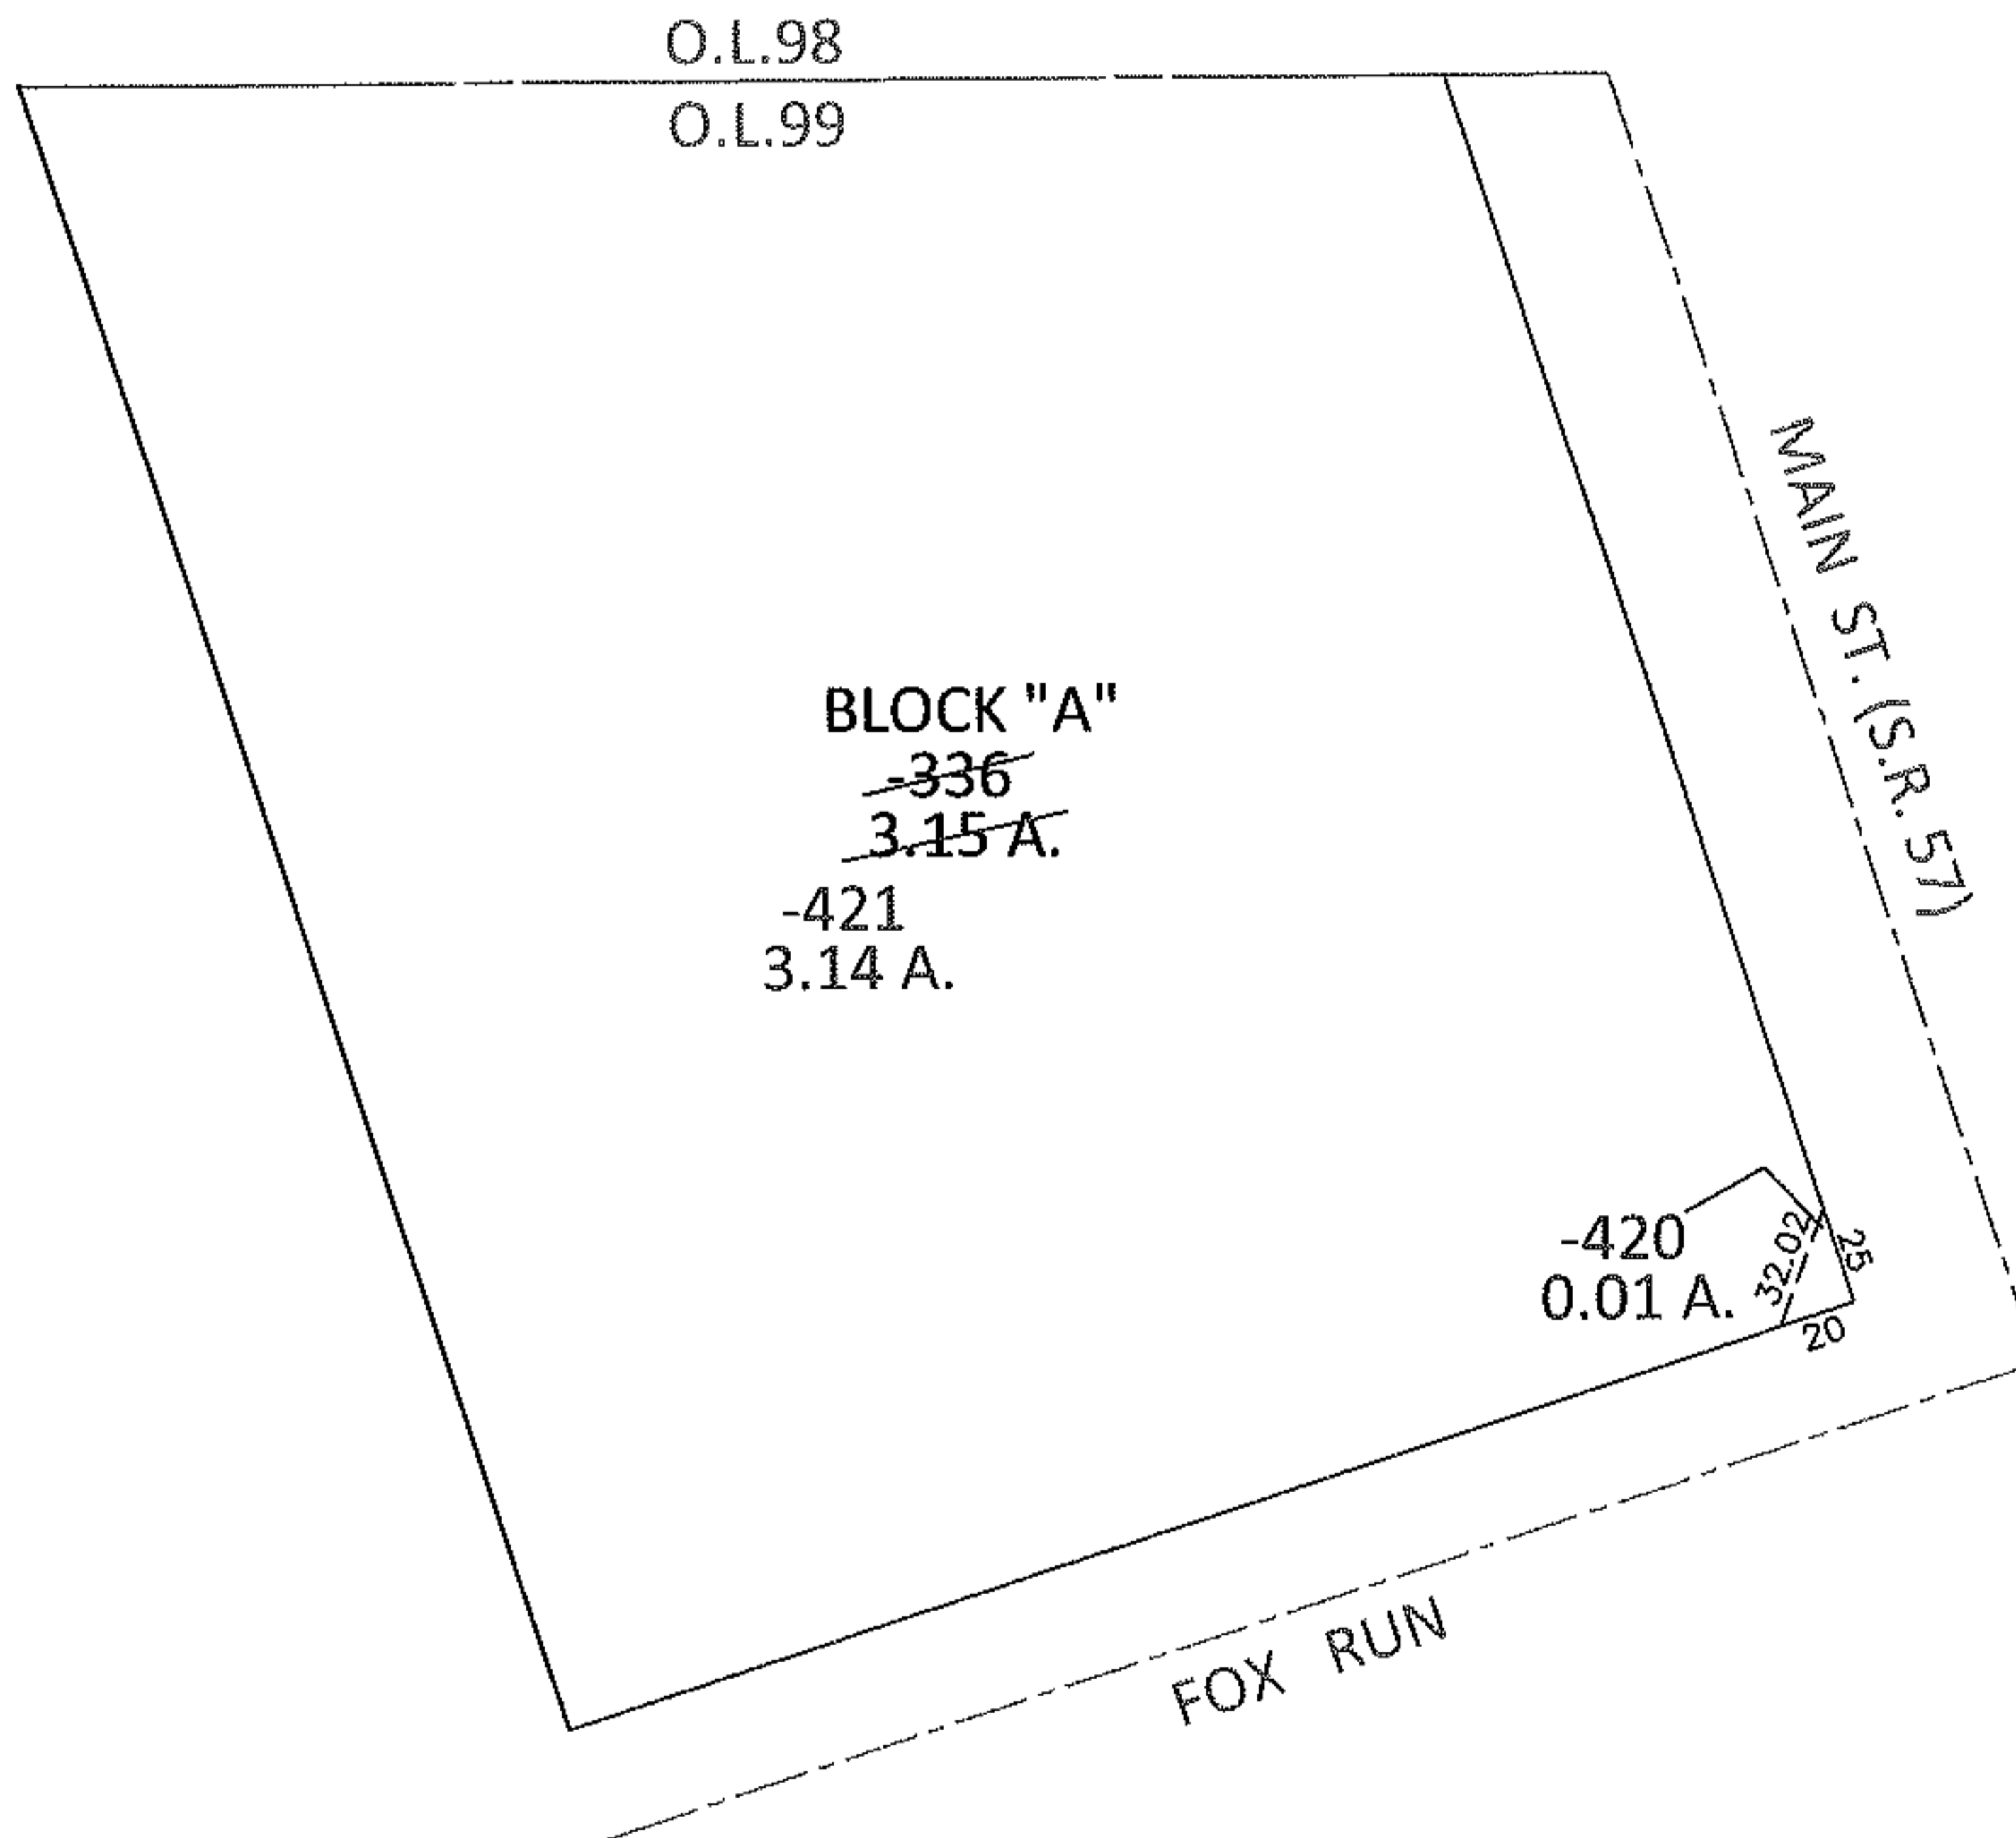


PARENT PARCEL: 11-00-099-000-336

CHILD PARCEL: 11-00-099-000-420, -421

STARTING POINT: SOUTHEAST CORNER OF BLOCK A IN FOX RUN SUB.(VOL.73 PG.19)

13-00363

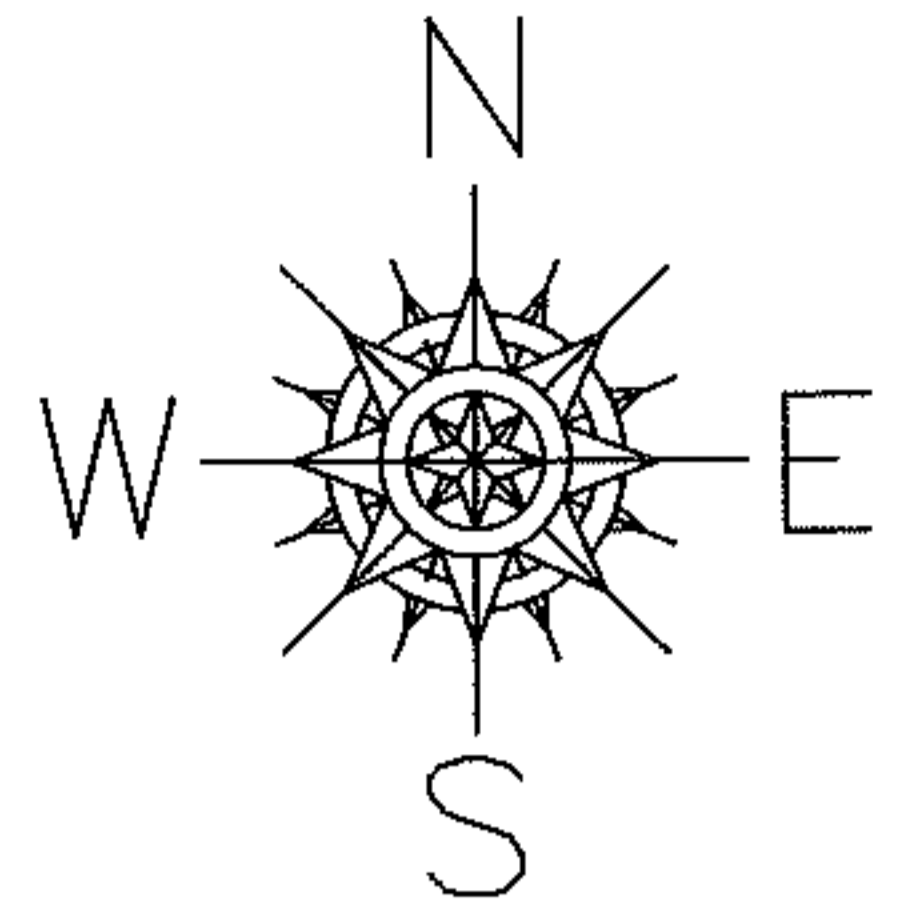

SPLITS/DEEDS PROCESSED

LORAIN COUNTY TAX MAP DEPARTMENT
226 MIDDLE AVE. ELYRIA, OHIO

SURVEYED BY: KENNETH C. DEAN JR.

CLOSURE: .00:10,000

MAP PAGE(S): 11-E NORTH

APPROVED BY: RRM DATE: 1-2-13

SCALE: 1"= 100 PRIOR INST.: 20020811890