
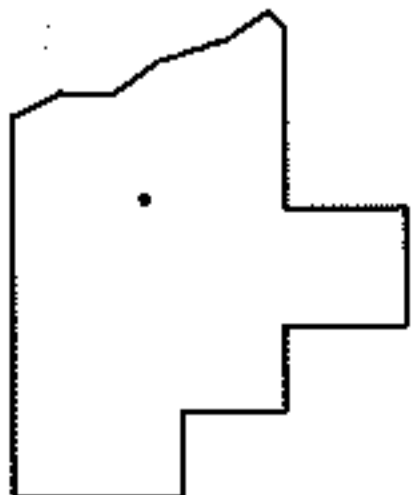
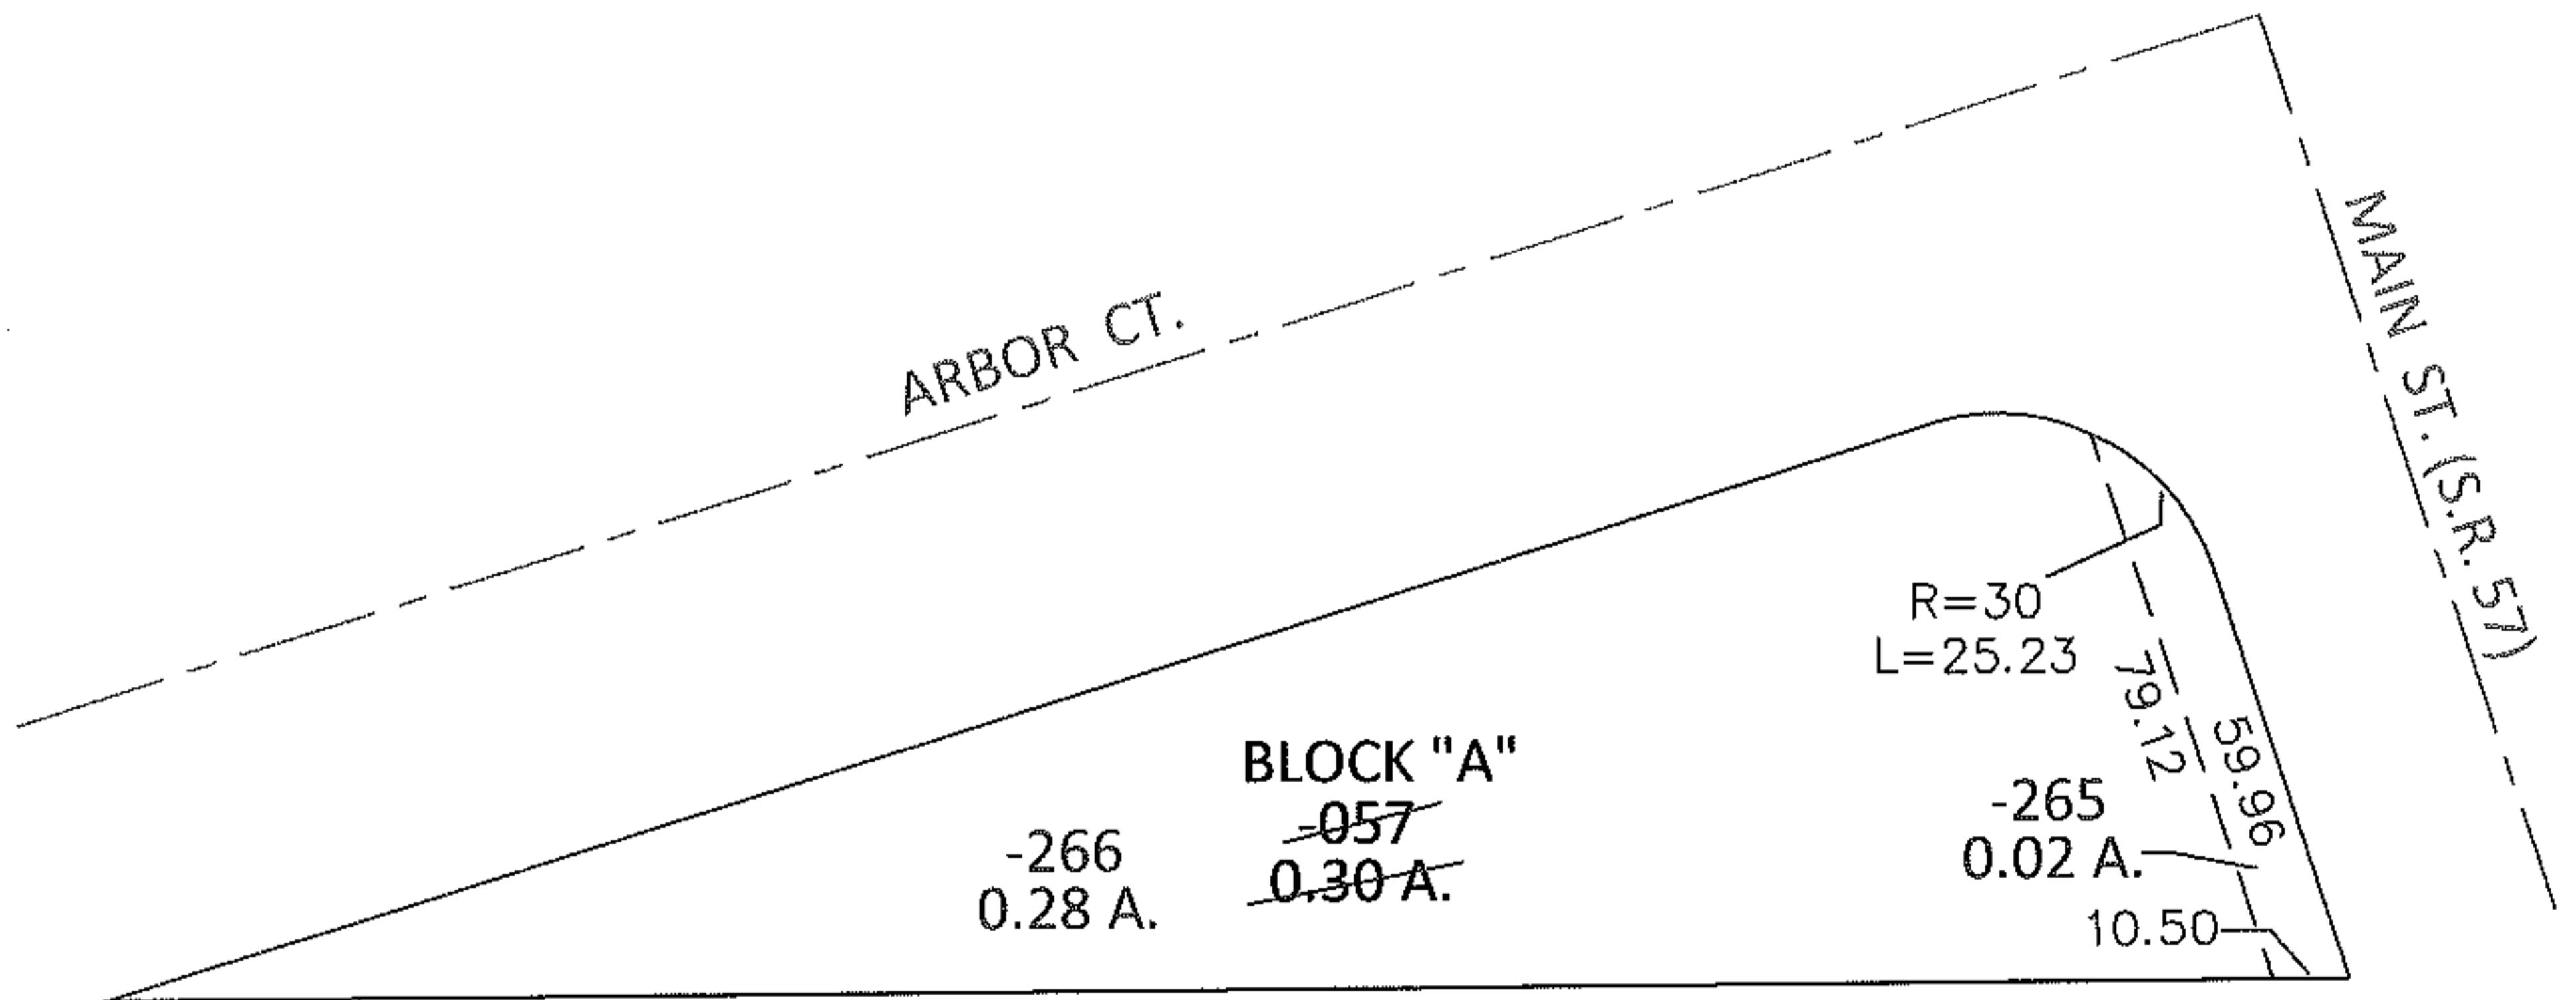


PARENT PARCEL: 11-00-098-000-057

CHILD PARCEL: 11-00-098-000-265, -266

13-00364

STARTING POINT: SOUTHEAST CORNER OF BLOCK A IN TANGLEWOOD SUB.(VOL.51 PG.36)

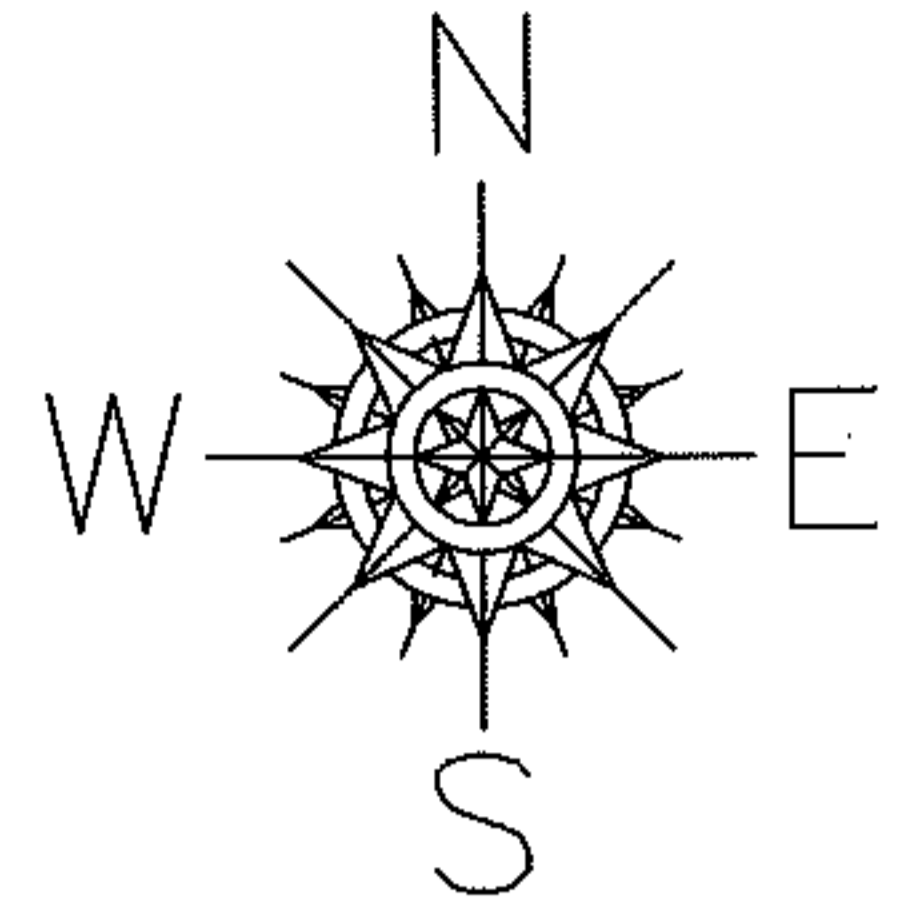

**SPLITS/DEEDS PROCESSED**

LORAIN COUNTY TAX MAP DEPARTMENT  
226 MIDDLE AVE. ELYRIA, OHIO

SURVEYED BY: KENNETH C. DEAN JR.

CLOSURE: .01:10,000

MAP PAGE(S): 11-00-098-A

APPROVED BY: RRM DATE: 1-3-12

SCALE: 1"= 50' PRIOR INST.: OR 289/517