
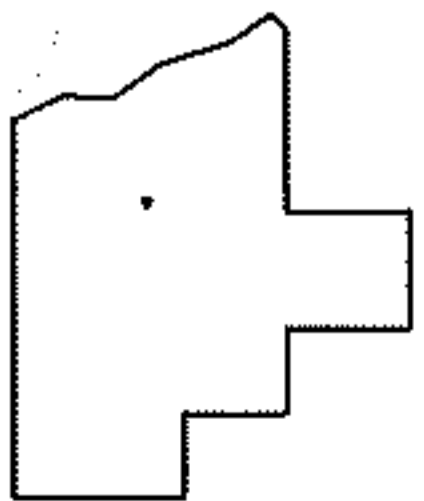
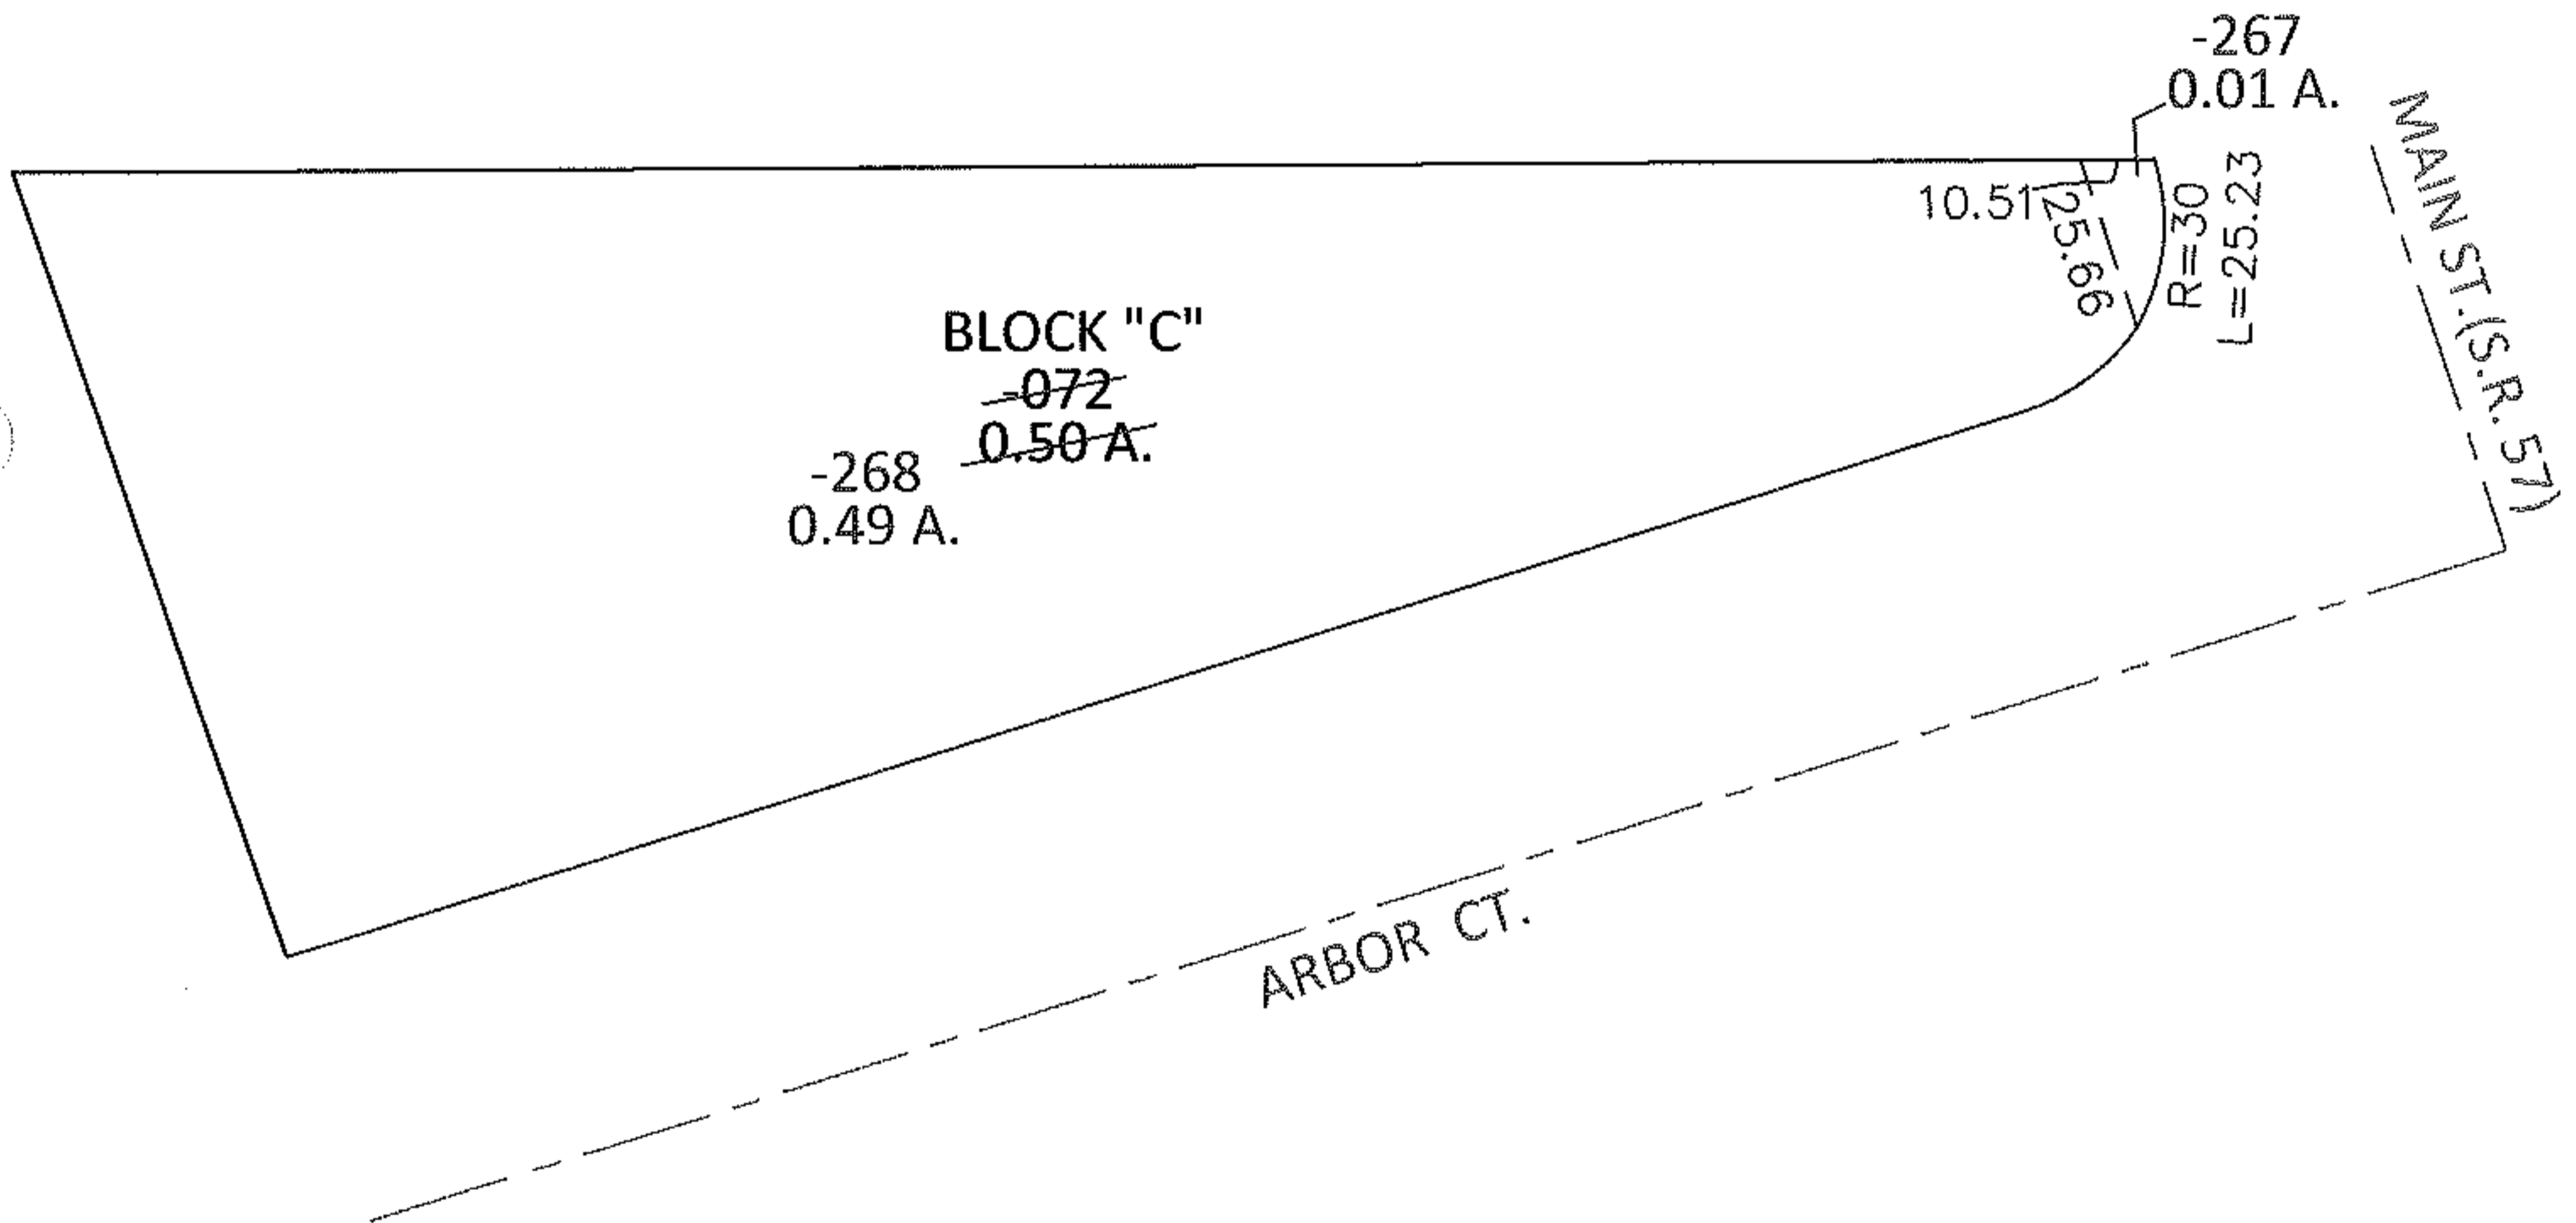


PARENT PARCEL: 11-00-098-000-072

CHILD PARCEL: 11-00-098-000-267, -268

13-00365

ARTING POINT: NORTHEAST CORNER OF BLOCK C IN TANGLEWOOD SUB. NO.2(VOL.61 PG.12)

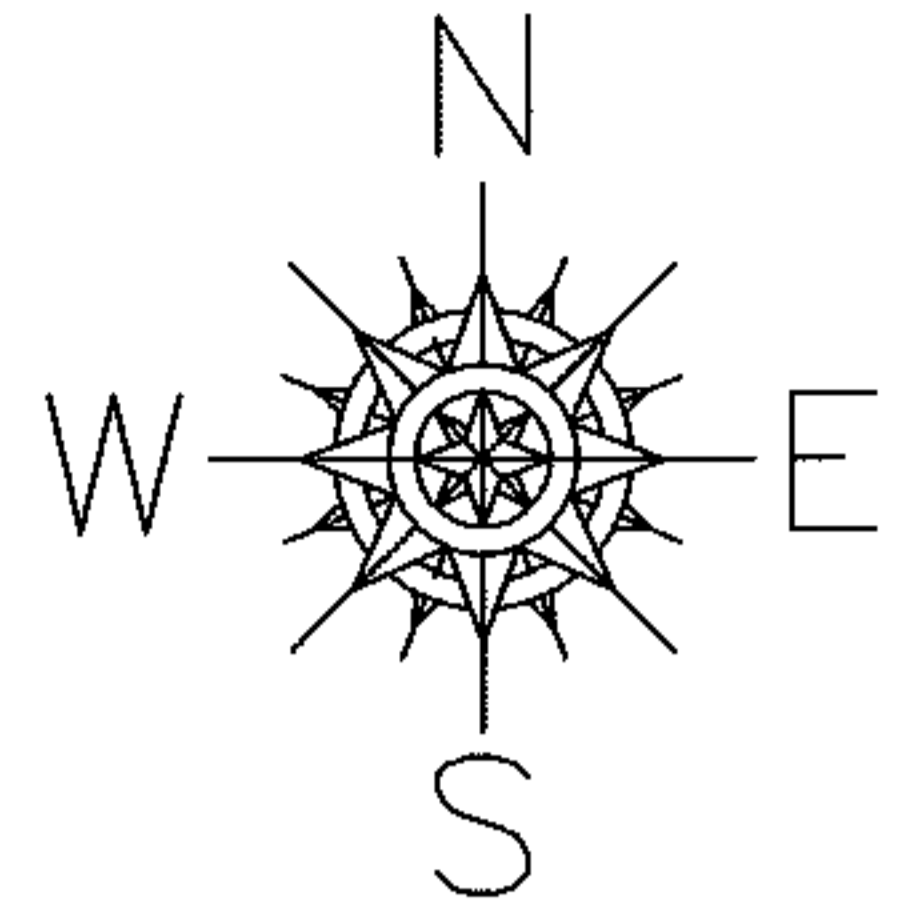

**SPLITS/DEEDS PROCESSED**

LORAIN COUNTY TAX MAP DEPARTMENT  
226 MIDDLE AVE. ELYRIA, OHIO

SURVEYED BY: KENNETH C. DEAN JR.

CLOSURE: .00:10,000

MAP PAGE(S): 11-00-098-A

APPROVED BY: RRM DATE: 1-3-13

SCALE: 1" = 50' PRIOR INST.: OR 289/517