

PARENT PARCEL: 04-00-021-000-067

CHILD PARCEL: XX-XX-XXX-XXX-XXX

STARTING POINT: MON. BOX, CL. OF NAGEL RD. & S.E. CORNER OF SECTION 21

13-00368

ACREAGE CORRECTION - STRAIGHT TRANSFER

04-00-021-000-067

~~1.96~~ A.

2.03 A.




CORR. PER SURV.

WILLIAM J. SALA

R.O.W. TAKE 17-WLV

HIGHWAY PLANS

LOR-90-22.26 AVON

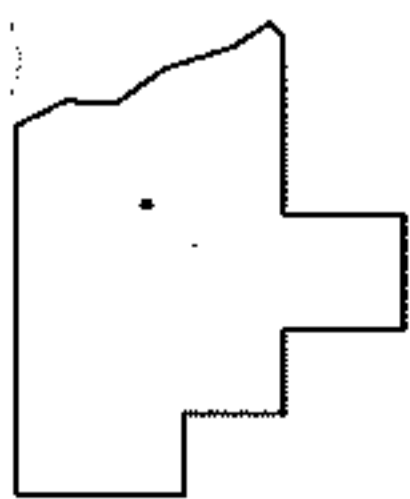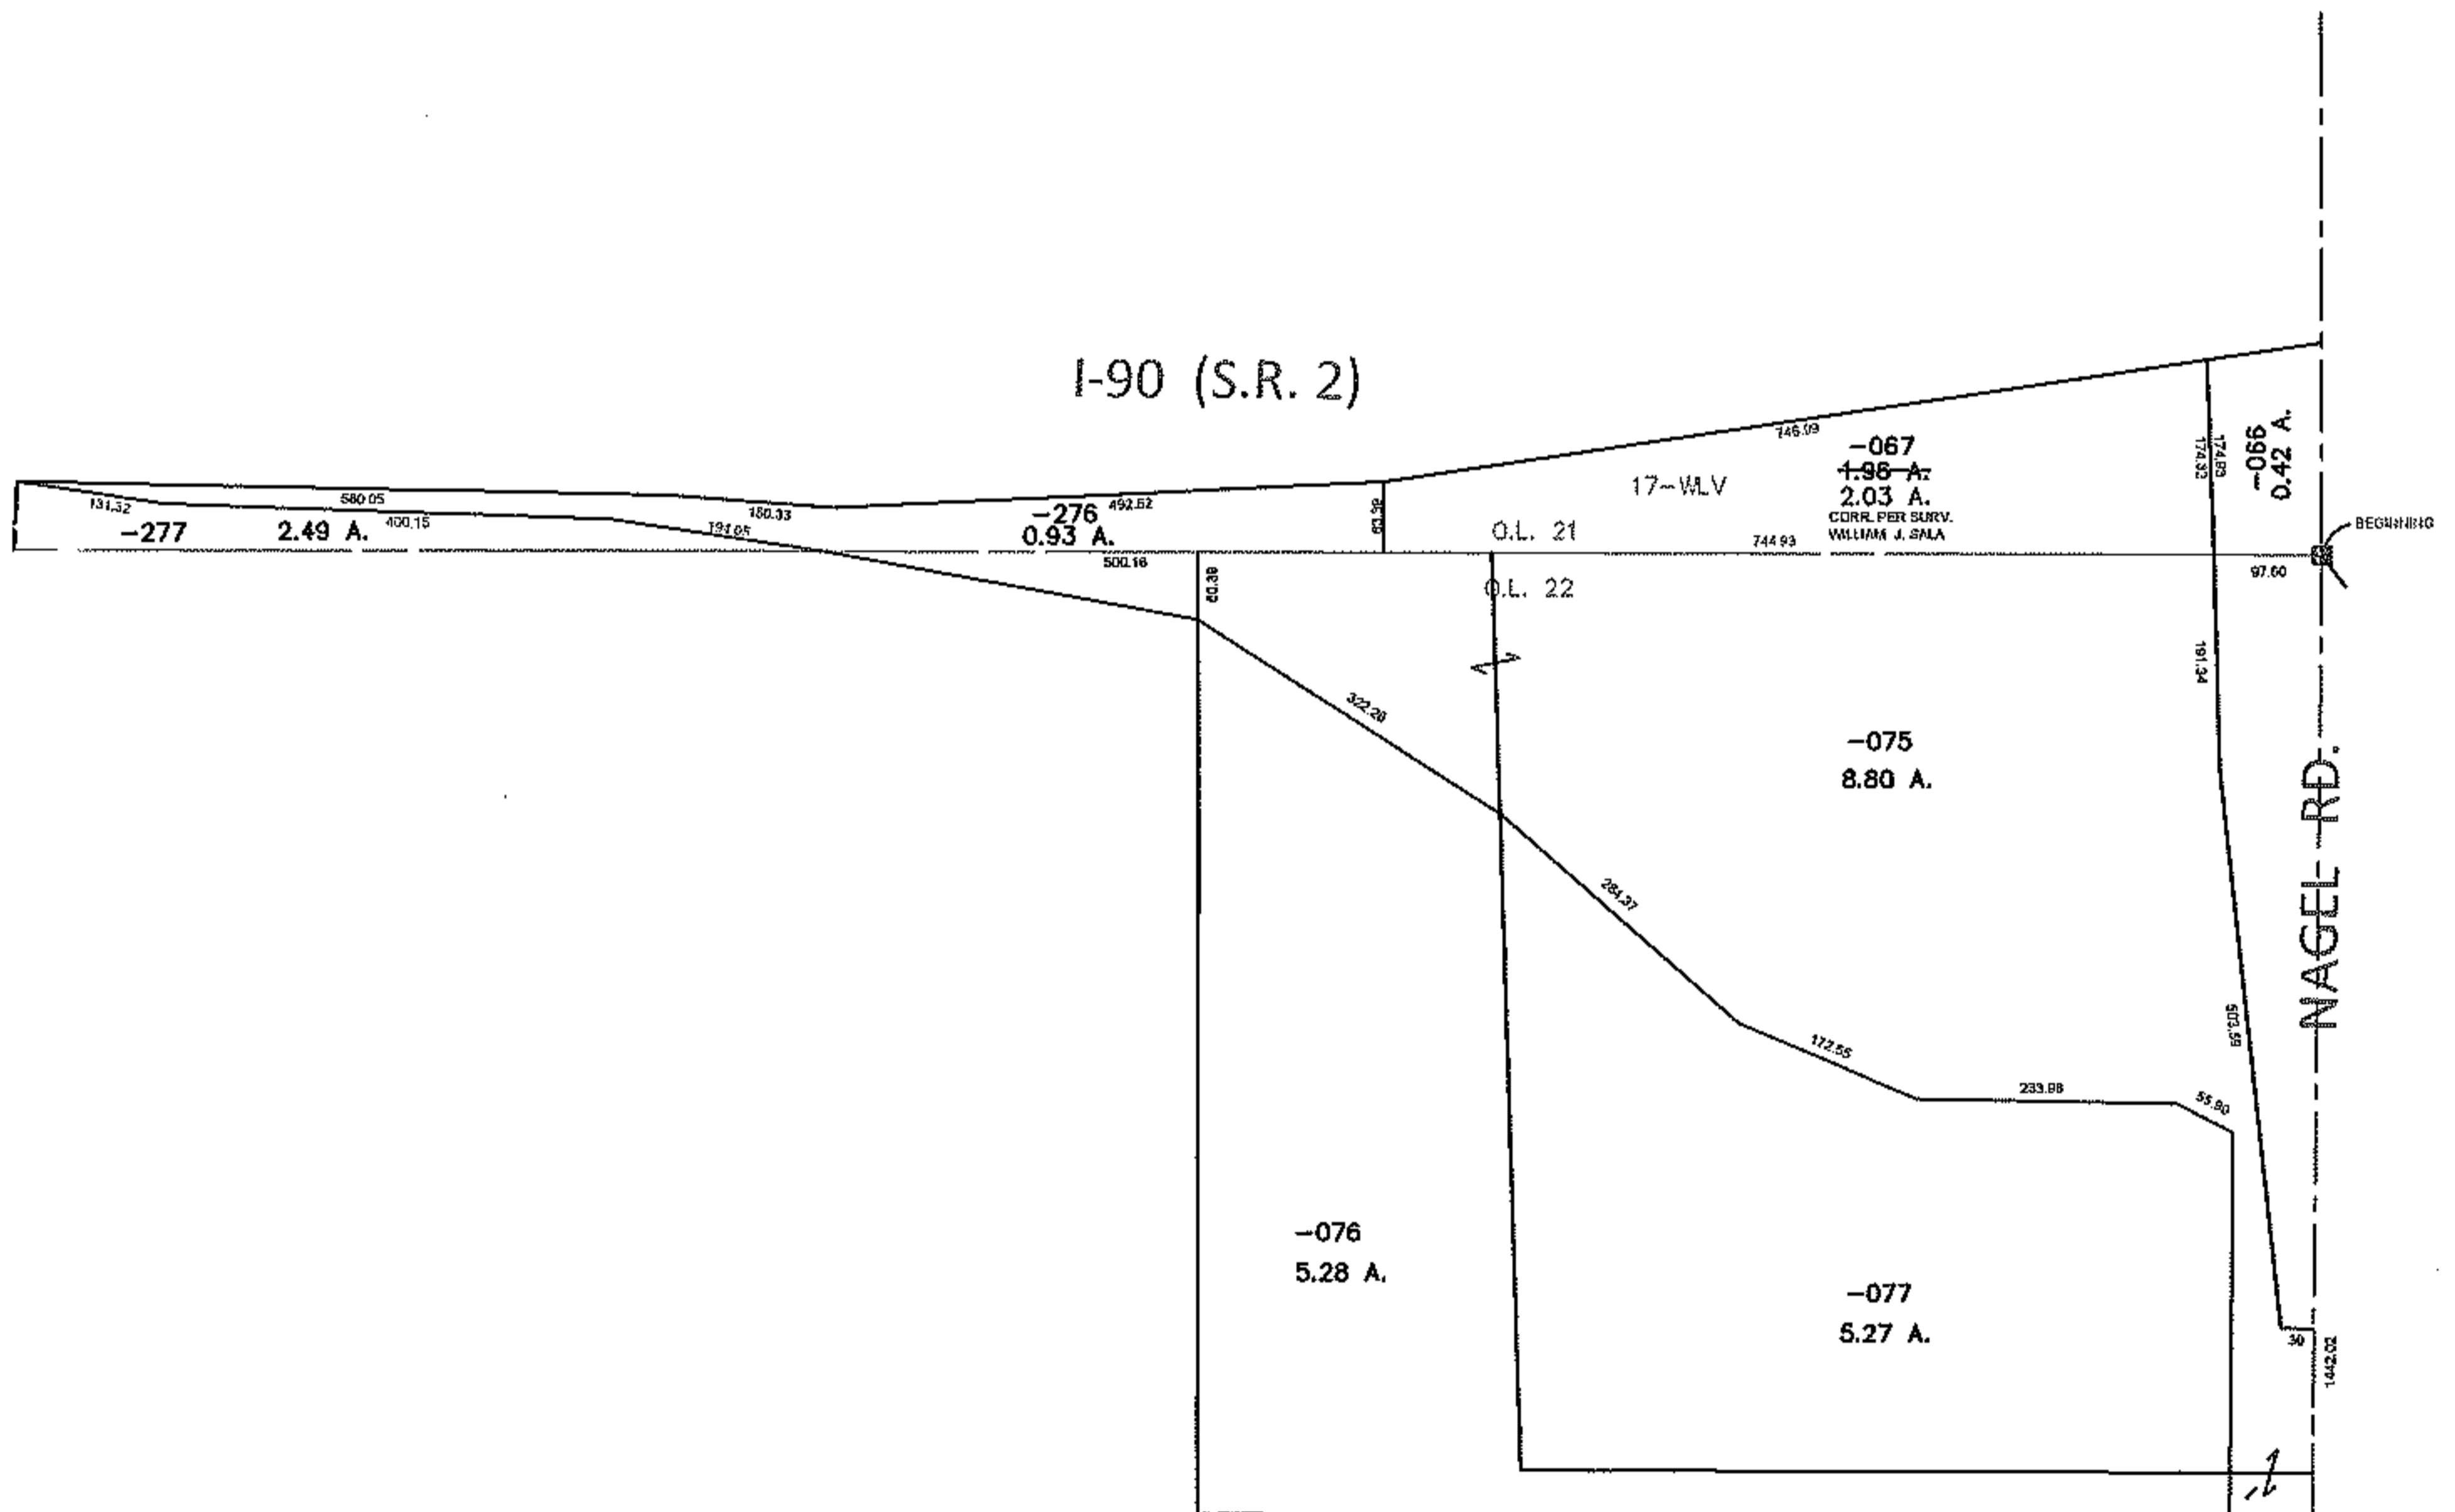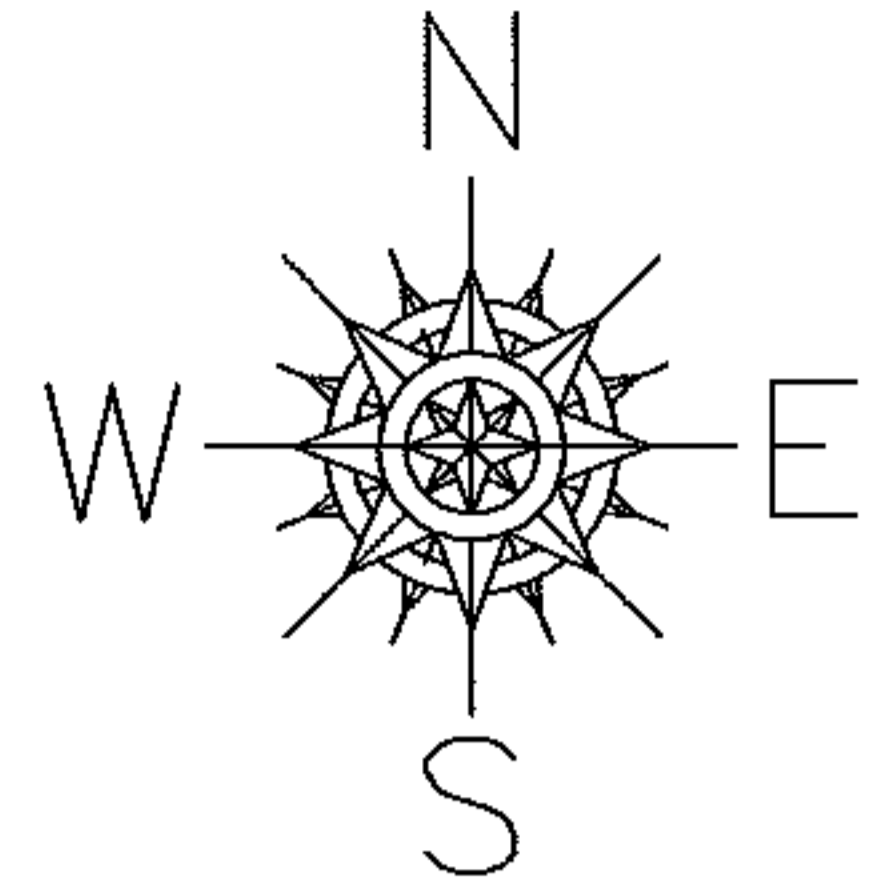

SPLITS/DEEDS PROCESSED
LORAIN COUNTY TAX MAP DEPARTMENT
226 MIDDLE AVE. ELYRIA, OHIO

SURVEYED BY: WILLIAM J. SALA
CLOSURE: 0.01 : 10,000
MAP PAGE(S): 4-00-021-H
APPROVED BY: TJS DATE: 1/4/13
SCALE: 1" = 300 PRIOR INSTRUMENT: DV 1420/219