
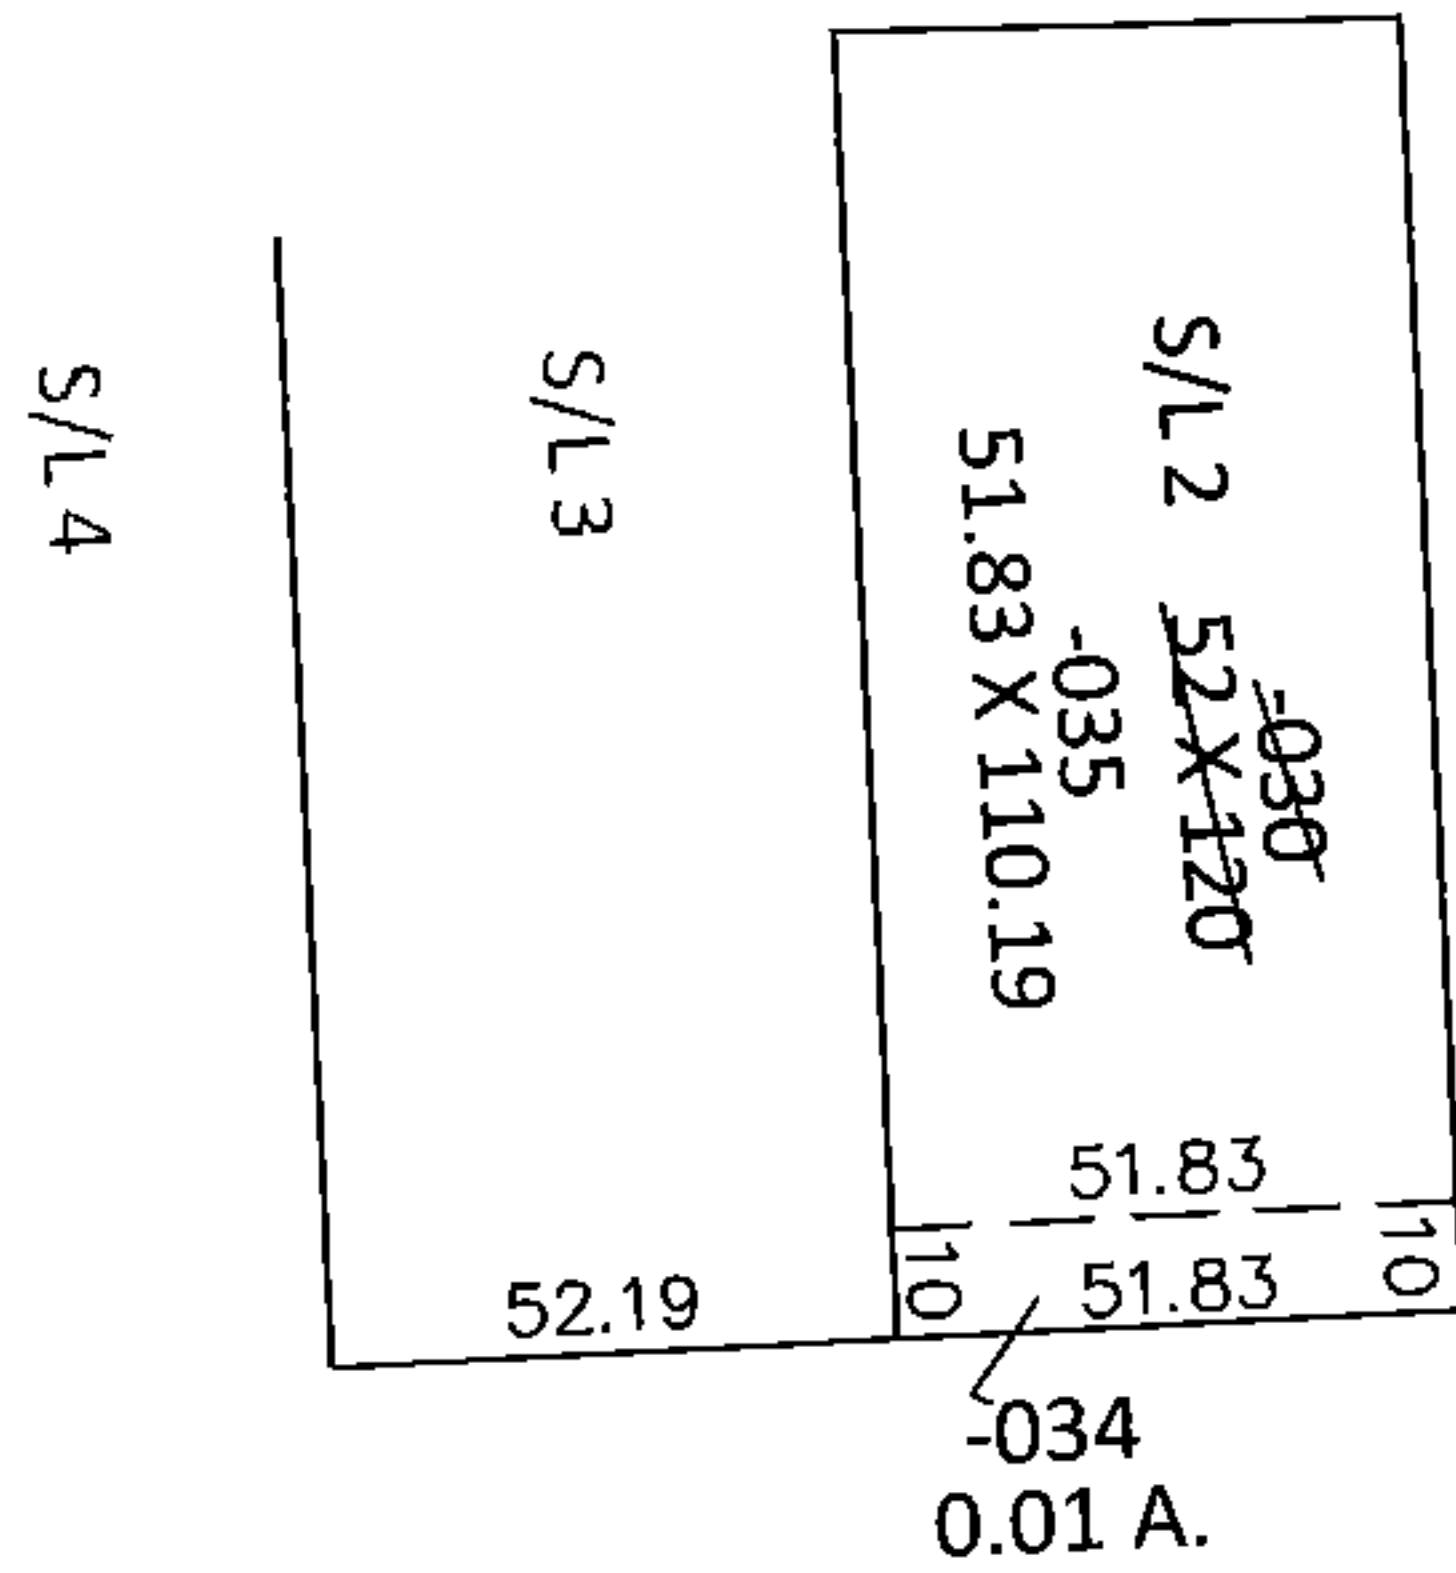


PARENT PARCEL: 03-00-109-130-030

CHILD PARCEL: 03-00-109-130-034, -035

STARTING POINT: SOUTHEAST CORNER OF S/L 4 IN RIDGEWOOD ALLOT.(VOL.7 PG.5)


13-00374

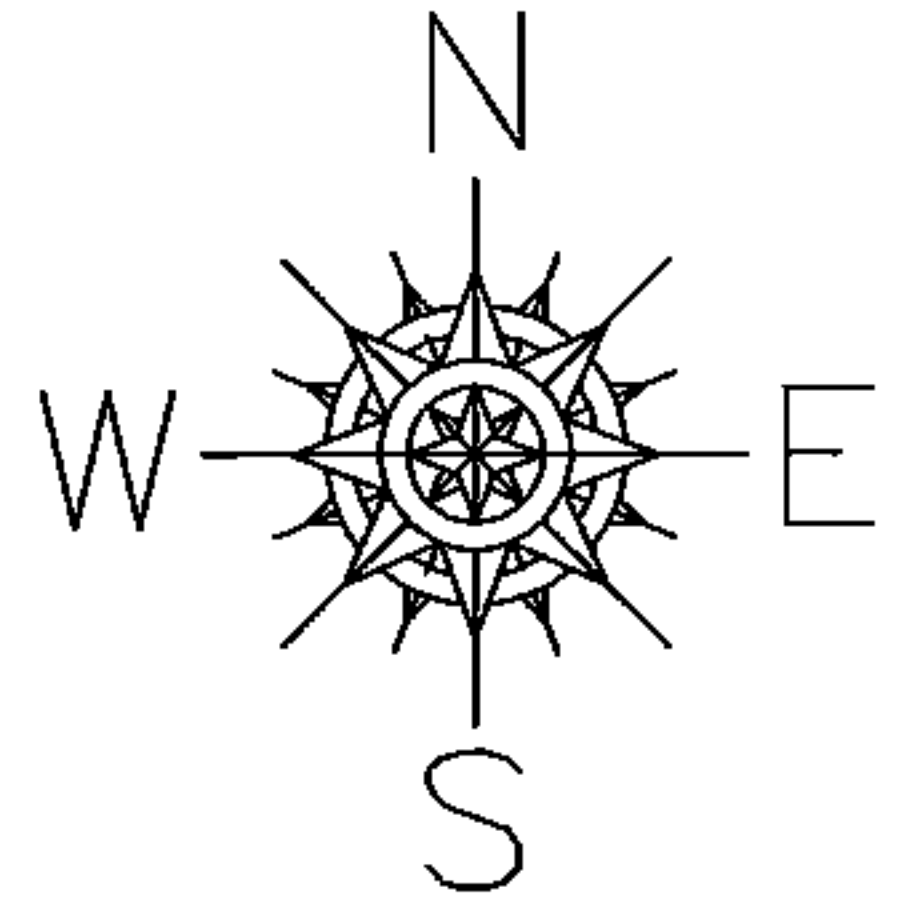

NORTH RIDGE RD. (S.R. 254)

LOR-254-0.01

4-WD

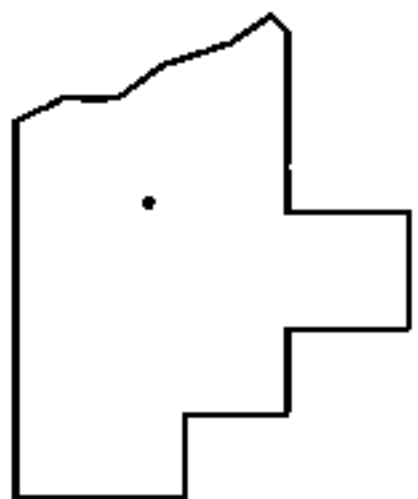

SPLITS/DEEDS PROCESSED

LORAIN COUNTY TAX MAP DEPARTMENT
226 MIDDLE AVE. ELYRIA, OHIO

SURVEYED BY: RICHARD F. MATHIAS

CLOSURE: .00:10,000

MAP PAGE(S): 3-00-109-B

APPROVED BY: RRM DATE: 2-19-13

SCALE: 1"= 50' PRIOR INST.: OR 218/936