


PARENT PARCEL: 03-00-075-111-007

CHILD PARCEL: 03-00-075-111-043, -044

13-00386

STARTING POINT: NORTHWEST CORNER OF S/L 1 IN ROWLAND SUB.(VOL.97 PG.74)

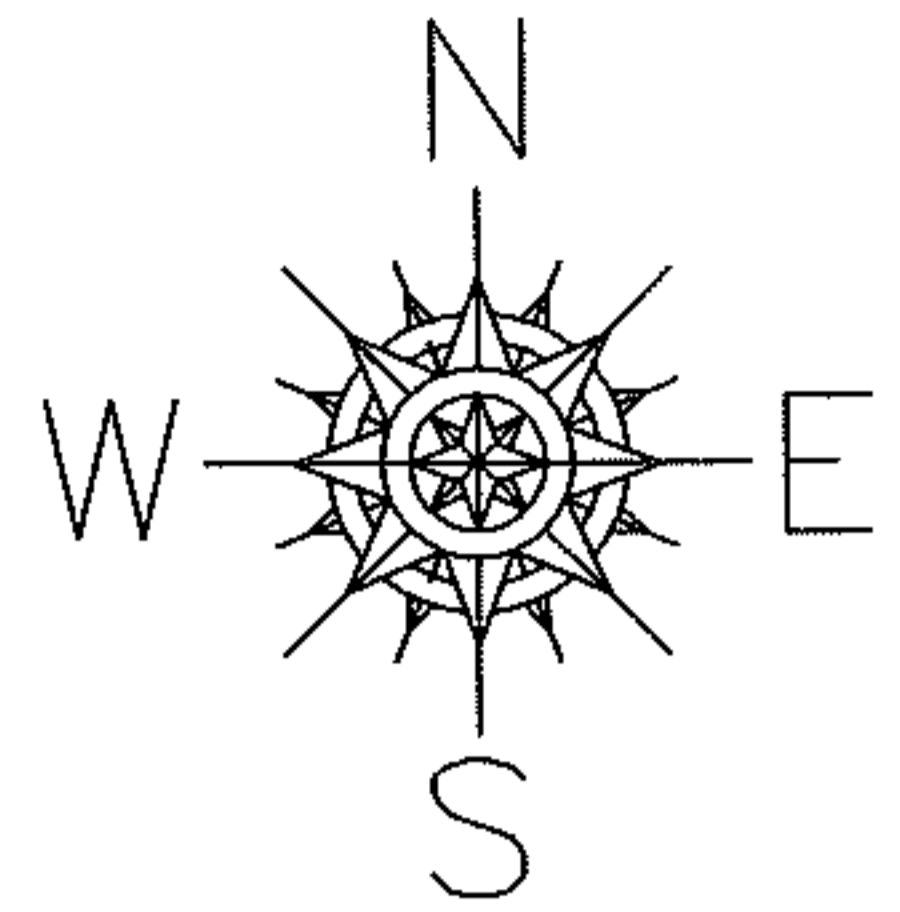

NORTH RIDGE RD. (S.R. 254)

DUTE AVE.

NORTHWEST CORNER  
S/L 1  
IN ROWLAND SUB.

372.94

-043  
0.01 A.

55.99  
55.99

S/L 14

55.99 X 158.30

~~56 X 198~~  
-044  
-007

LOR-254-0.01

13-WD3

SPLITS/DEEDS PROCESSED

LORAIN COUNTY TAX MAP DEPARTMENT  
226 MIDDLE AVE. ELYRIA, OHIO

SURVEYED BY: RICHARD F. MATHIAS

CLOSURE: .00:10,000

MAP PAGE(S): 3-00-075-A

APPROVED BY: RRM DATE: 2-20-13

SCALE: 1" = 50' PRIOR INST.: 20060167939