


PARENT PARCEL: 03-00-075-111-013

CHILD PARCEL: 03-00-075-111-055, -056

STARTING POINT: NORTHWEST CORNER OF S/L 1 IN ROWLAND SUB. (VOL.97 PG.74)

13-00393

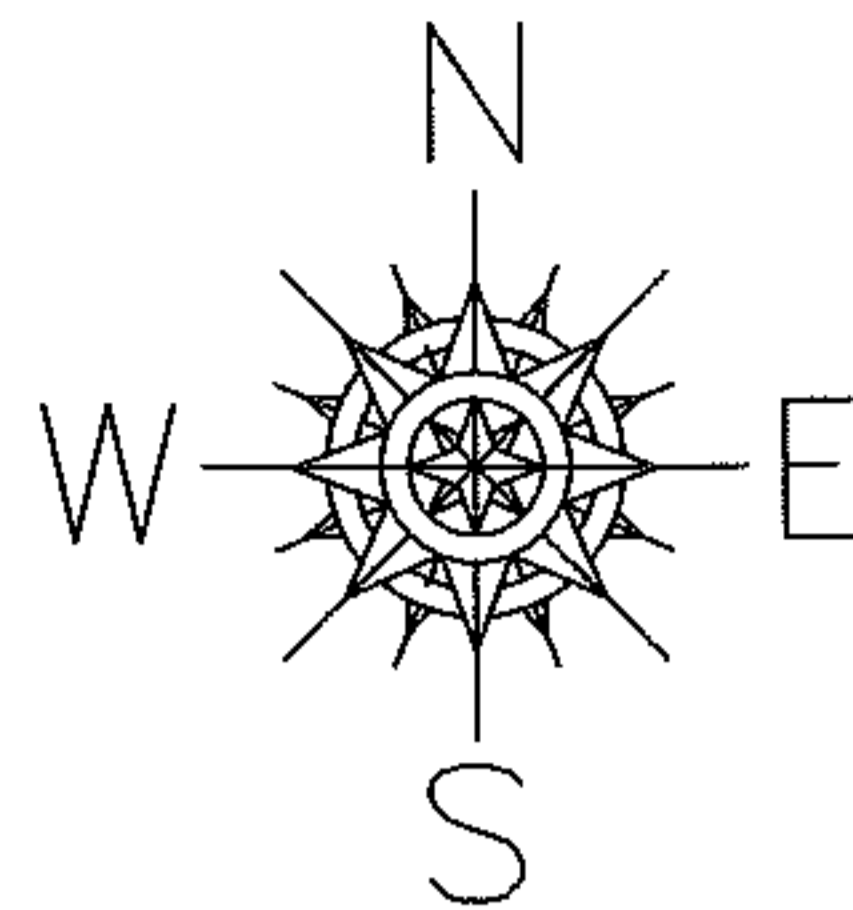

NORTH RIDGE RD. (S.R. 254)

DUTE AVE.

NORTHWEST CORNER
S/L 1
IN ROWLAND SUB.

699.19

-055
0.03 A.

22.01
53.94
22.01

53.85


S/L 20

53.85 x 168.99

~~54 X 221~~
~~-013~~
-056

LOR-254-0.01

19-WD2

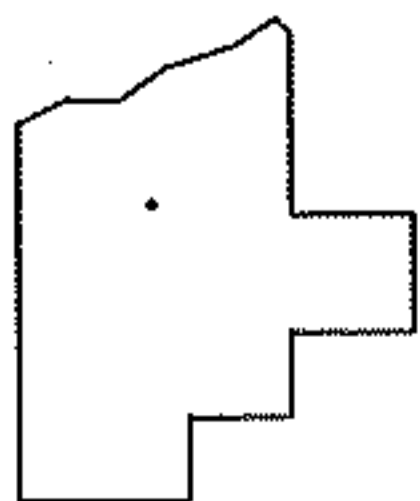

SPLITS/DEEDS PROCESSED

LORAIN COUNTY TAX MAP DEPARTMENT
226 MIDDLE AVE. ELYRIA, OHIO

SURVEYED BY: RICHARD F. MATHIAS

CLOSURE: .00:10,000

MAP PAGE(S): 3-00-075-A

APPROVED BY: RRM DATE: 2-21-13

SCALE: 1" = 50' PRIOR INST.: 20030968708