
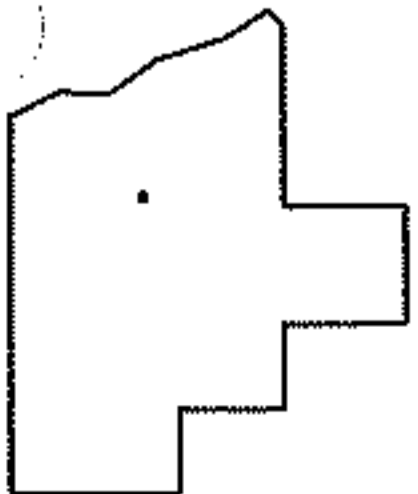
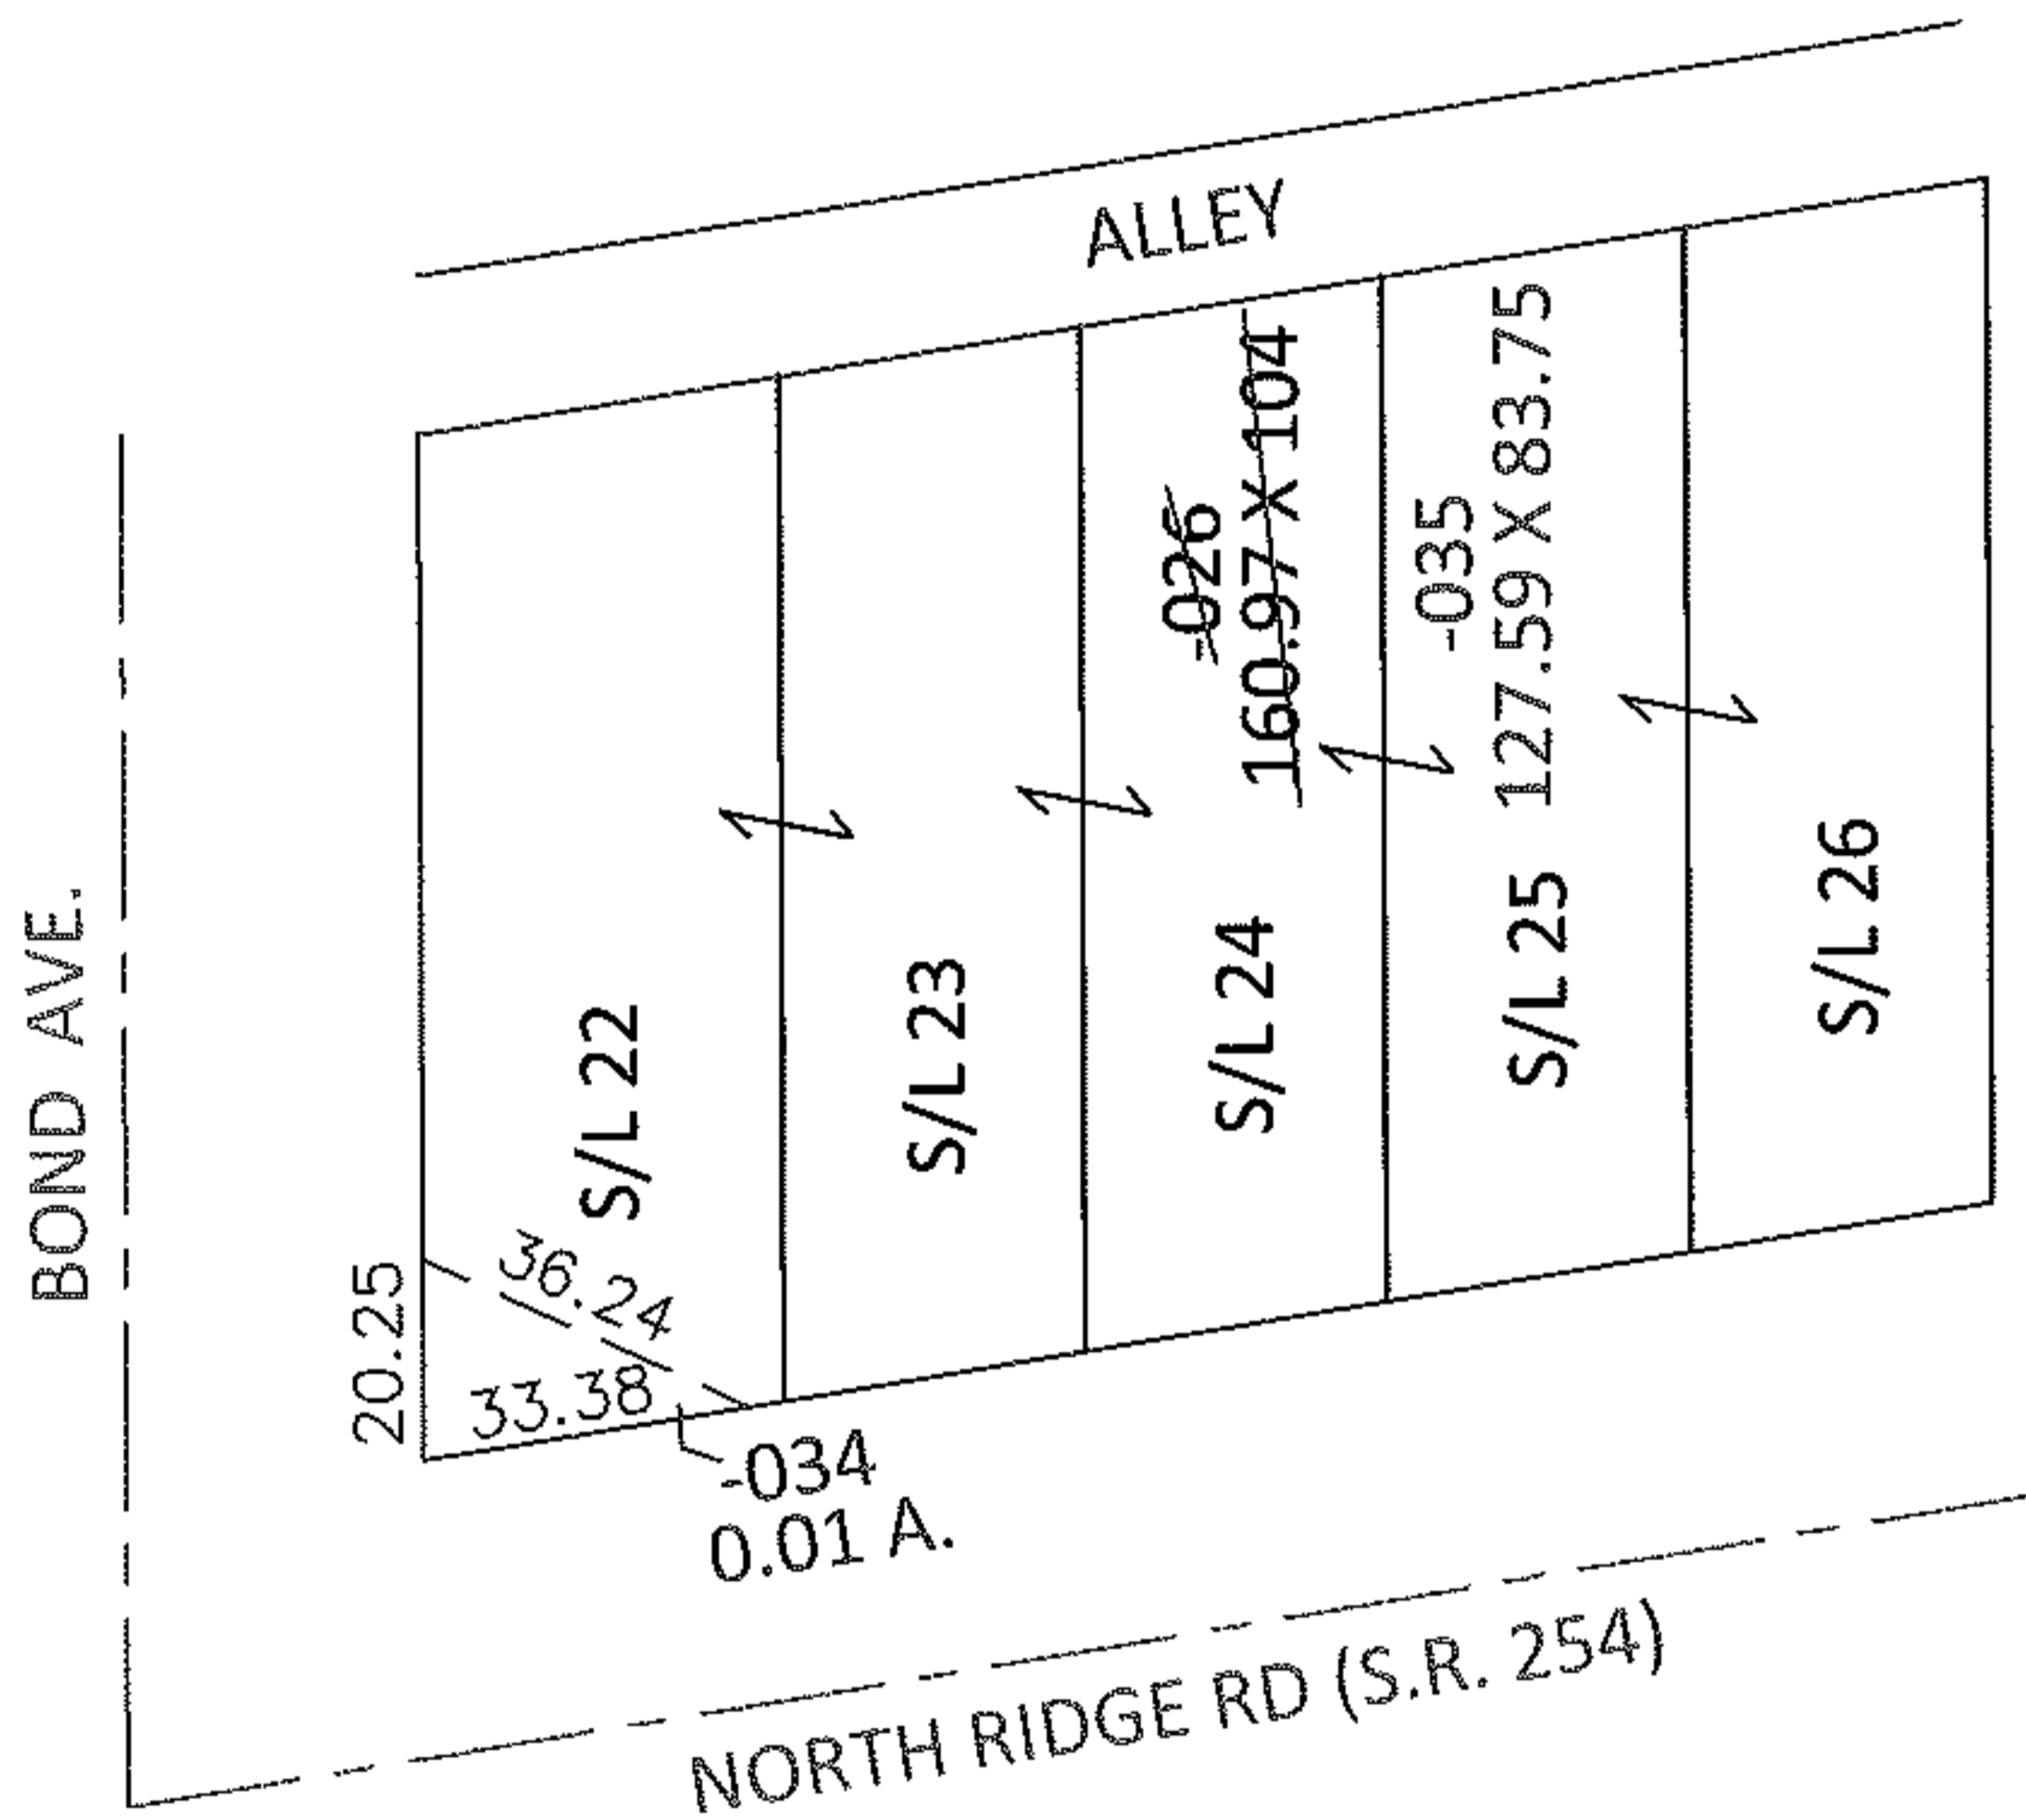


PARENT PARCEL: 03-00-075-110-026

CHILD PARCEL: 03-00-075-110-034, -035

STARTING POINT: SOUTHWEST CORNER OF LOT 22 IN LIBERTY SUB. (VOL.9 PG.26)

13-00398

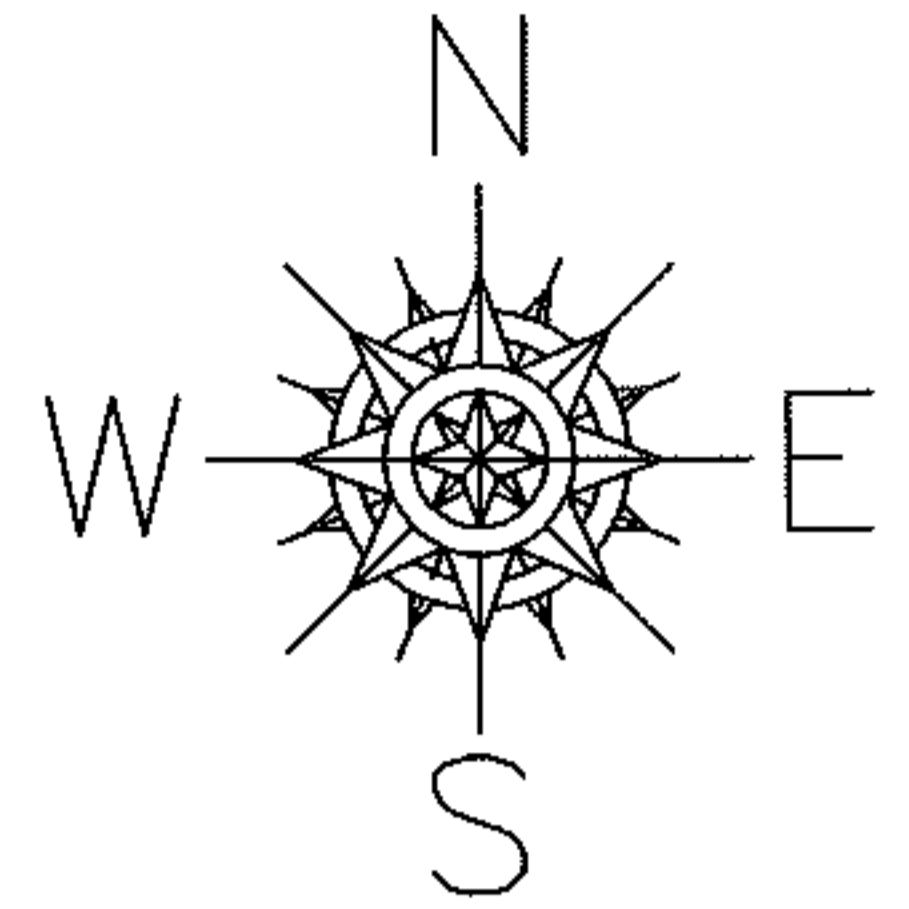

**SPLITS/DEEDS PROCESSED**

LORAIN COUNTY TAX MAP DEPARTMENT  
226 MIDDLE AVE. ELYRIA, OHIO

SURVEYED BY: RICHARD F. MATHIAS

CLOSURE: .00:10,000

MAP PAGE(S): 3-00-075-A

APPROVED BY: RRM DATE: 2-21-13

SCALE: 1"= 50' PRIOR INST.: 20080252753