
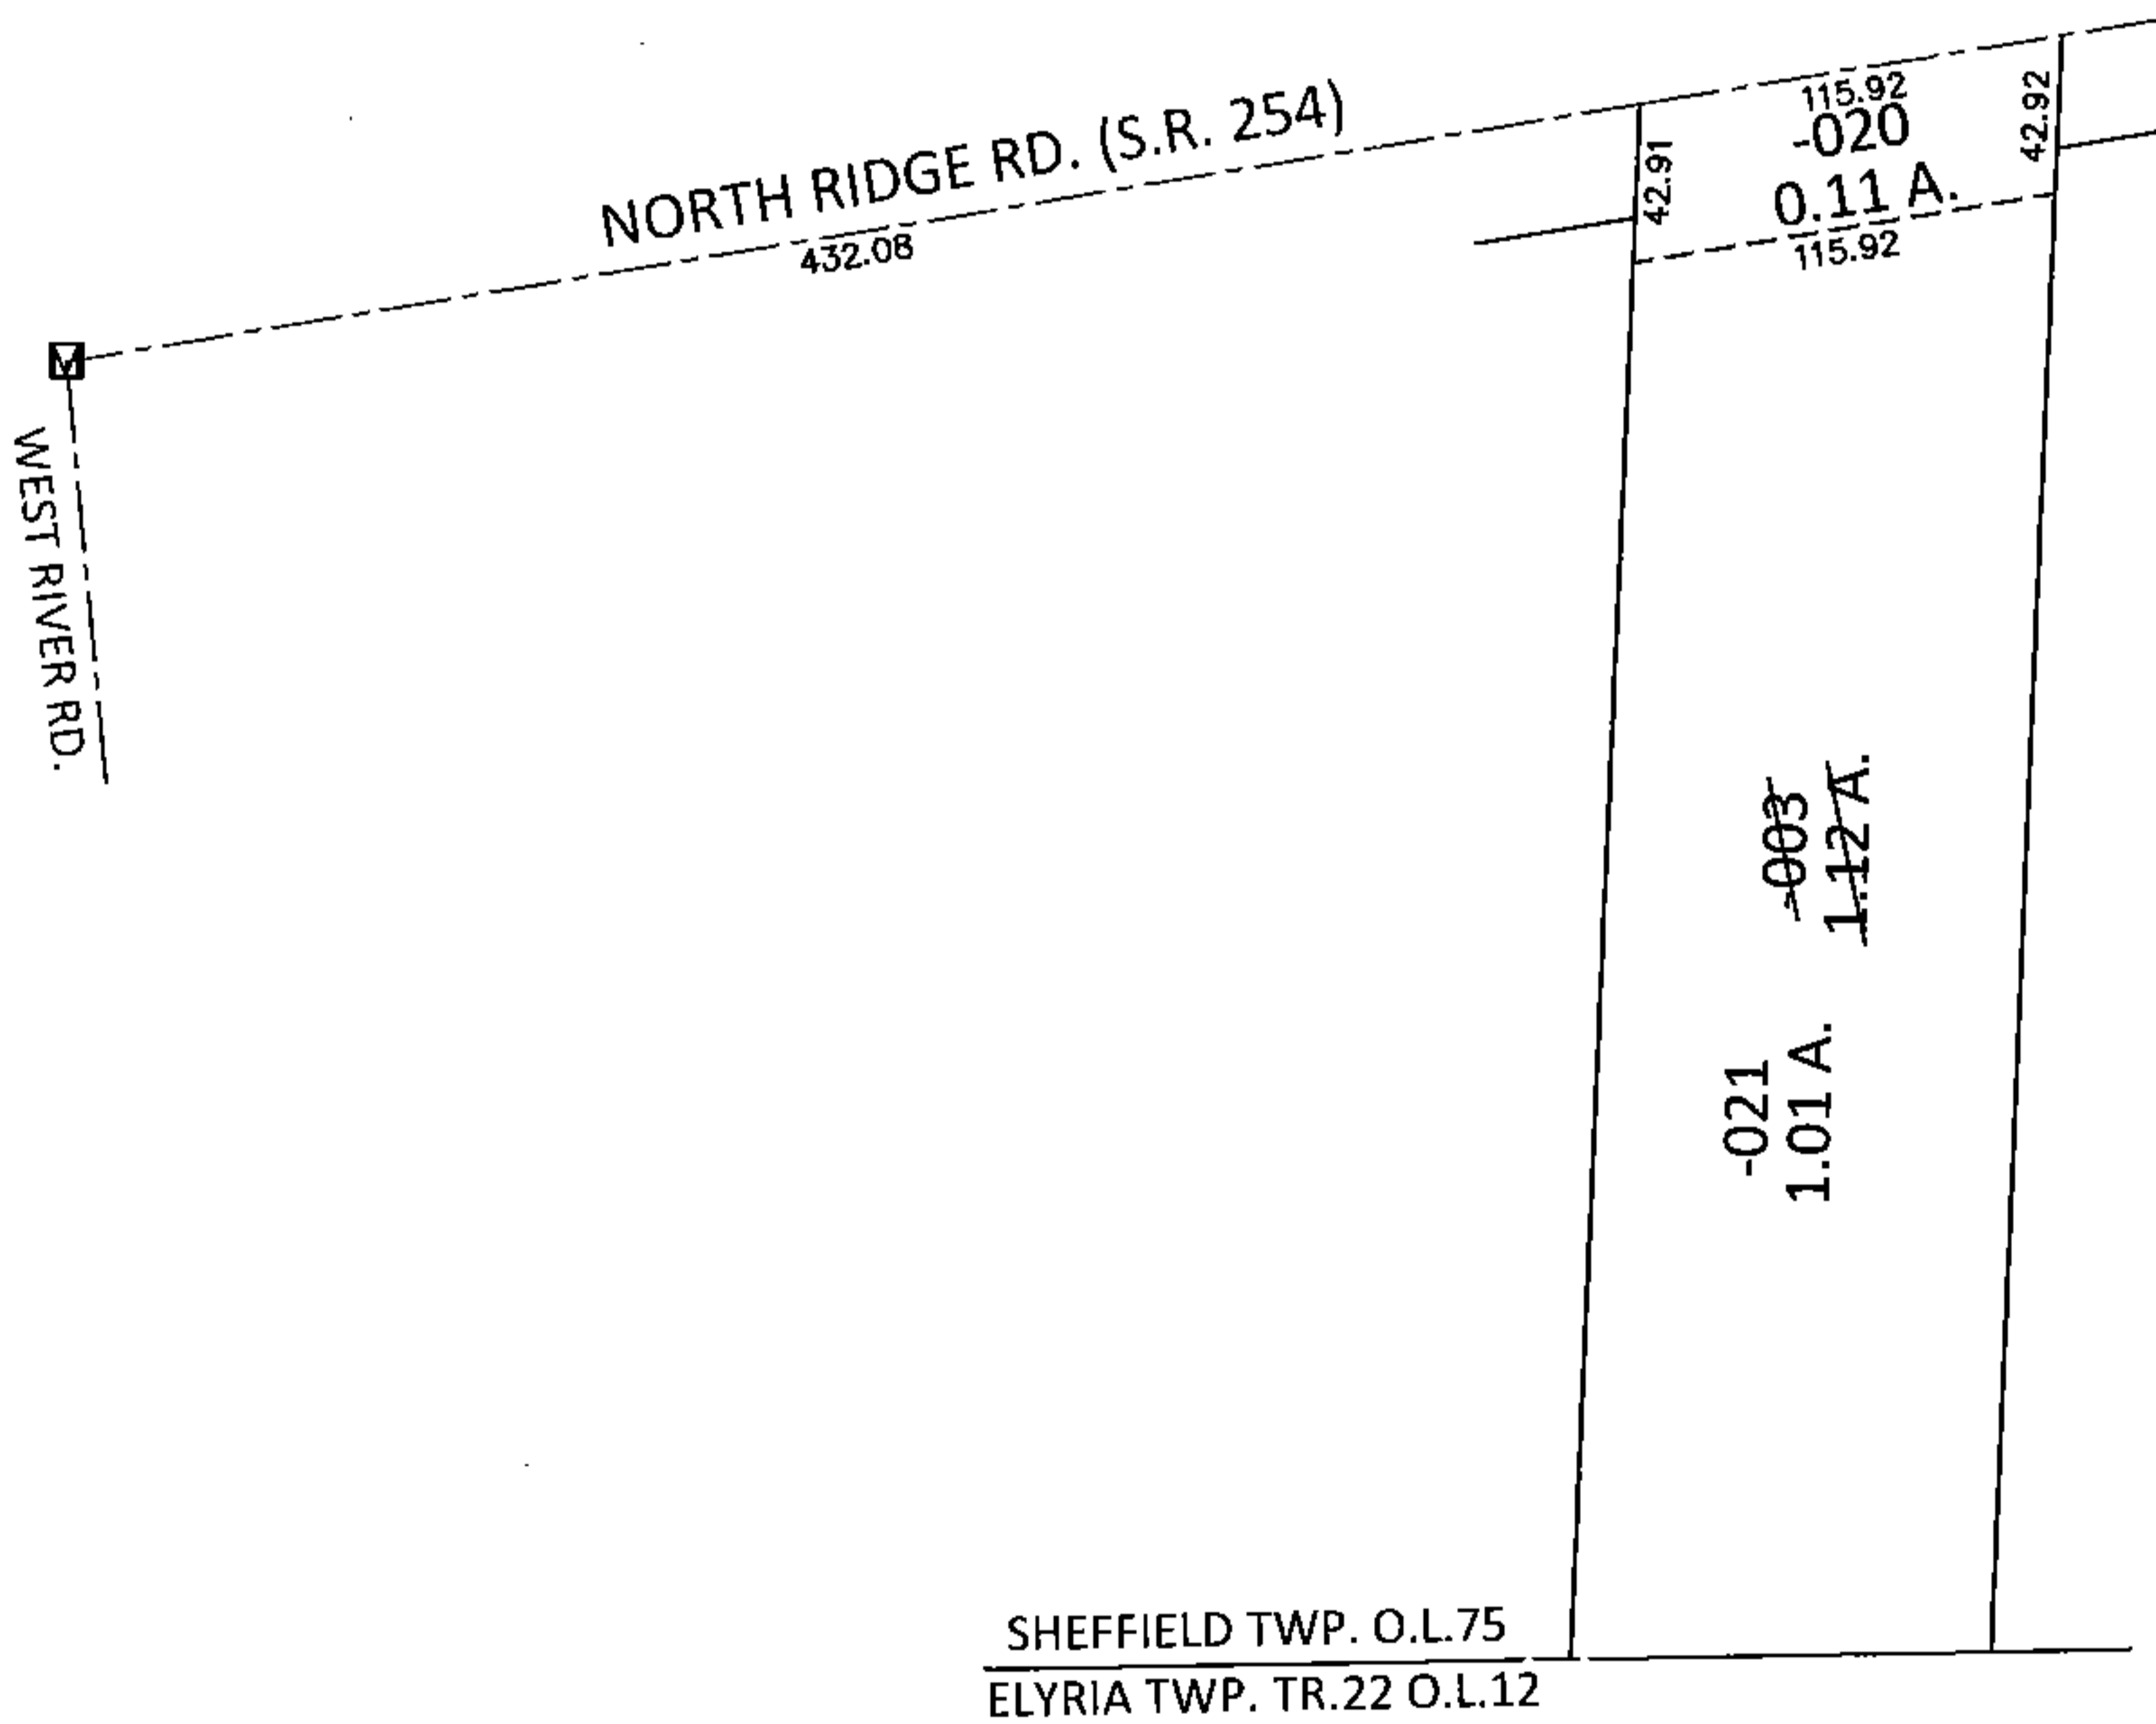


PARENT PARCEL: 03-00-075-113-003

CHILD PARCEL: 03-00-075-113-020, -021


STARTING POINT: AT A MON BOX AT THE INTERSECTION OF C/L S.R.254 AND C/L WEST RIVER RD.

13-00403

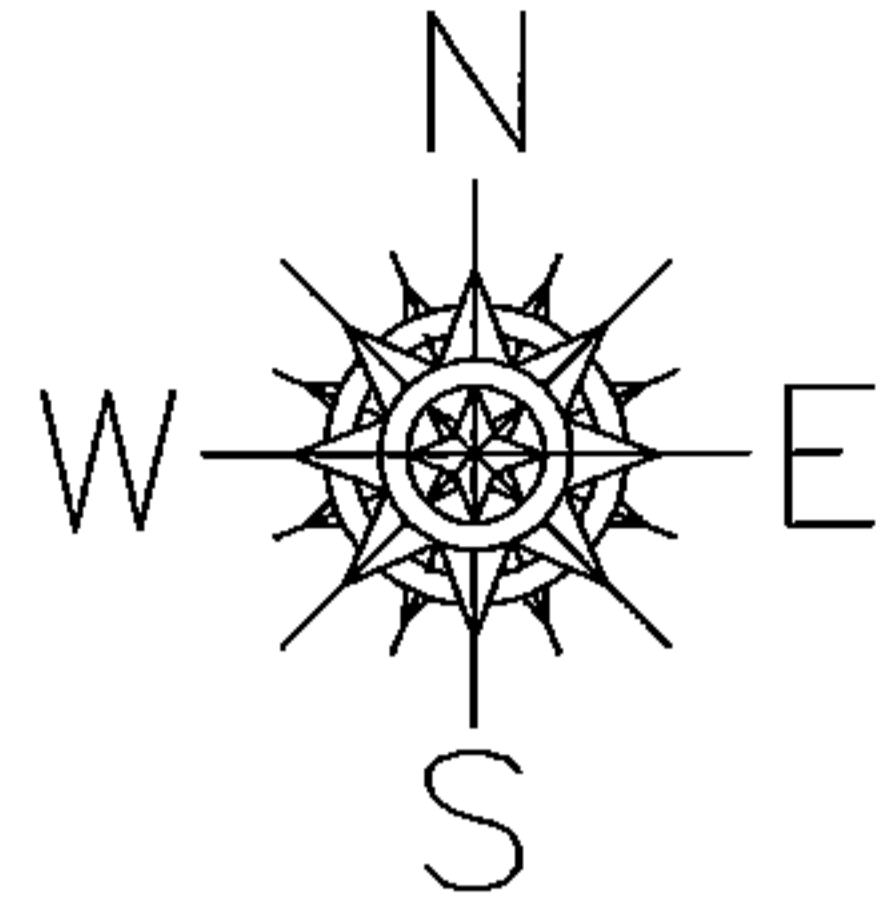

LOR-254-0.01

32-WD

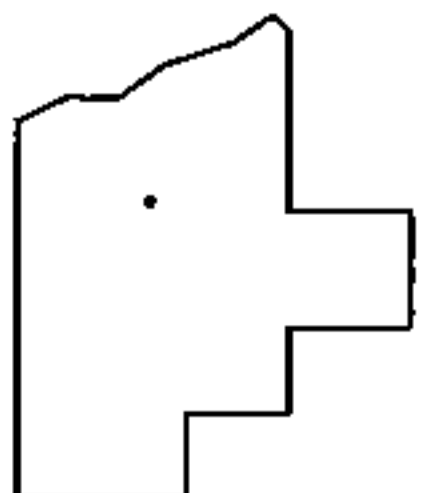

SPLITS/DEEDS PROCESSED

LORAIN COUNTY TAX MAP DEPARTMENT
226 MIDDLE AVE. ELYRIA, OHIO

SURVEYED BY: RICHARD F. MATHIAS

CLOSURE: .01:10,000

MAP PAGE(S): 3-00-075-A

APPROVED BY: RRM DATE: 2-22-13

SCALE: 1"=100 PRIOR INST.: 20080276963