
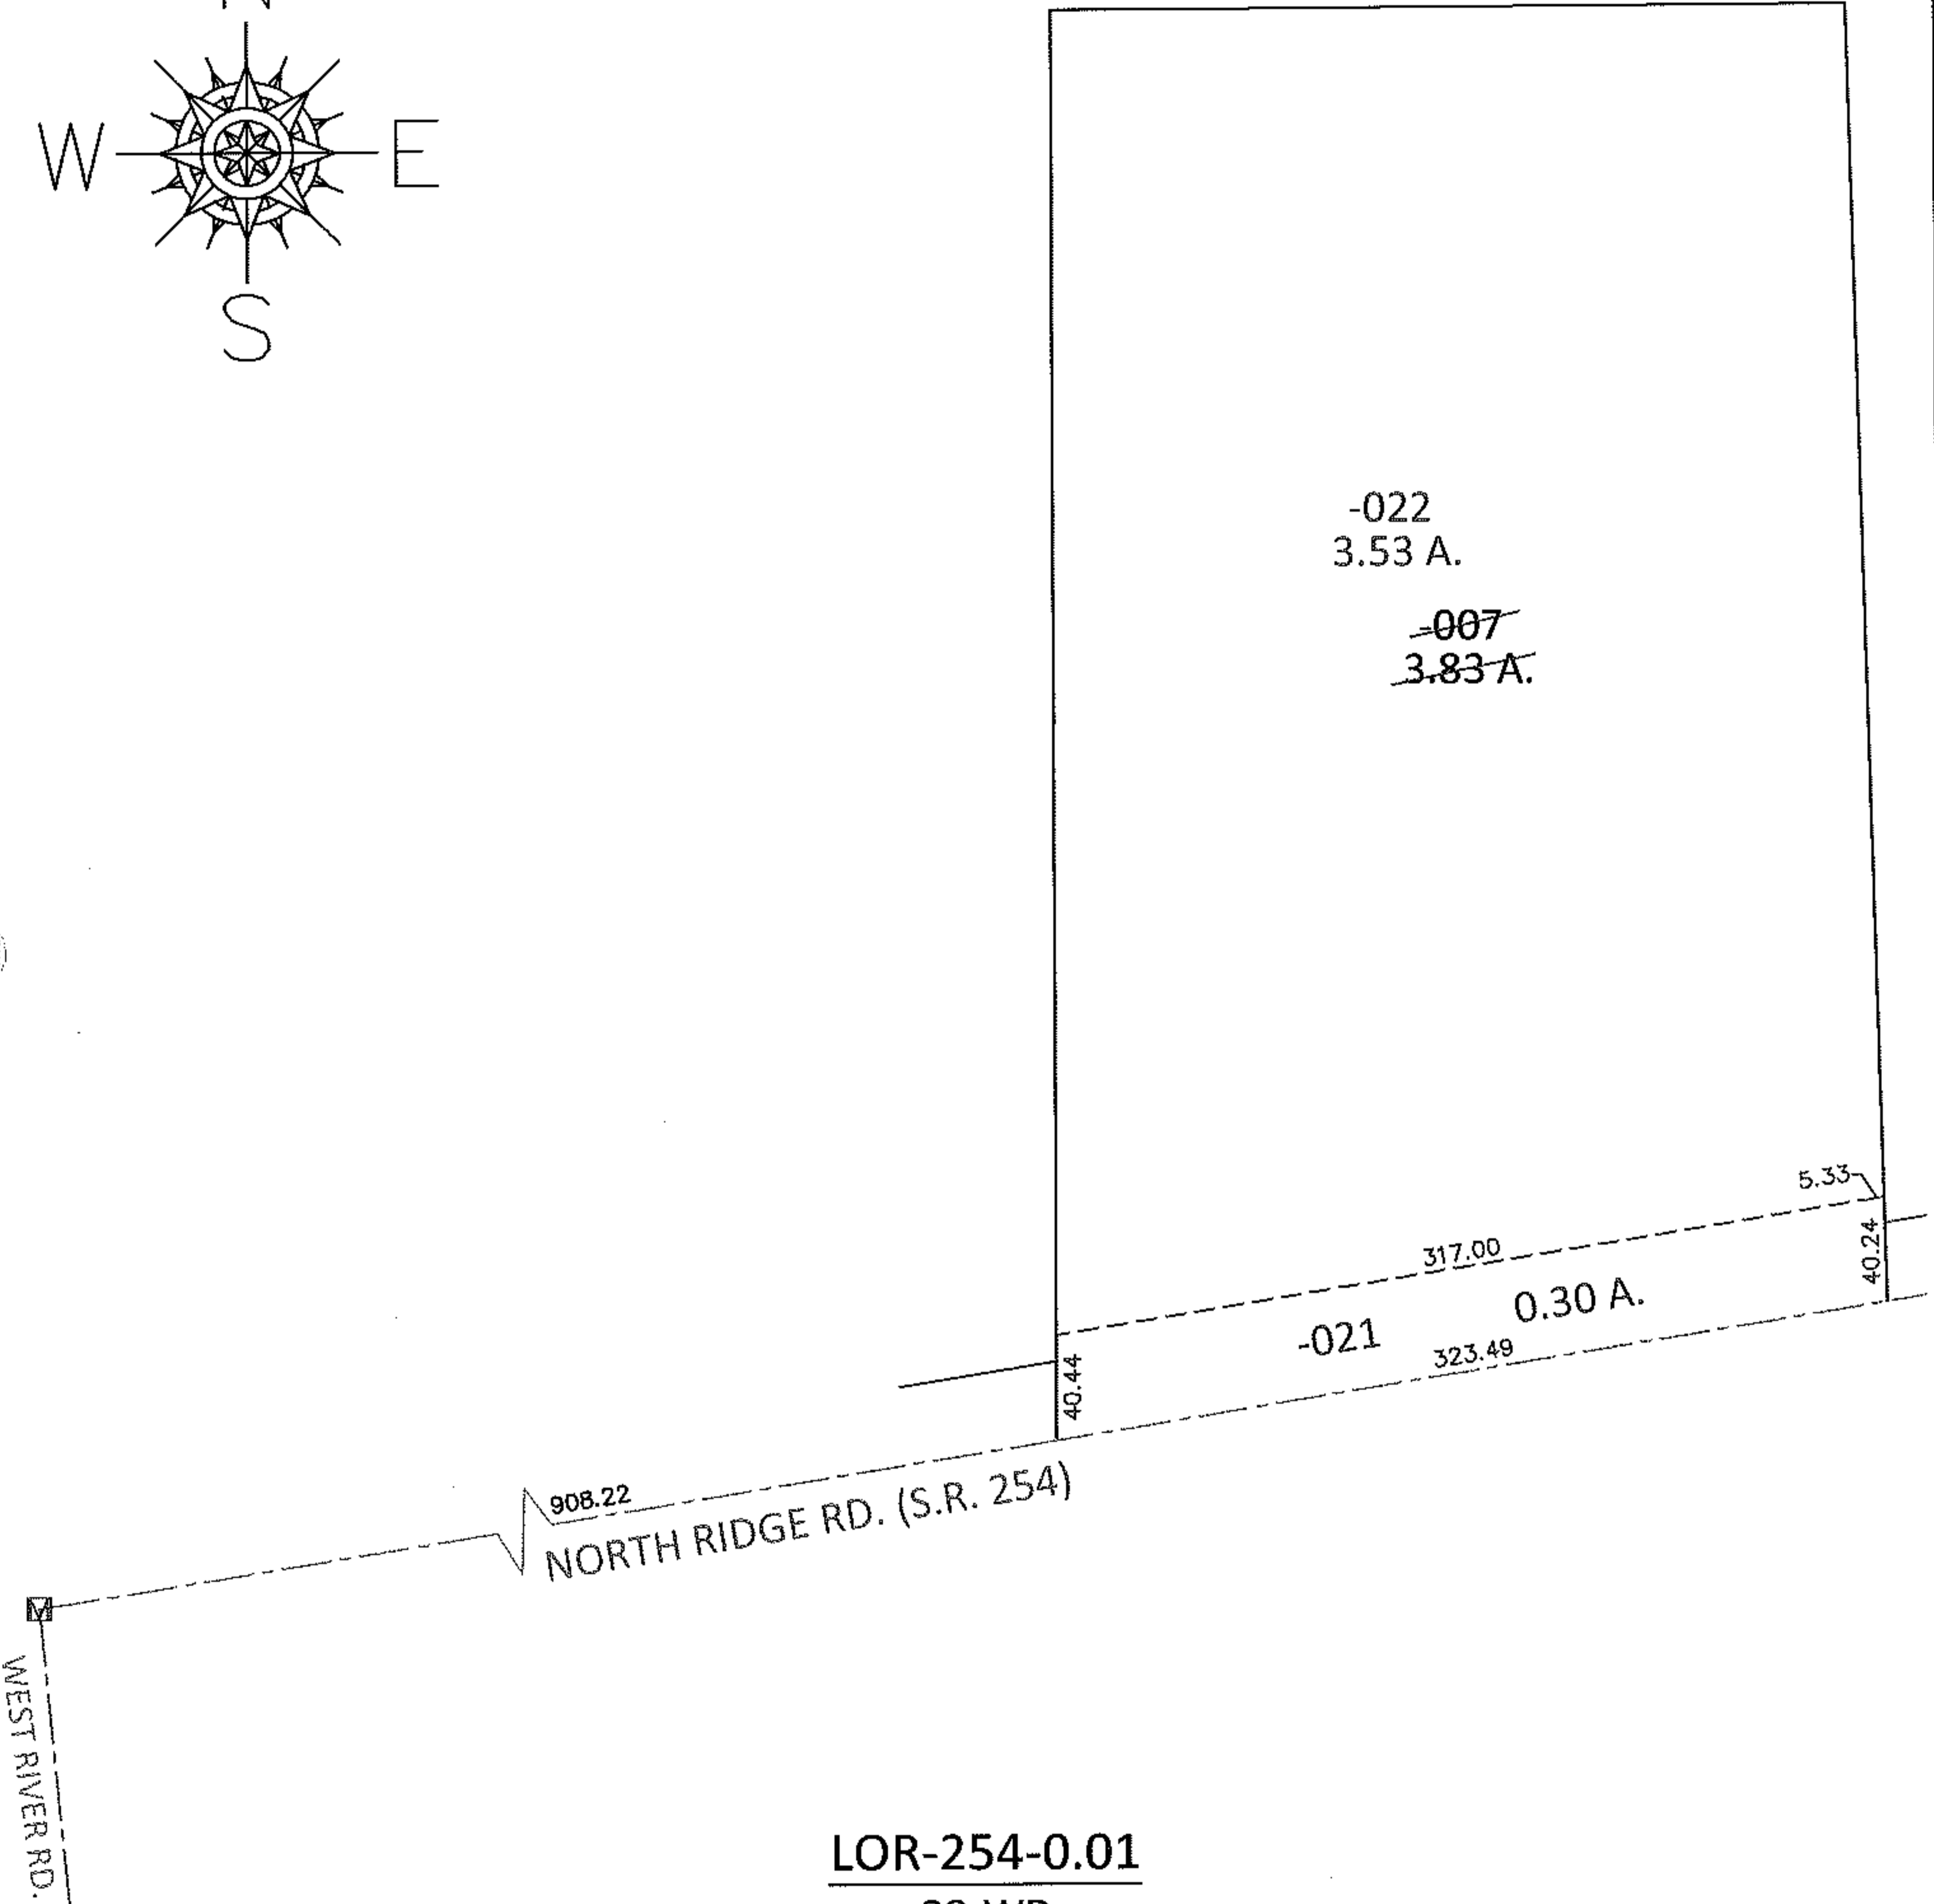


PARENT PARCEL: 03-00-075-112-007


CHILD PARCEL: 03-00-075-112-021, -022

13-00409

STARTING POINT: AT A MON BOX AT THE INTERSECTION OF C/L S.R.254 AND C/L WEST RIVER RD.

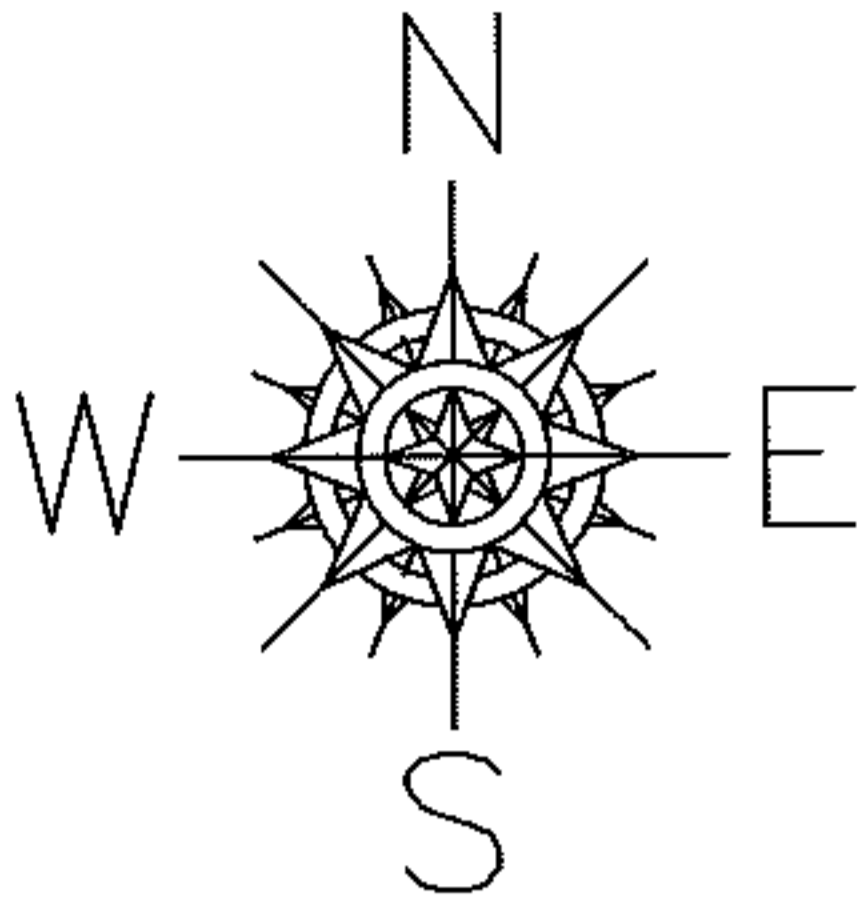

LOR-254-0.01  
38-WD

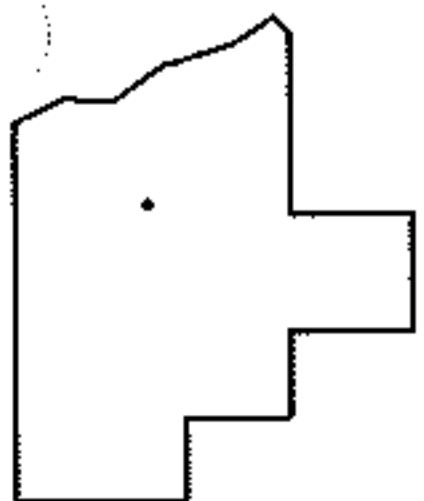

SPLITS/DEEDS PROCESSED

LORAIN COUNTY TAX MAP DEPARTMENT  
226 MIDDLE AVE. ELYRIA, OHIO

SURVEYED BY: RICHARD F. MATHIAS

CLOSURE: .01:10,000

MAP PAGE(S): 3-00-075-B

APPROVED BY: RRM DATE: 2-25-13

SCALE: 1"= 100 PRIOR INST.: 20070188501