


PARENT PARCEL: 03-00-076-112-009

CHILD PARCEL: 03-00-075-112-023, 03-00-076-112-010

13-00410

STARTING POINT: AT A MON BOX AT THE INTERSECTION OF C/L OF S.R.254 AND C/L OF WEST RIVER RD.

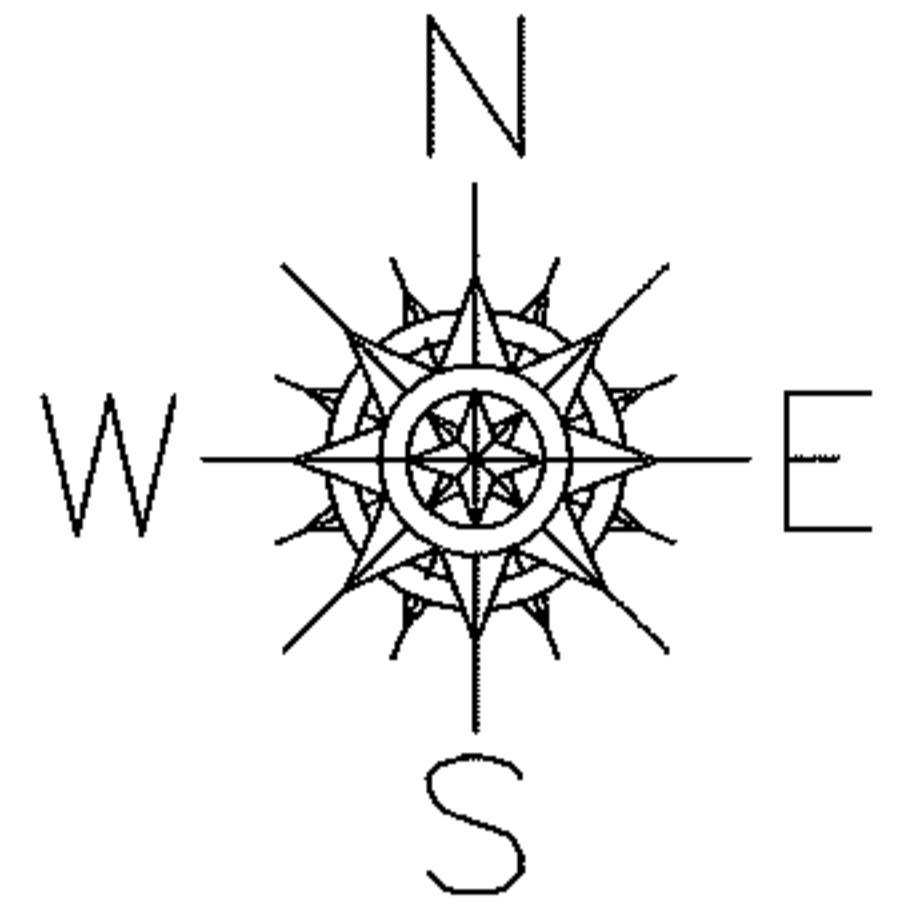

-010  
34.10 A.

~~-009~~  
~~34.61 A.~~

O.L.76  
O.L.75



L. & W. V. R.R.

14.28


573.60  
556.92

-023  
0.51 A.

1231.71  
NORTH RIDGE RD. (S.R. 254)

WEST RIVER RD.

LOR-254-0.01  
41-WD

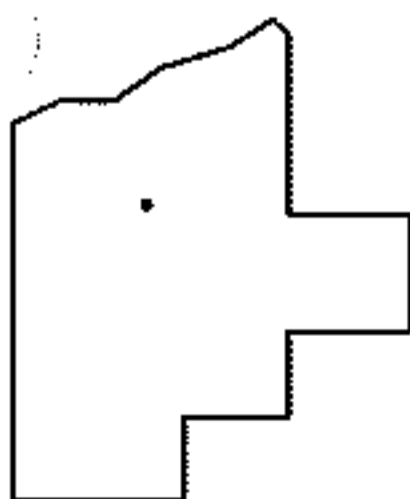

SPLITS/DEEDS PROCESSED

LORAIN COUNTY TAX MAP DEPARTMENT  
226 MIDDLE AVE. ELYRIA, OHIO

SURVEYED BY: RICHARD F. MATHIAS

CLOSURE: .01:10,000

MAP PAGE(S): 3-00-075-B

APPROVED BY: RRM DATE: 2-25-13

SCALE: 1"= 200 PRIOR INST.: 20030975064