
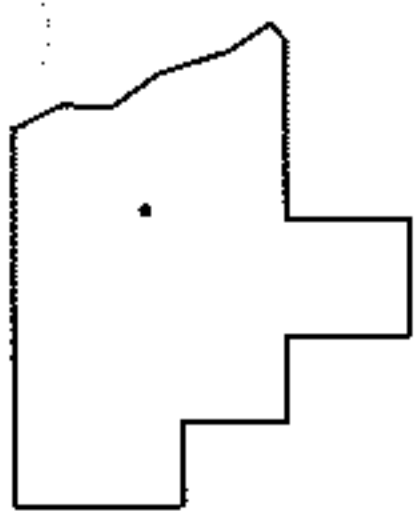
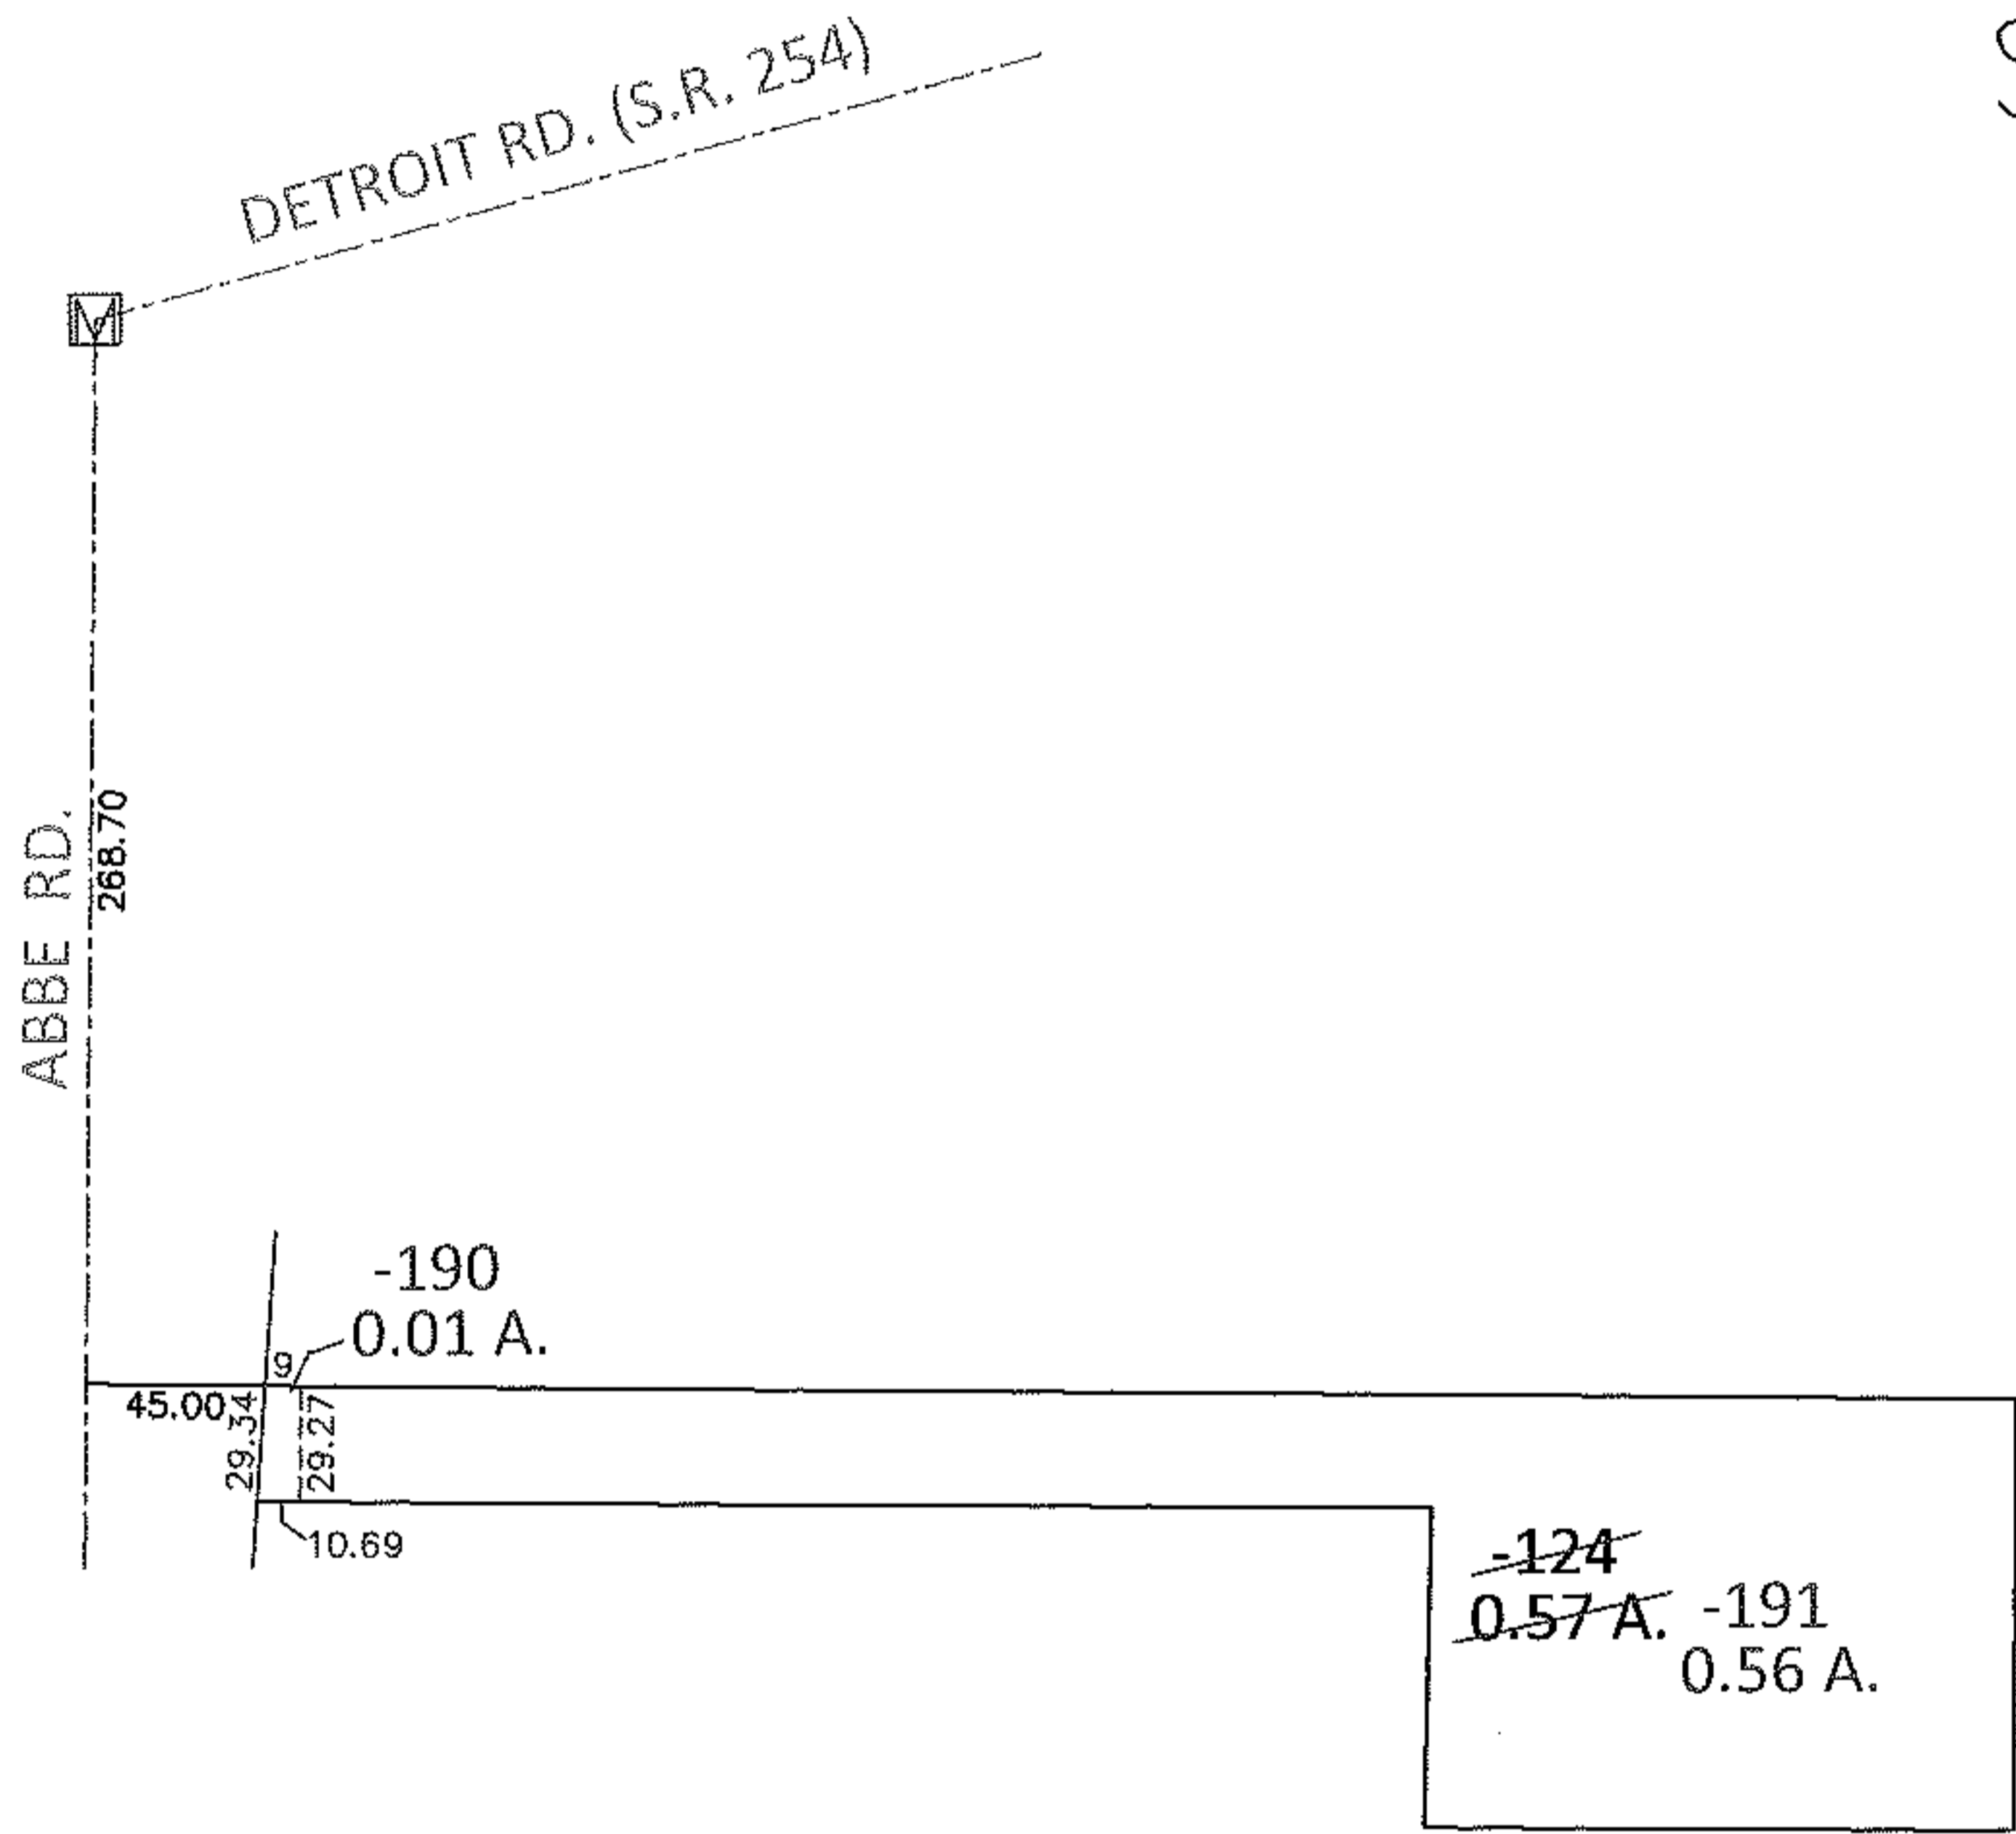


PARENT PARCEL: 03-00-001-000-124

CHILD PARCEL: 03-00-001-000-190, -191

13-00418

STARTING POINT: AT A MON BOX AT THE INTERSECTION OF C/L OF S.R.254 AND C/L OF ABBE RD.

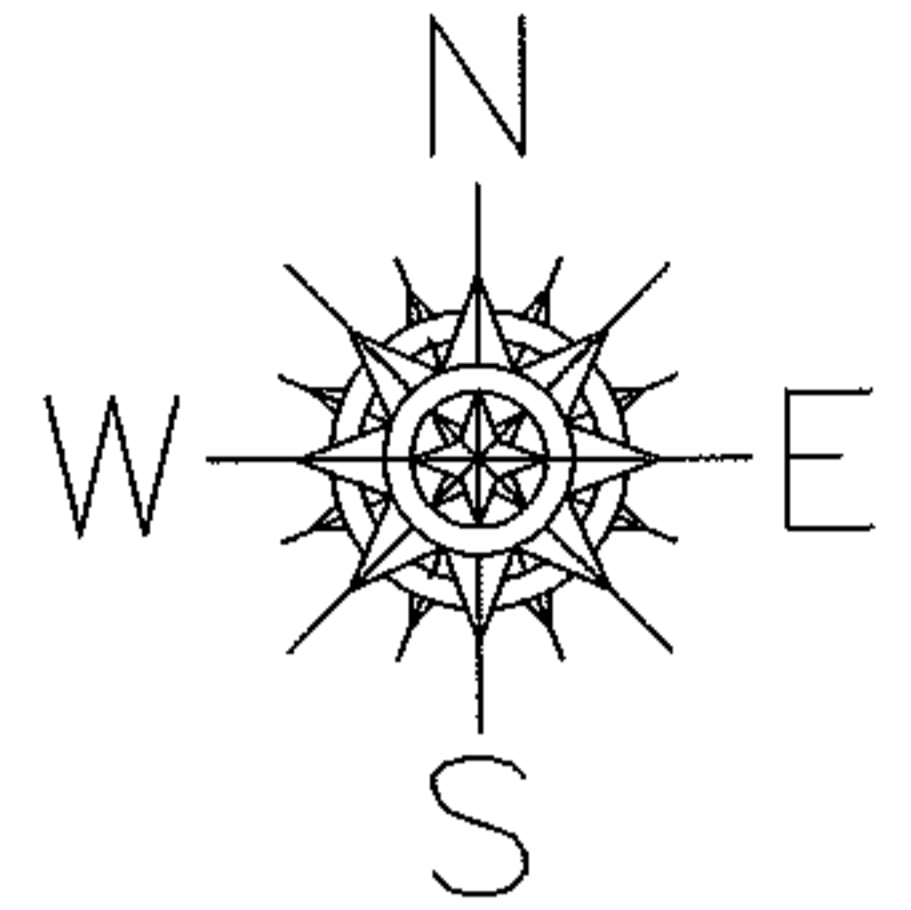

SPLITS/DEEDS PROCESSED

LORAIN COUNTY TAX MAP DEPARTMENT
226 MIDDLE AVE. ELYRIA, OHIO

SURVEYED BY: RICHARD JOHN SWAN
 CLOSURE: .00:10,000
 MAP PAGE(S): 3-00-001-A
 APPROVED BY: RRM DATE: 1-29-13
 SCALE: 1"= 100 PRIOR INST.: OR 1202/422