


PARENT PARCEL: 03-00-011-102-077

CHILD PARCEL: 03-00-011-102-134, -135



13-00421

STARTING POINT: AT A MON BOX AT THE INTERSECTION OF C/L OF S.R. 254 AND C/L OF ABBE RD.

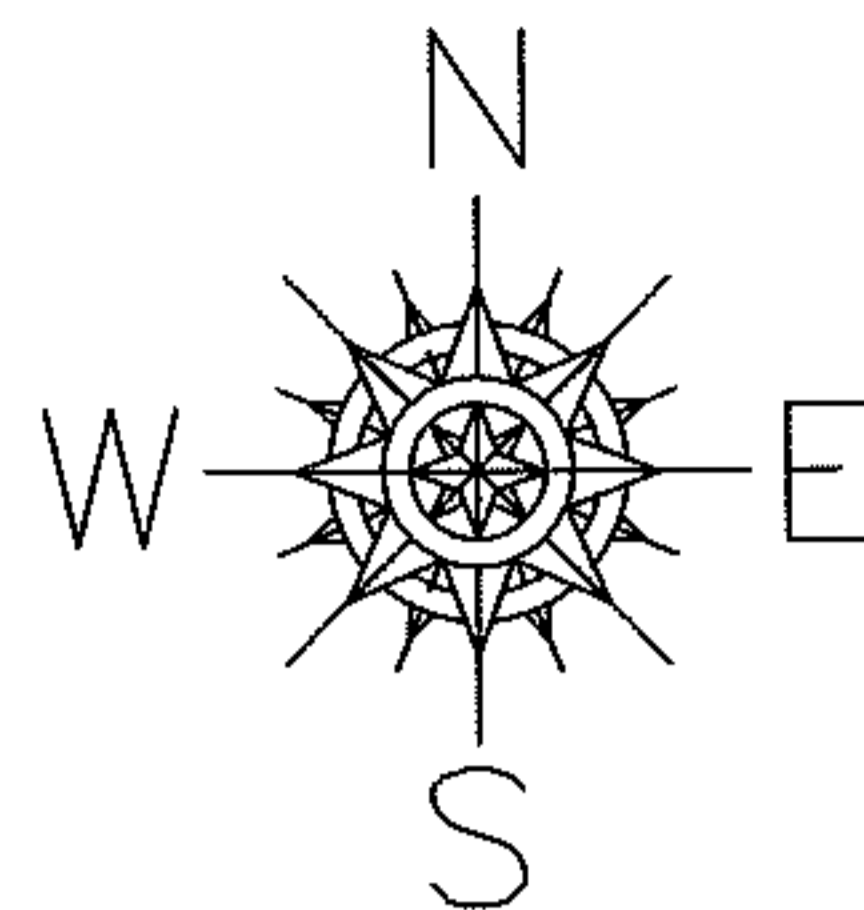

DETROIT RD. (S.R. 254)

307.15
ABBE RD.

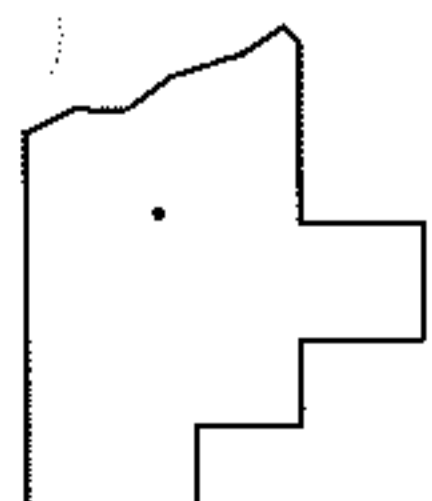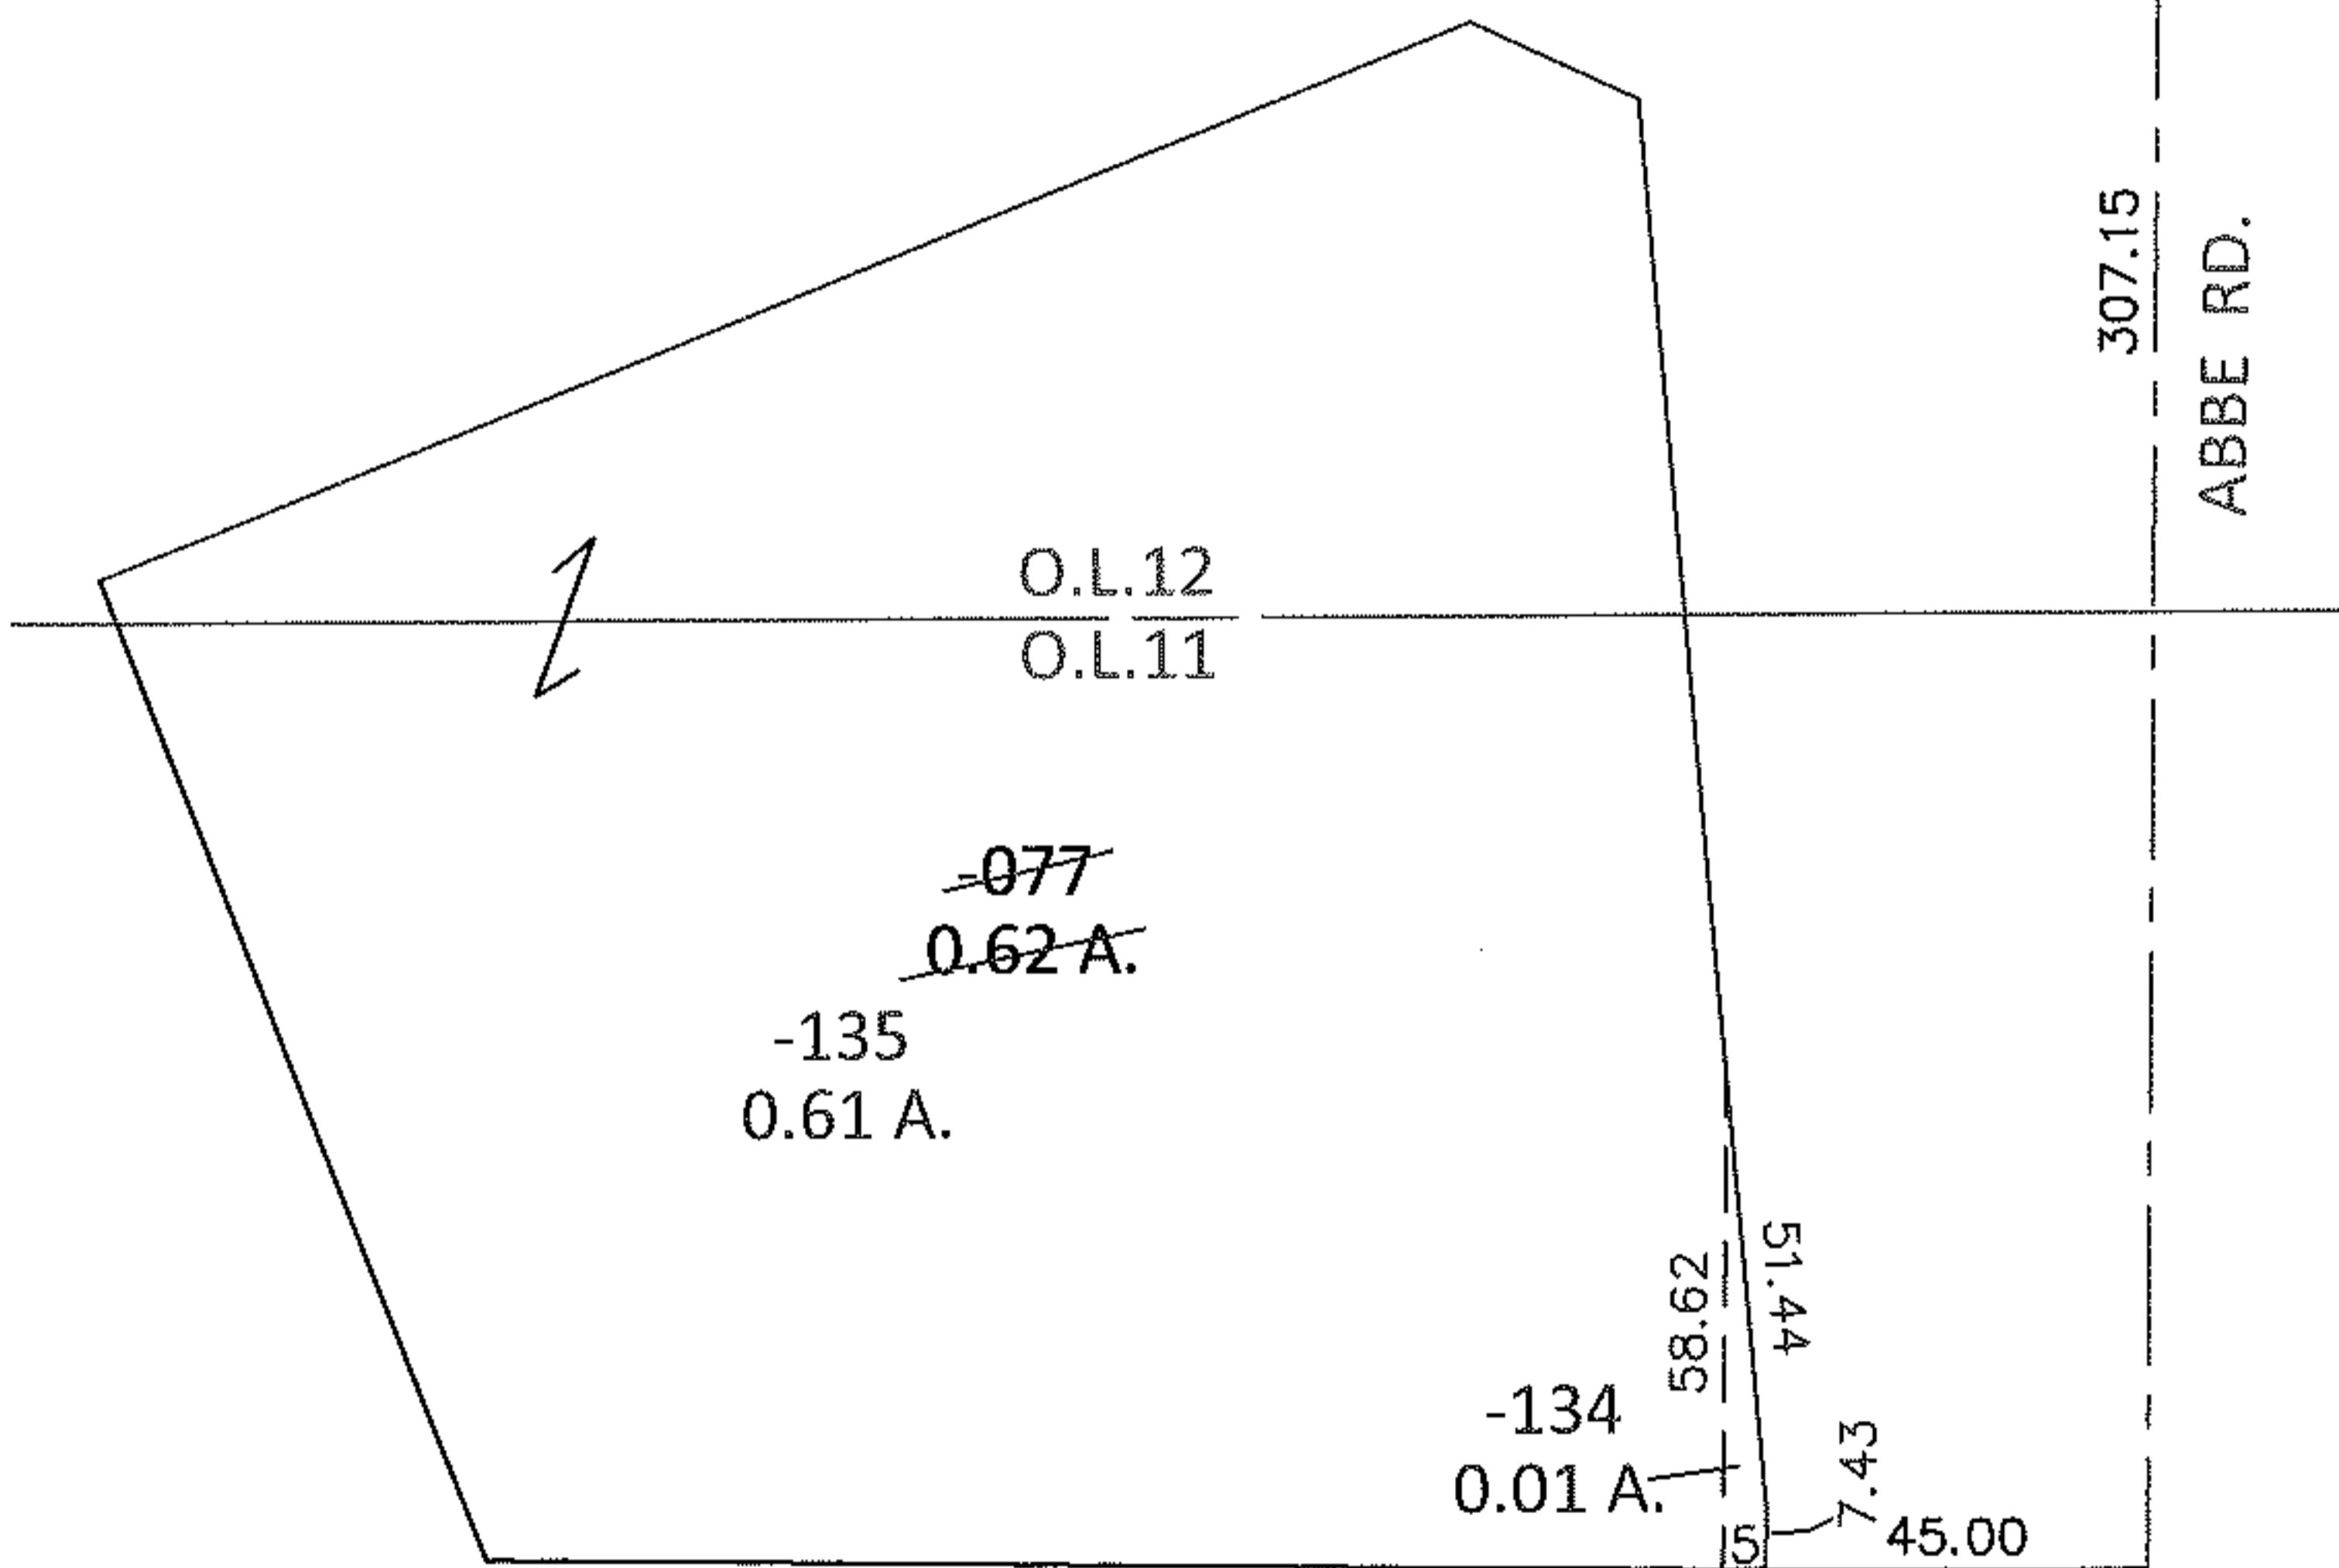

SPLITS/DEEDS PROCESSED

LORAIN COUNTY TAX MAP DEPARTMENT
226 MIDDLE AVE. ELYRIA, OHIO

SURVEYED BY: RICHARD JOHN SWAN
CLOSURE: .00:10,000
MAP PAGE(S): 3-00-011-B
APPROVED BY: RRM DATE: 2-6-13
SCALE: 1"= 50' PRIOR INST.: 20080253528