
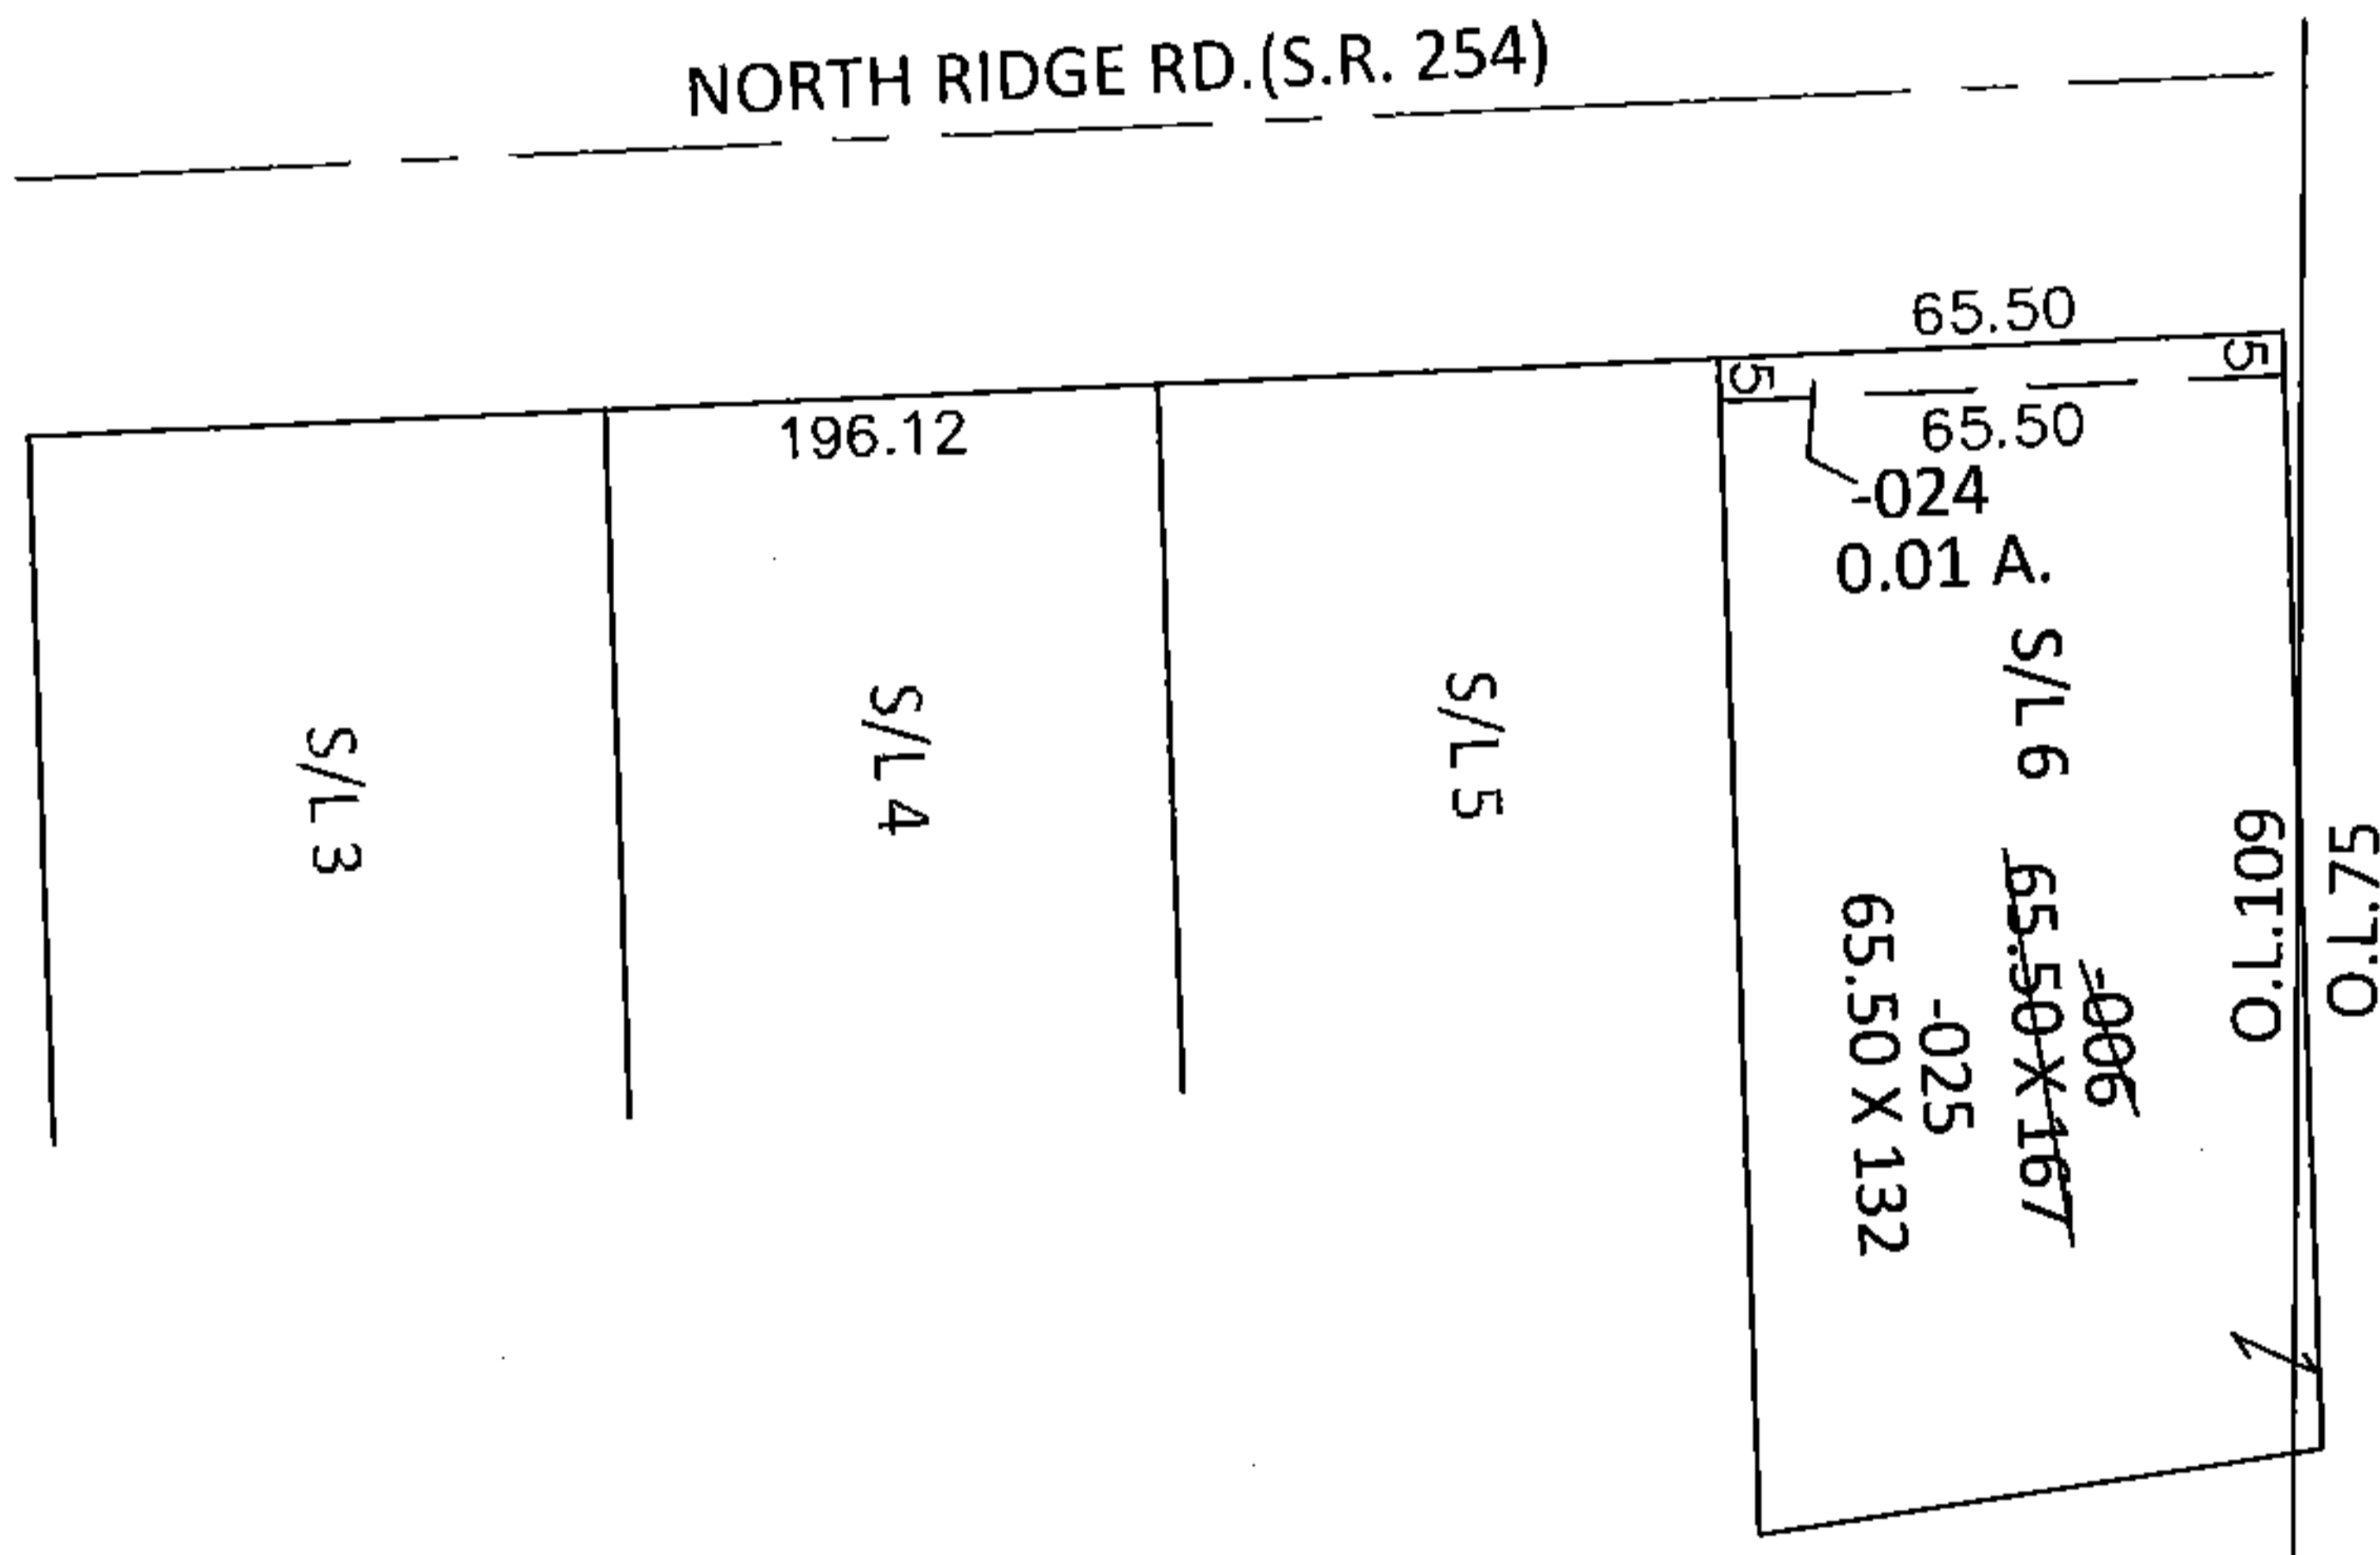


PARENT PARCEL: 03-00-109-132-006

CHILD PARCEL: 03-00-109-132-024, -025


STARTING POINT: NORTHWEST CORNER OF S/L 3 IN ESCHTRUTH ALLOT. (VOL.7 PG.48)

13-00424

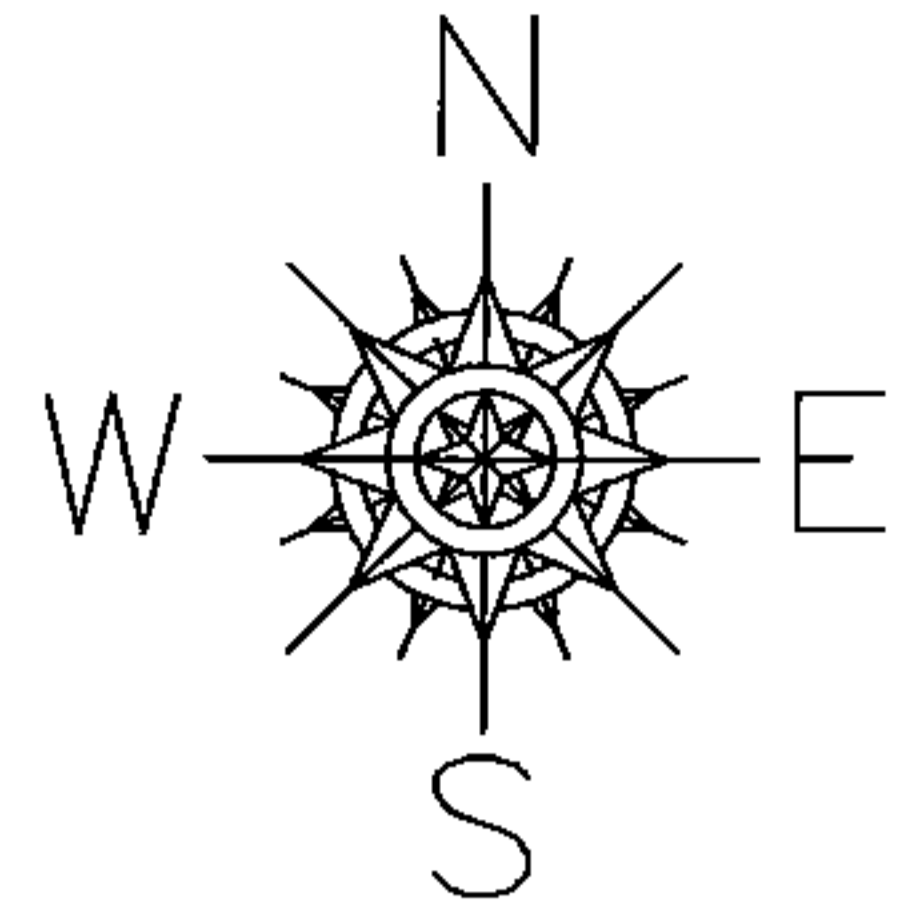

LOR-254-0.01

8-WD

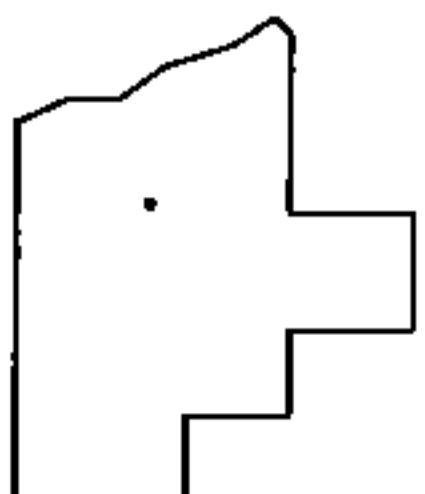

SPLITS/DEEDS PROCESSED

LORAIN COUNTY TAX MAP DEPARTMENT  
226 MIDDLE AVE. ELYRIA, OHIO

SURVEYED BY: RICHARD F. MATHIAS

CLOSURE: .00:10,000

MAP PAGE(S): 3-00-109-B

APPROVED BY: RRM DATE: 2-26-13

SCALE: 1" = 50' PRIOR INST.: 20030927723