
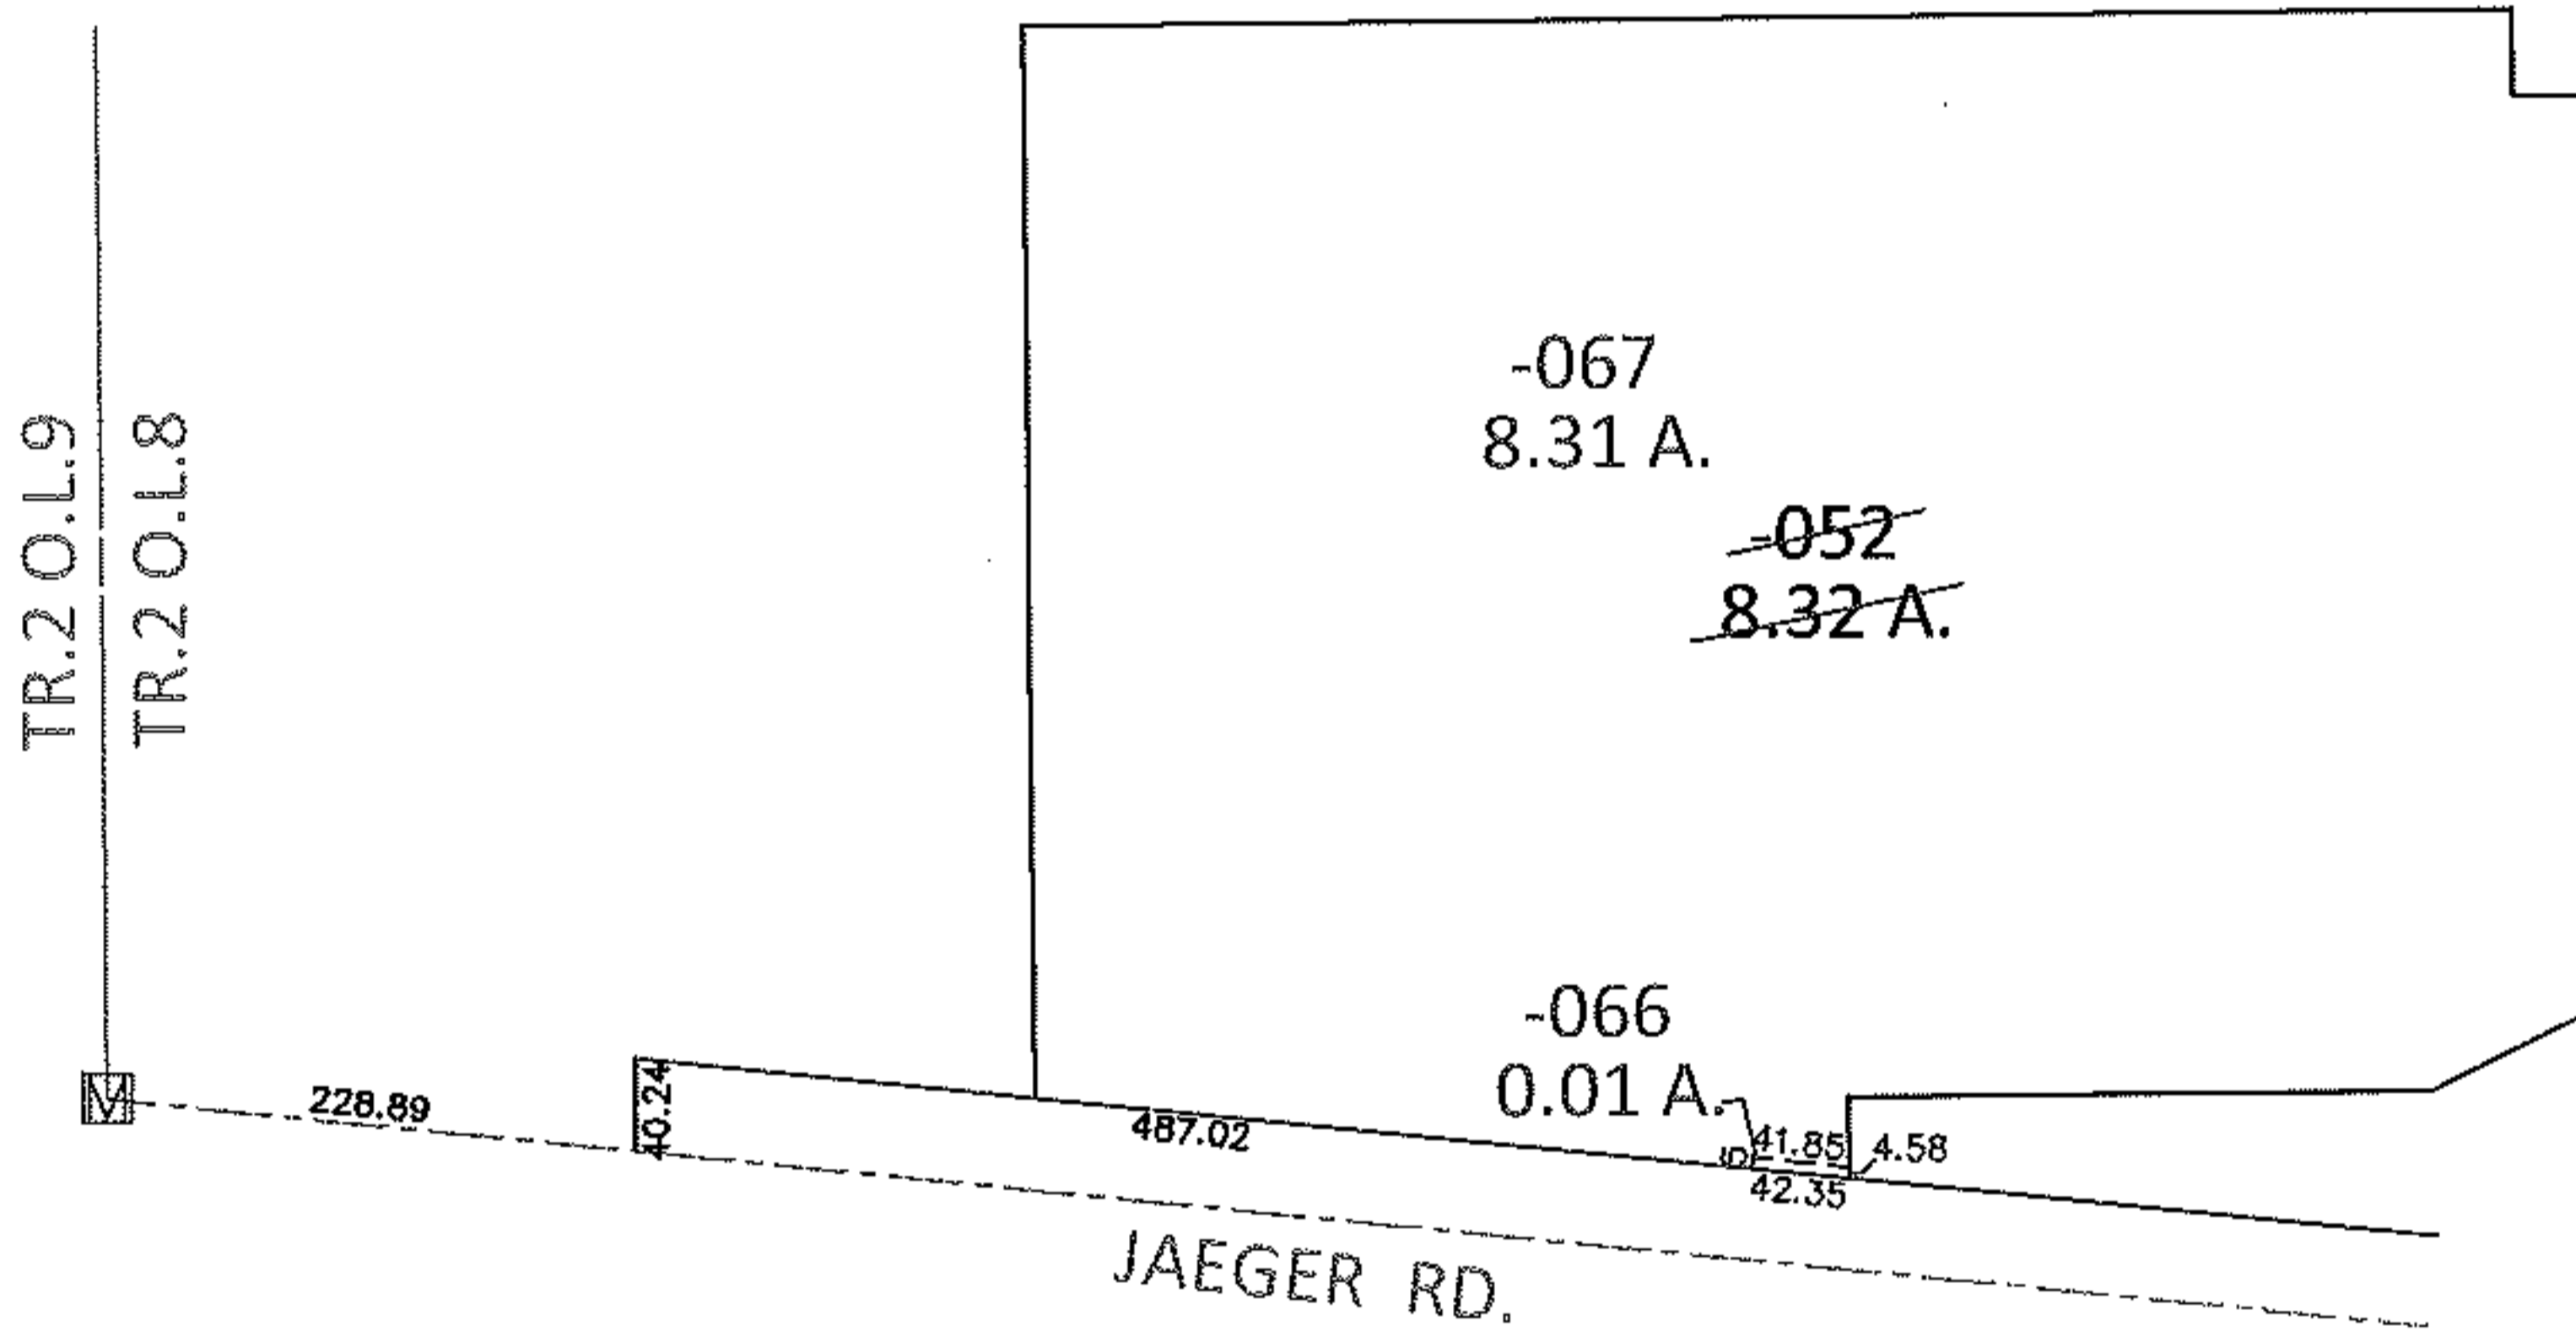


PARENT PARCEL: 02-02-008-107-052


CHILD PARCEL: 02-02-008-107-066, -067

13-00428

STARTING POINT: AT A MON BOX AT THE INTERSECTION OF C/L OF JAEGER RD. AND WEST LINE OF TR.2 O.L.8

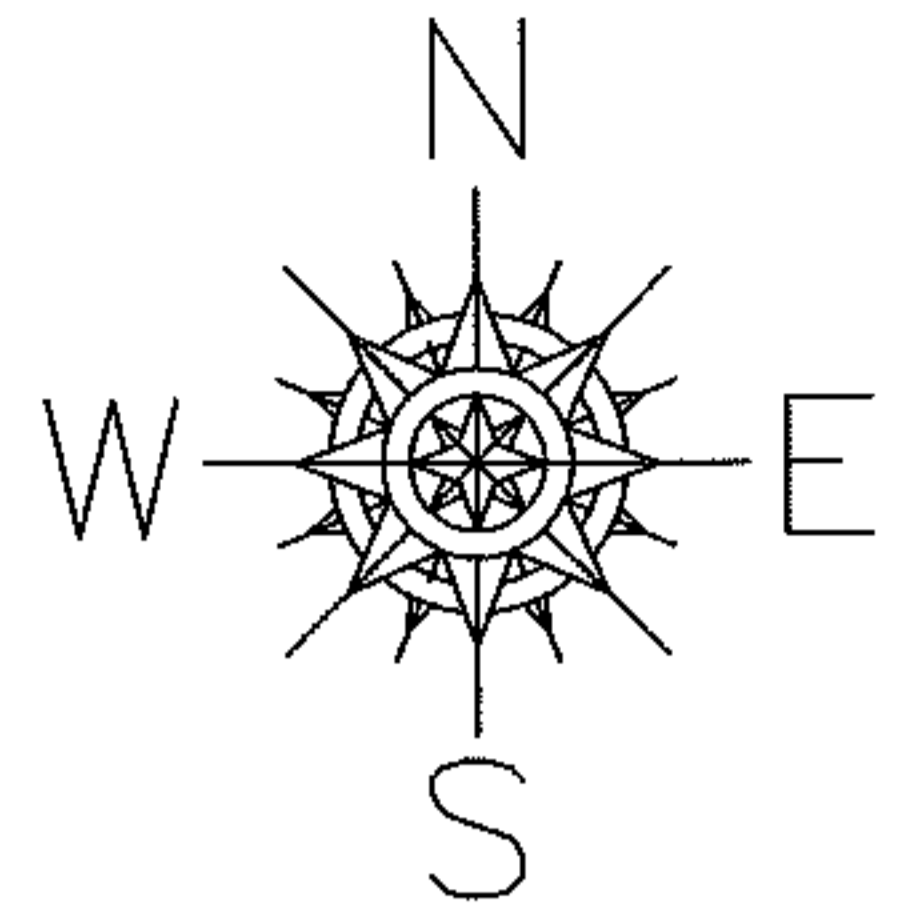

LOR-JAEGER RD.  
64 WD

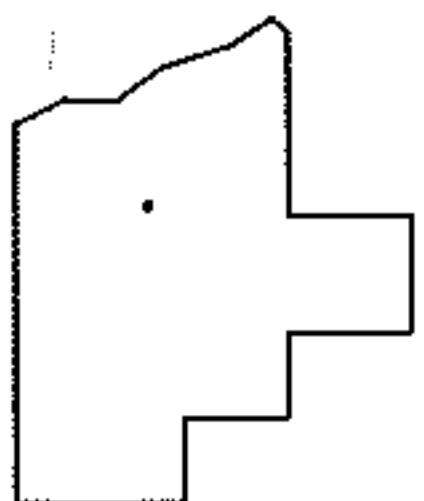

SPLITS/DEEDS PROCESSED

LORAIN COUNTY TAX MAP DEPARTMENT  
226 MIDDLE AVE. ELYRIA, OHIO

SURVEYED BY: TREVOR A. BIXLER  
CLOSURE: .00:10,000  
MAP PAGE(S): 2-02-008-A  
APPROVED BY: RRM DATE: 2-27-13  
SCALE: 1"= 200 PRIOR INST.: 20060138582