
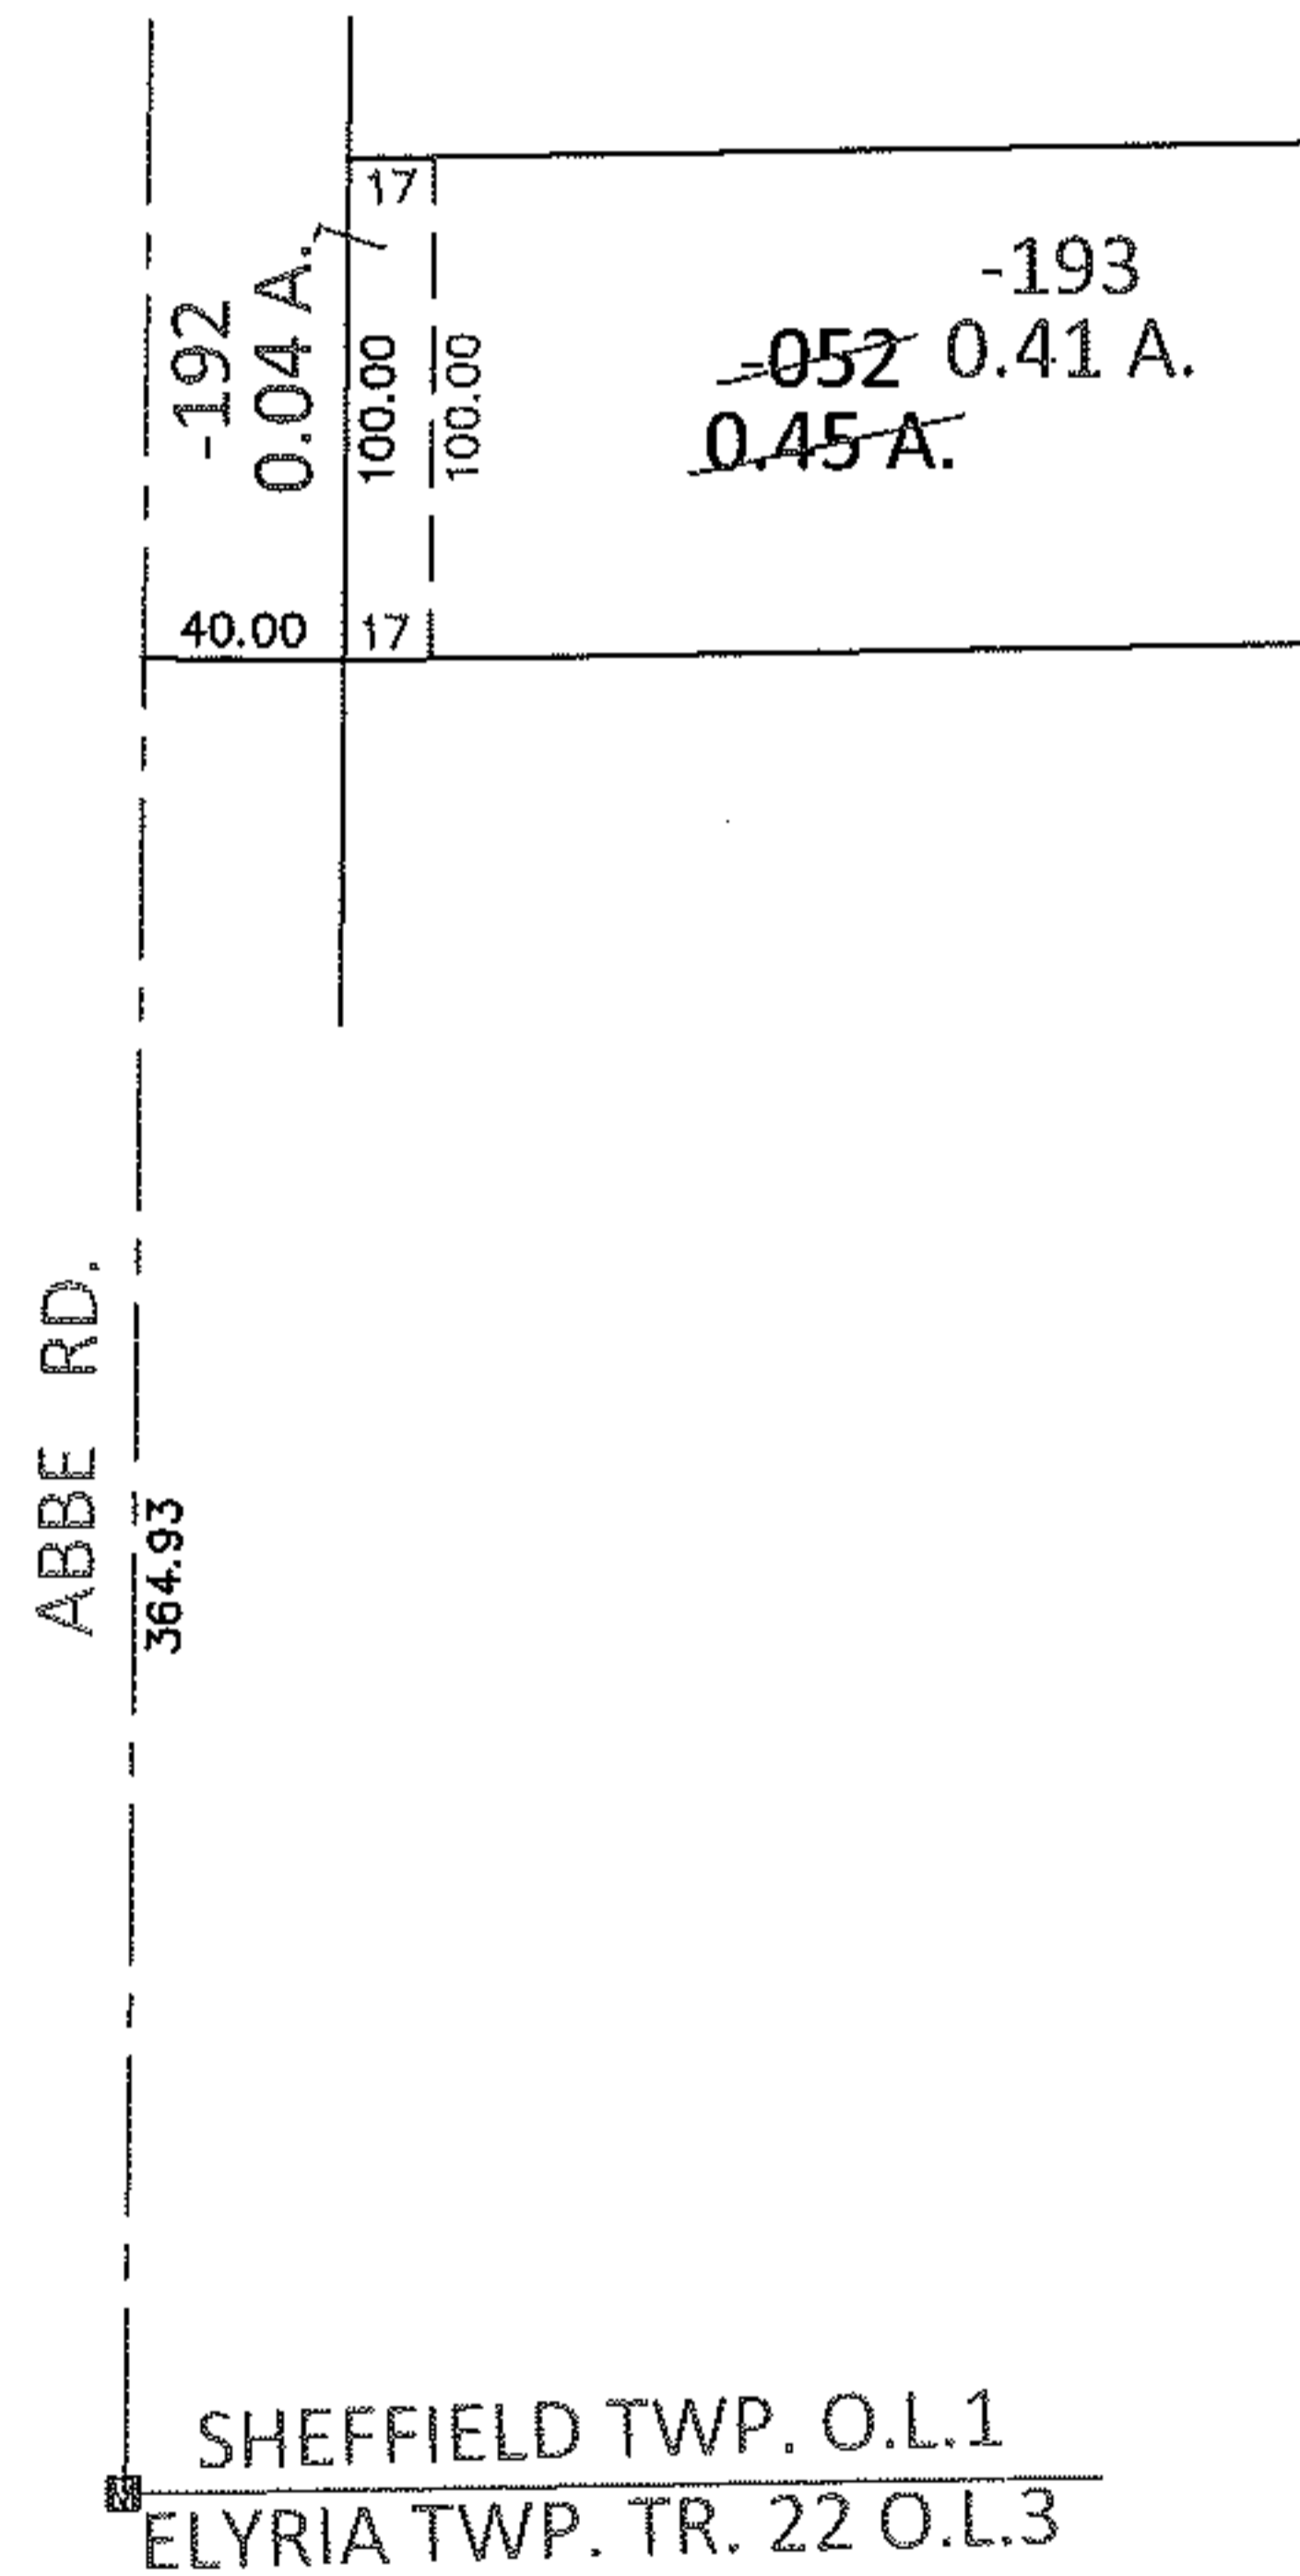


PARENT PARCEL: 03-00-001-000-052


CHILD PARCEL: 03-00-001-000-192, -193

13-00433

STARTING POINT: AT A MON BOX AT THE INTERSECTION OF C/L OF ABBE RD. AND SOUTH LINE OF O.L.1

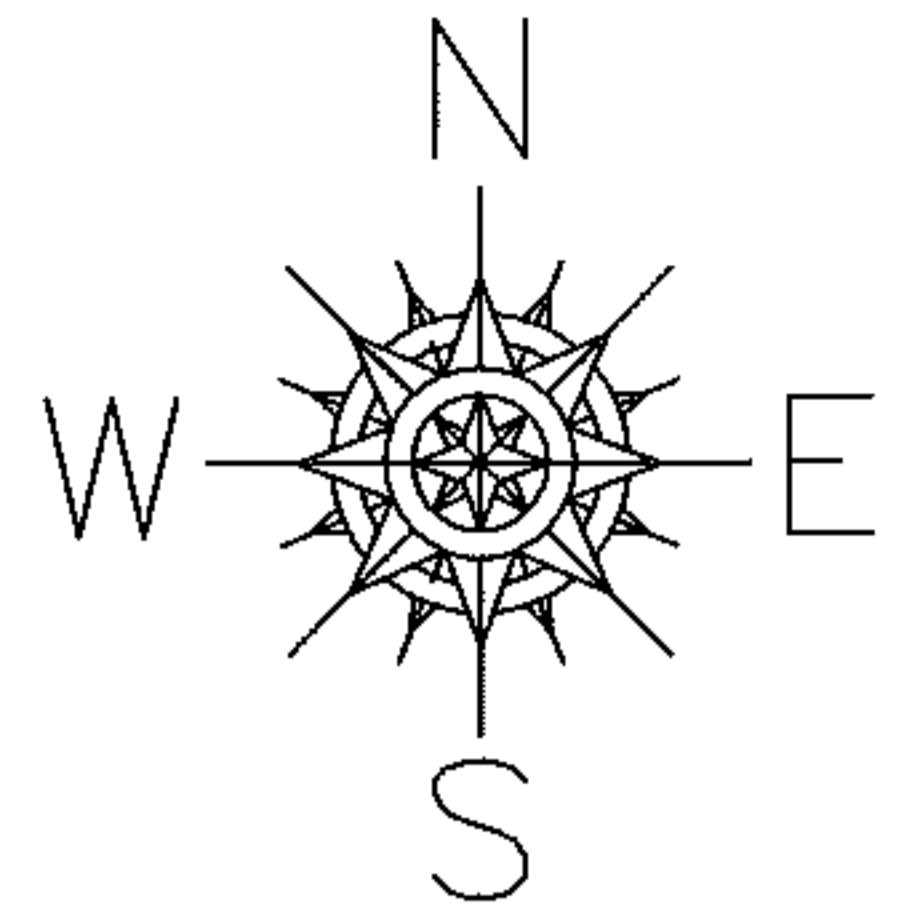

LOR-301-21.50
13-WD

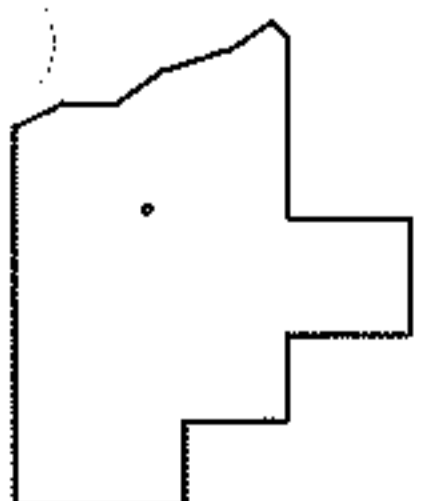

SPLITS/DEEDS PROCESSED

LORAIN COUNTY TAX MAP DEPARTMENT
226 MIDDLE AVE. ELYRIA, OHIO

SURVEYED BY: RICHARD JOHN SWAN

CLOSURE: .00:10,000

MAP PAGE(S): 3-00-001-A

APPROVED BY: RRM DATE: 4-5-13

SCALE: 1"= 100 PRIOR INST.: 19990641197