
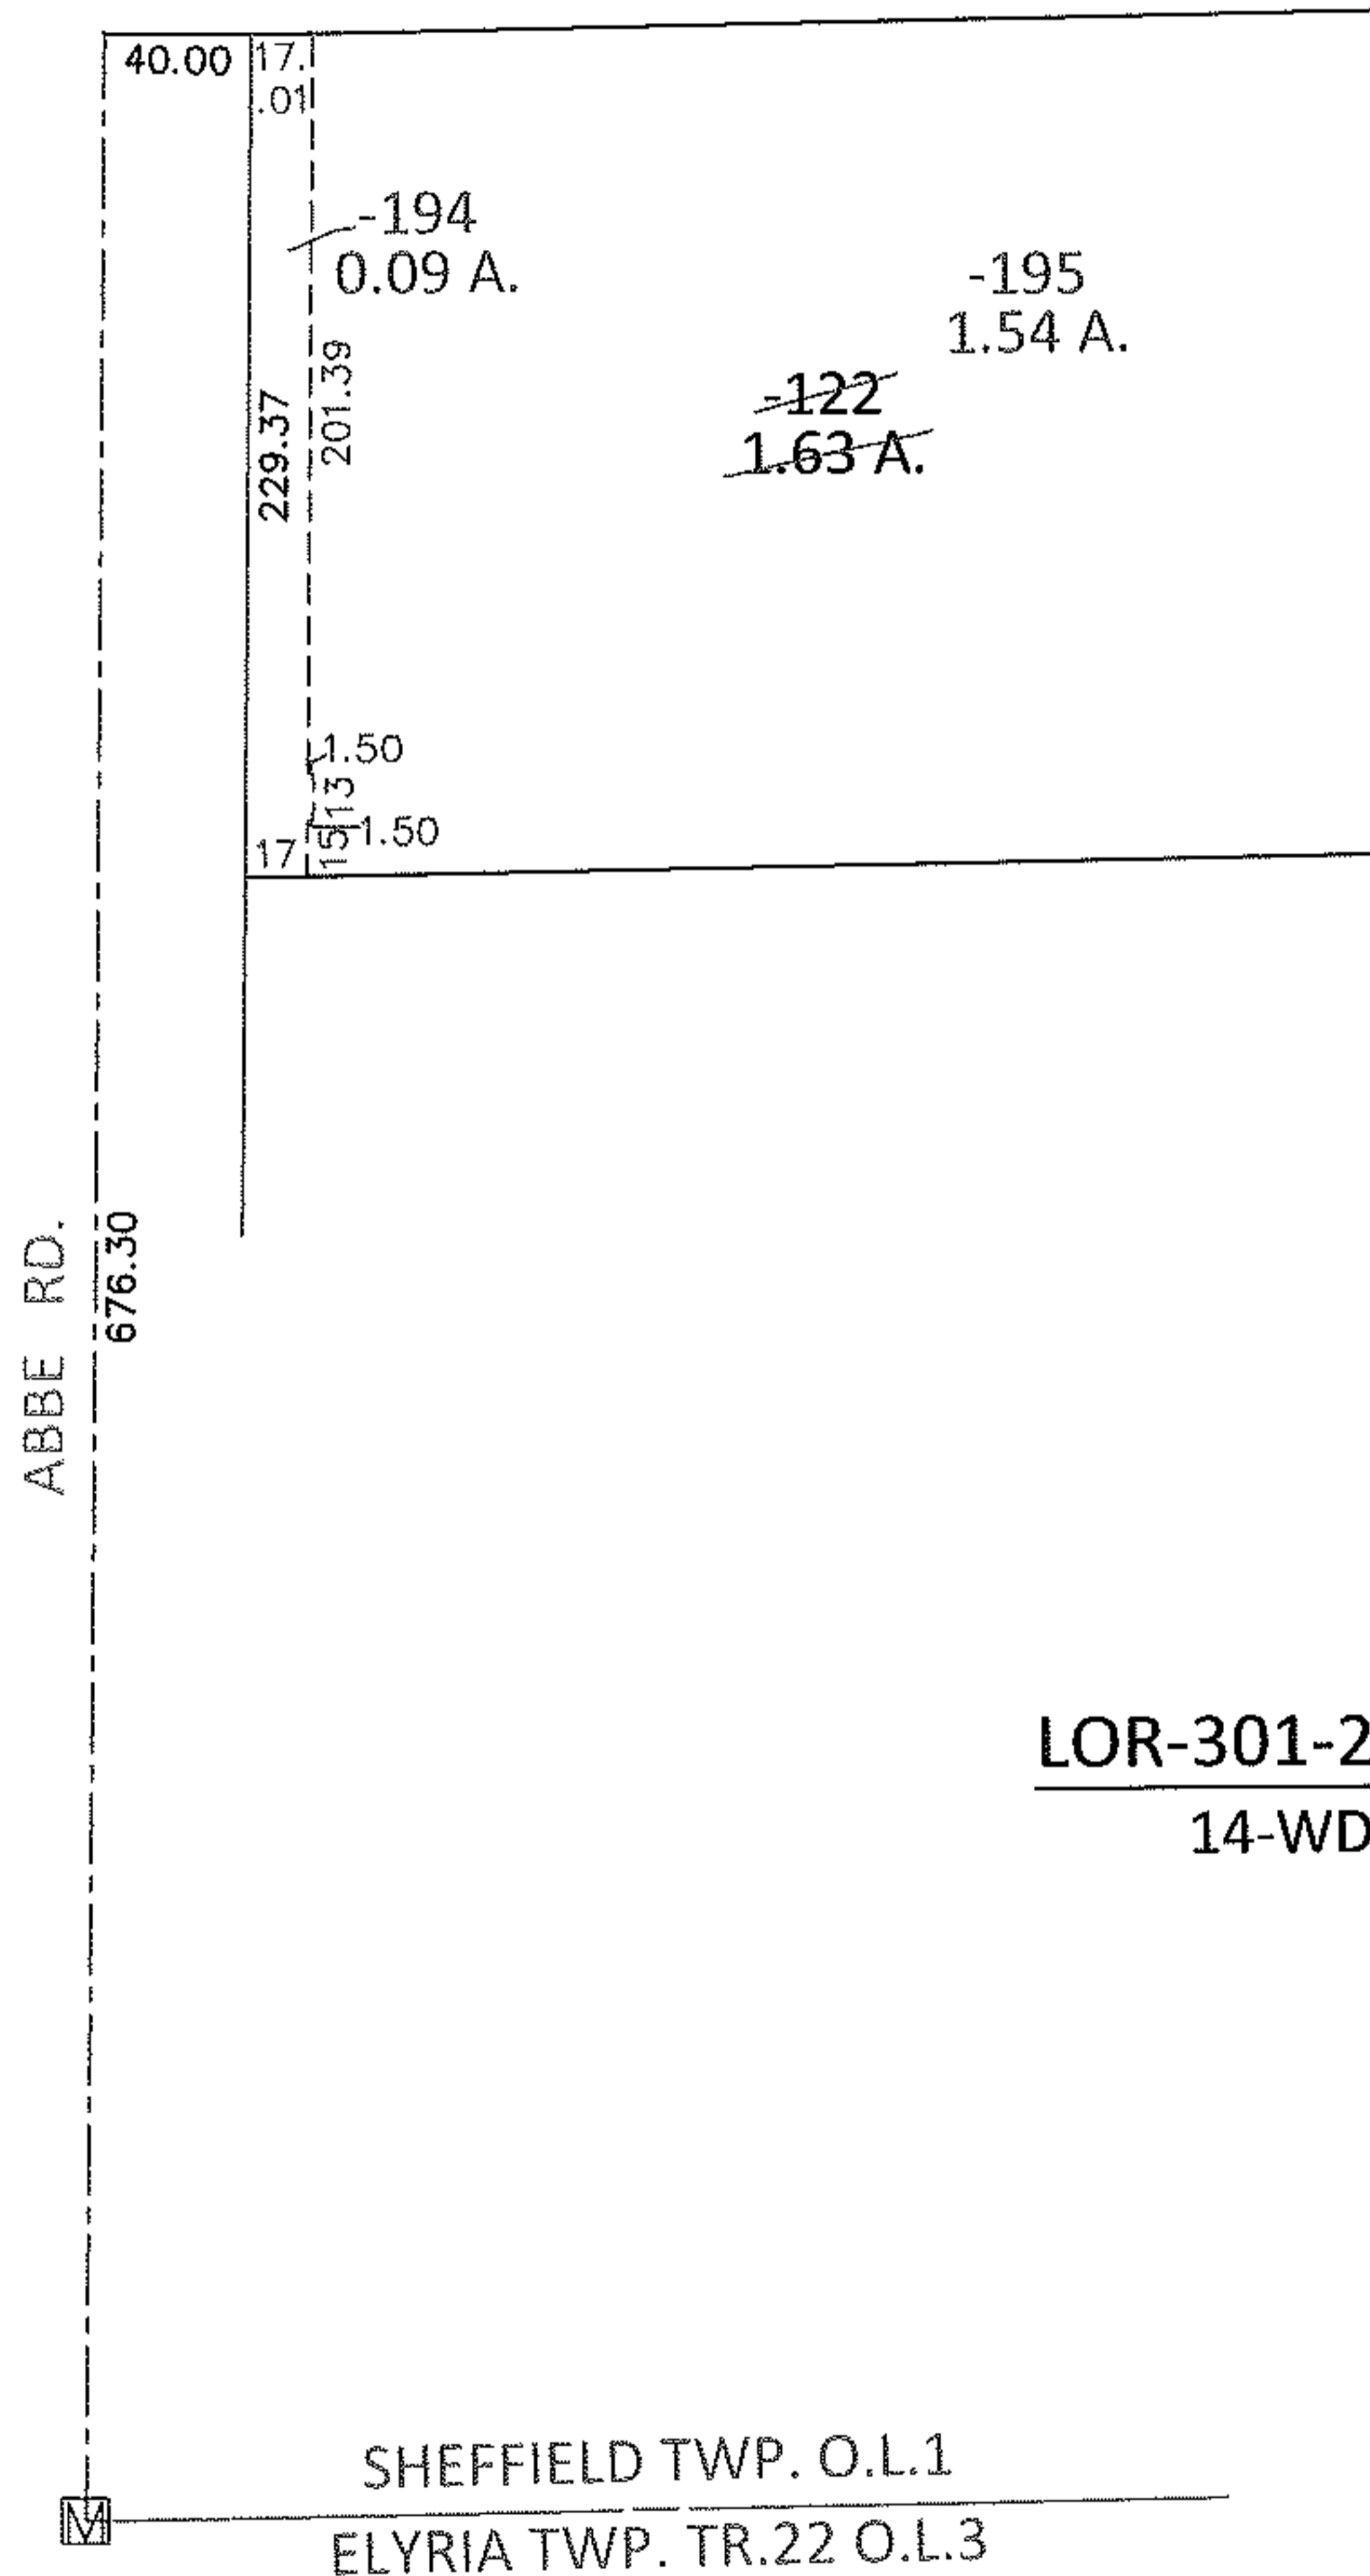


PARENT PARCEL: 03-00-001-000-122


CHILD PARCEL: 03-00-001-000-194, -195

13-00459

STARTING POINT: INTERSECTION OF C/L OF ABBE RD. AND SOUTH LINE OF O.L.1

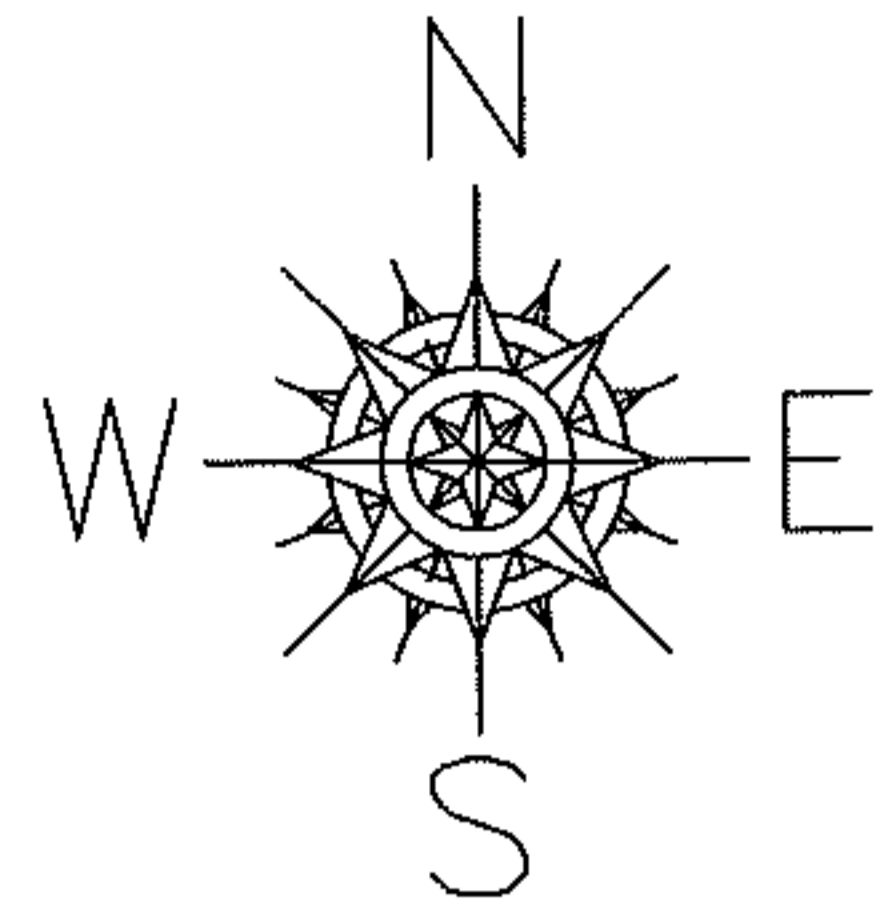

LOR-301-21.50
14-WD

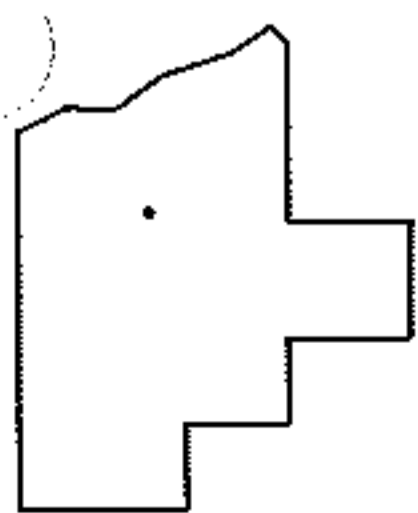

SPLITS/DEEDS PROCESSED

LORAIN COUNTY TAX MAP DEPARTMENT
226 MIDDLE AVE. ELYRIA, OHIO

SURVEYED BY: RICHARD JOHN SWAN

CLOSURE: .01:10,000

MAP PAGE(S): 3-00-001-A

APPROVED BY: RRM DATE: 7-12-13

SCALE: 1"= 100 PRIOR INST.: 20030970223