


PARENT PARCEL: 11-00-098-000-066
CHILD PARCEL: 11-00-098-000-282 & -283
STARTING POINT: CL OF GRAFTON RD. & SOUTH LINE OF EATON TWP. RD. (VACATED)

13-00464


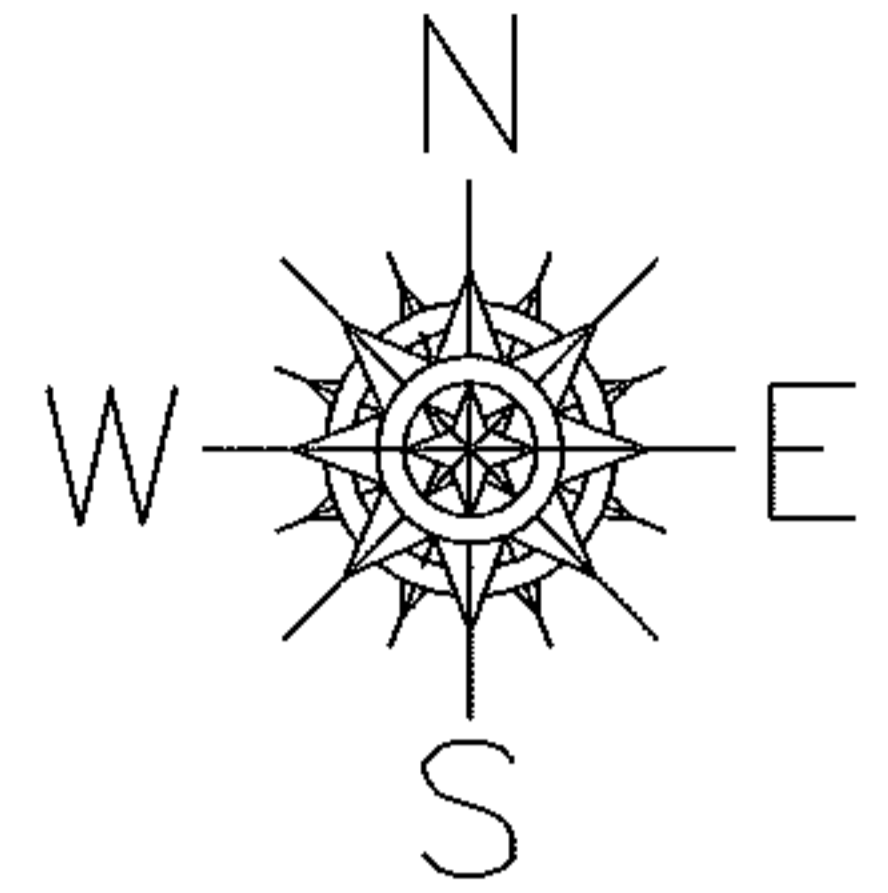


SURVEY BEFORE NEXT TRANSFER

11-00-098-000-283

1.67 A.

ACREAGE DOESN'T CALCULATE

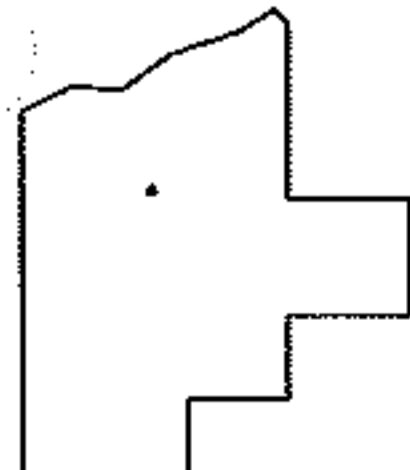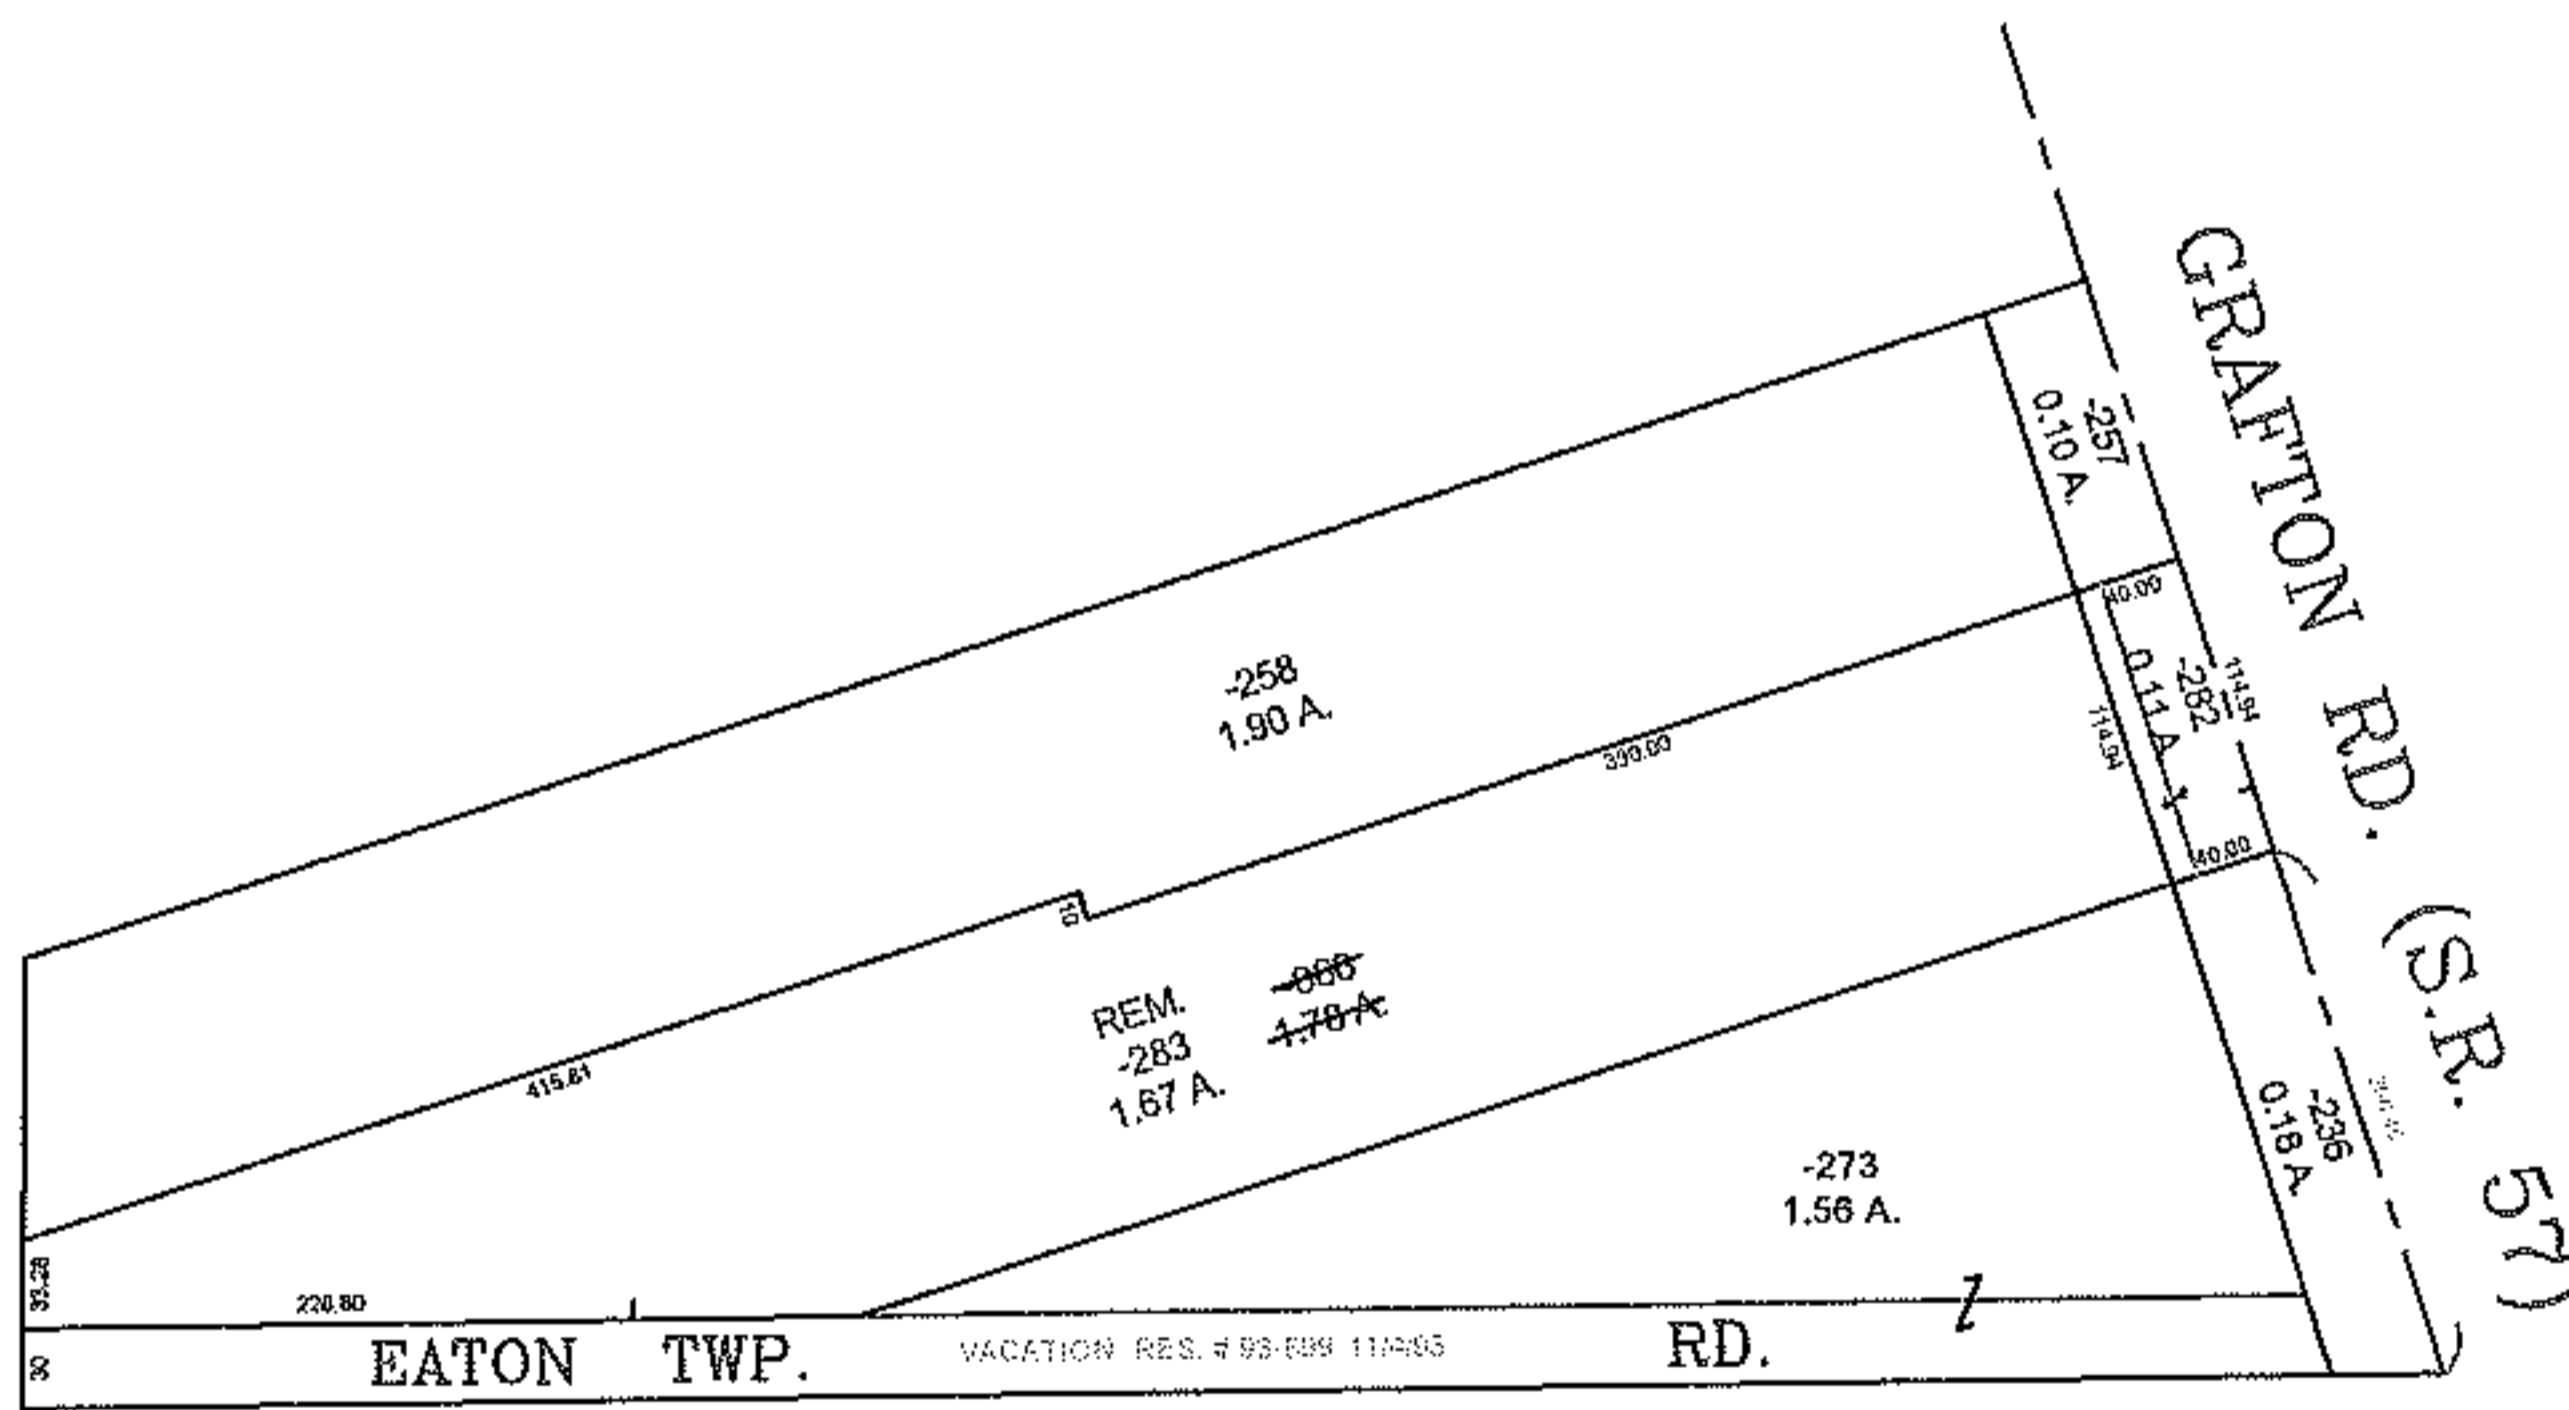

SPLITS/DEEDS PROCESSED
LORAIN COUNTY TAX MAP DEPARTMENT
226 MIDDLE AVE. ELYRIA, OHIO

SURVEYED BY: KENNETH C. DEAN JR.
CLOSURE: 0.01 : 10,000
MAP PAGE(S): 11-00-098
APPROVED BY: TJS DATE: 8/26/13
SCALE: 1" = 200' PRIOR INSTRUMENT: OR 1261/815