


PARENT PARCEL: 03-00-011-102-091

CHILD PARCEL: 03-00-011-102-136, -137

13-00466

STARTING POINT: AT A MON BOX AT THE INTERSECTION OF C/L OF S.R.254 AND C/L OF S.R.301


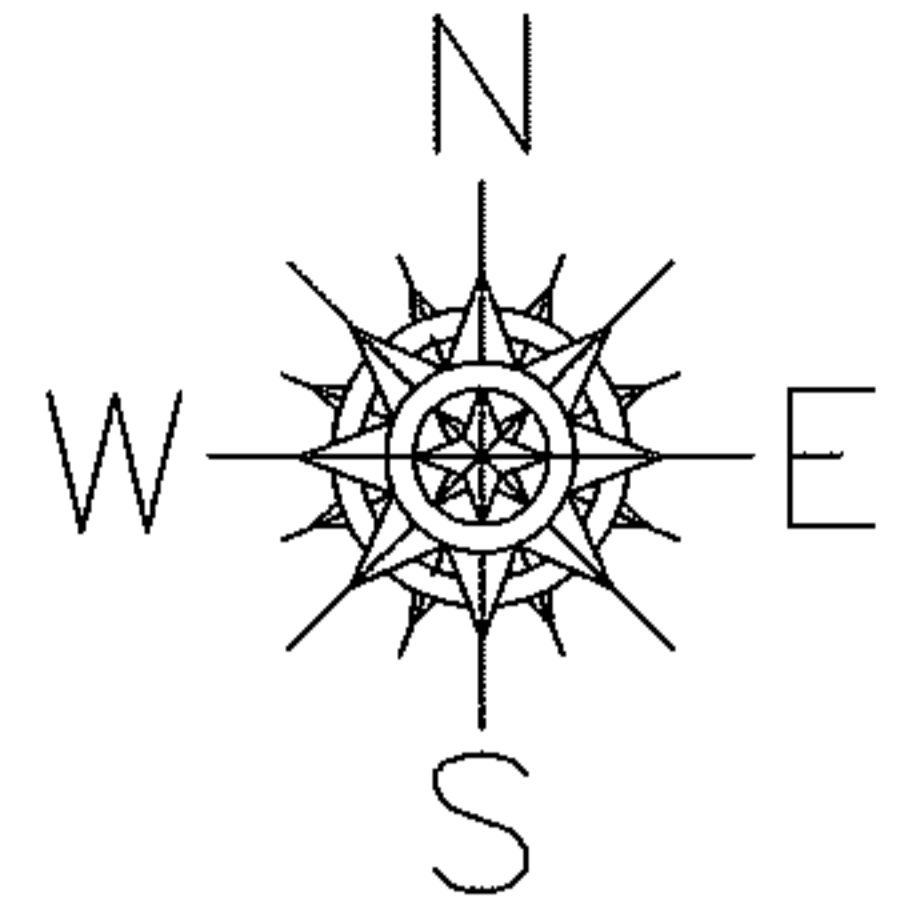


DETROIT RD. (S.R. 254)

LOR-301-21.50
27-WD

654.43

ABBE RD. (S.R. 301)

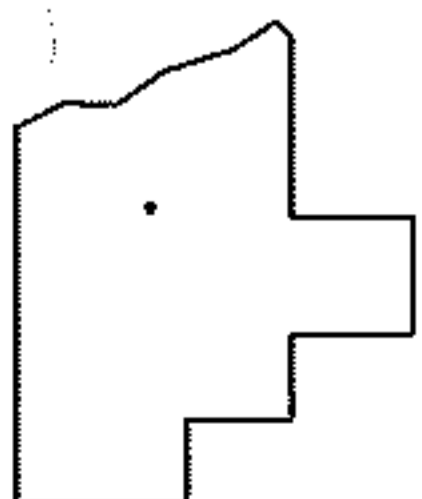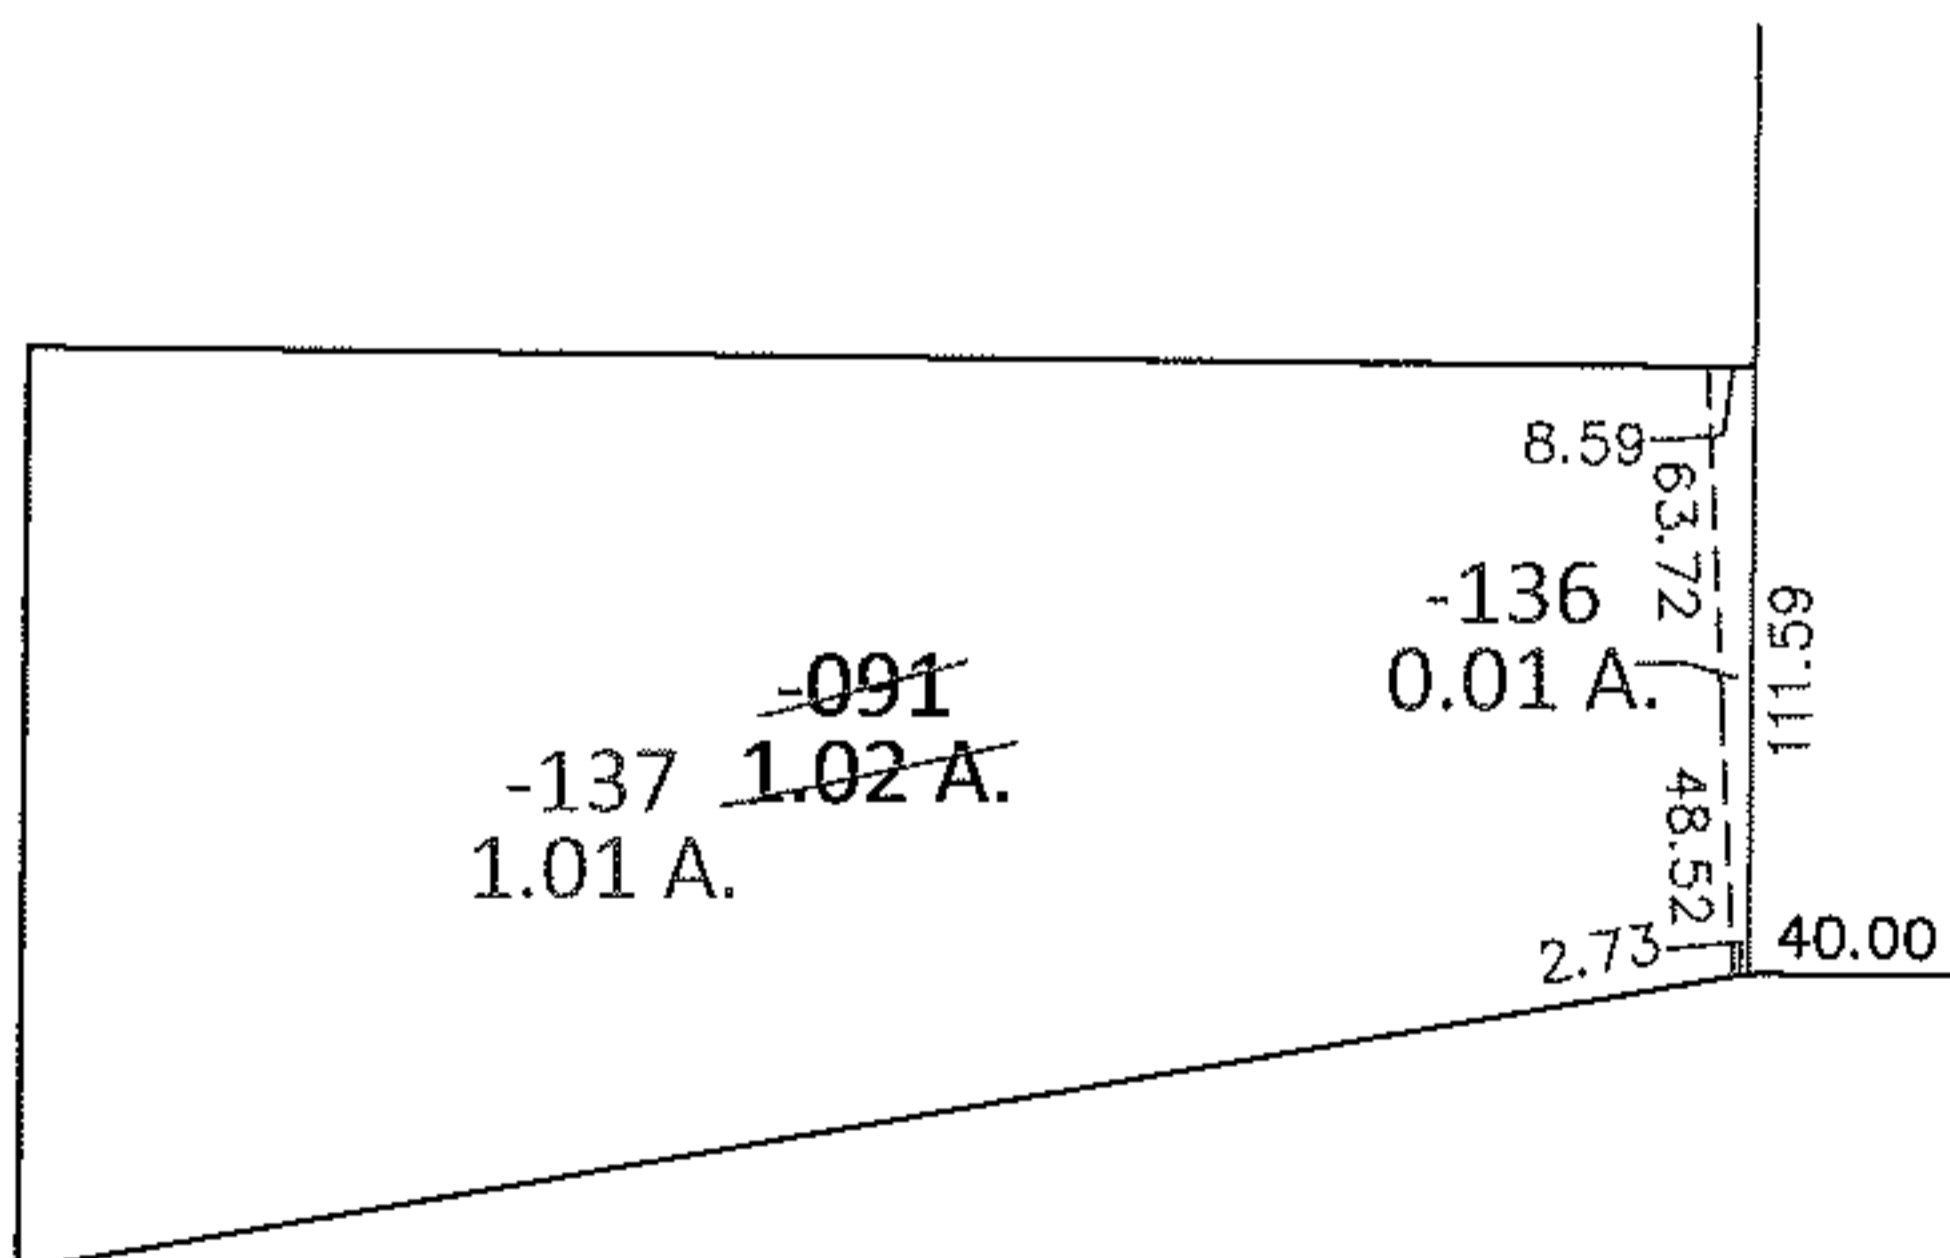

SPLITS/DEEDS PROCESSED

LORAIN COUNTY TAX MAP DEPARTMENT
226 MIDDLE AVE. ELYRIA, OHIO

SURVEYED BY: RICHARD JOHN SWAN

CLOSURE: .01:10,000

MAP PAGE(S): 3-00-011-B

APPROVED BY: RRM DATE: 10-9-13

SCALE: 1"= 100 PRIOR INST.: DV 1383/135