


PARENT PARCEL: 03-00-011-102-089

CHILD PARCEL: 03-00-011-102-138, -139


13-00467

STARTING POINT: AT A MON BOX AT THE INTERSECTION OF C/L OF S.R. 254 AND C/L OF S.R. 301

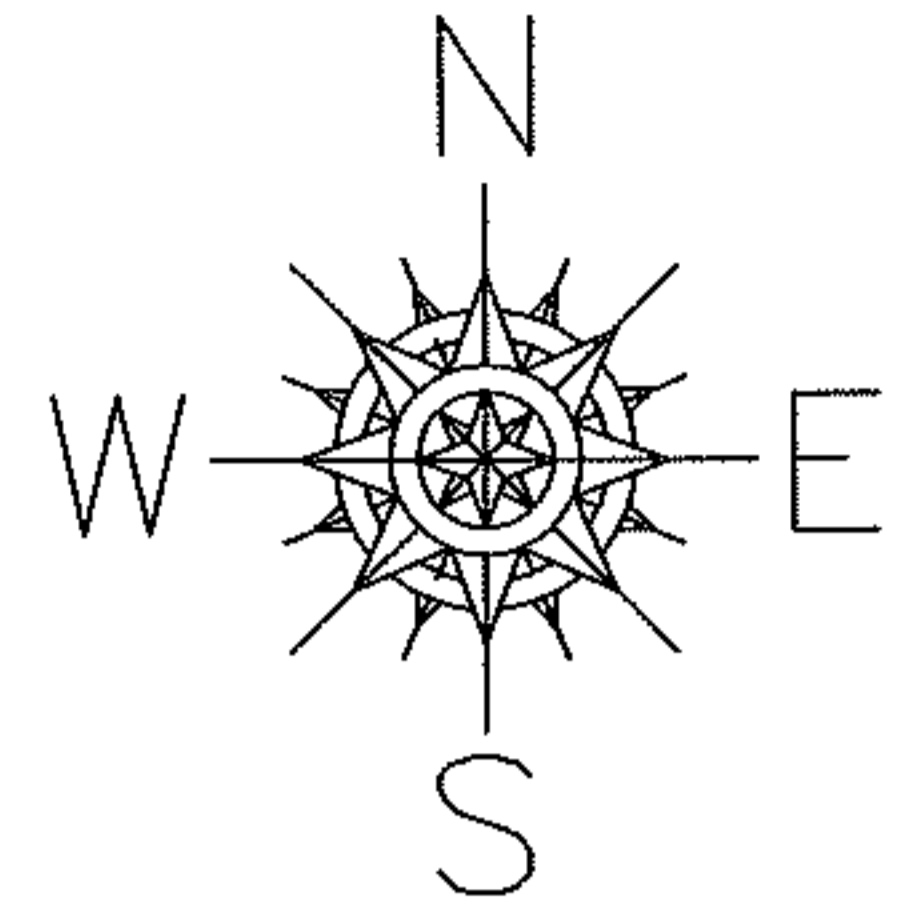

DETROIT RD. (S.R. 254)

337.16  
ABBE RD. (S.R. 301)

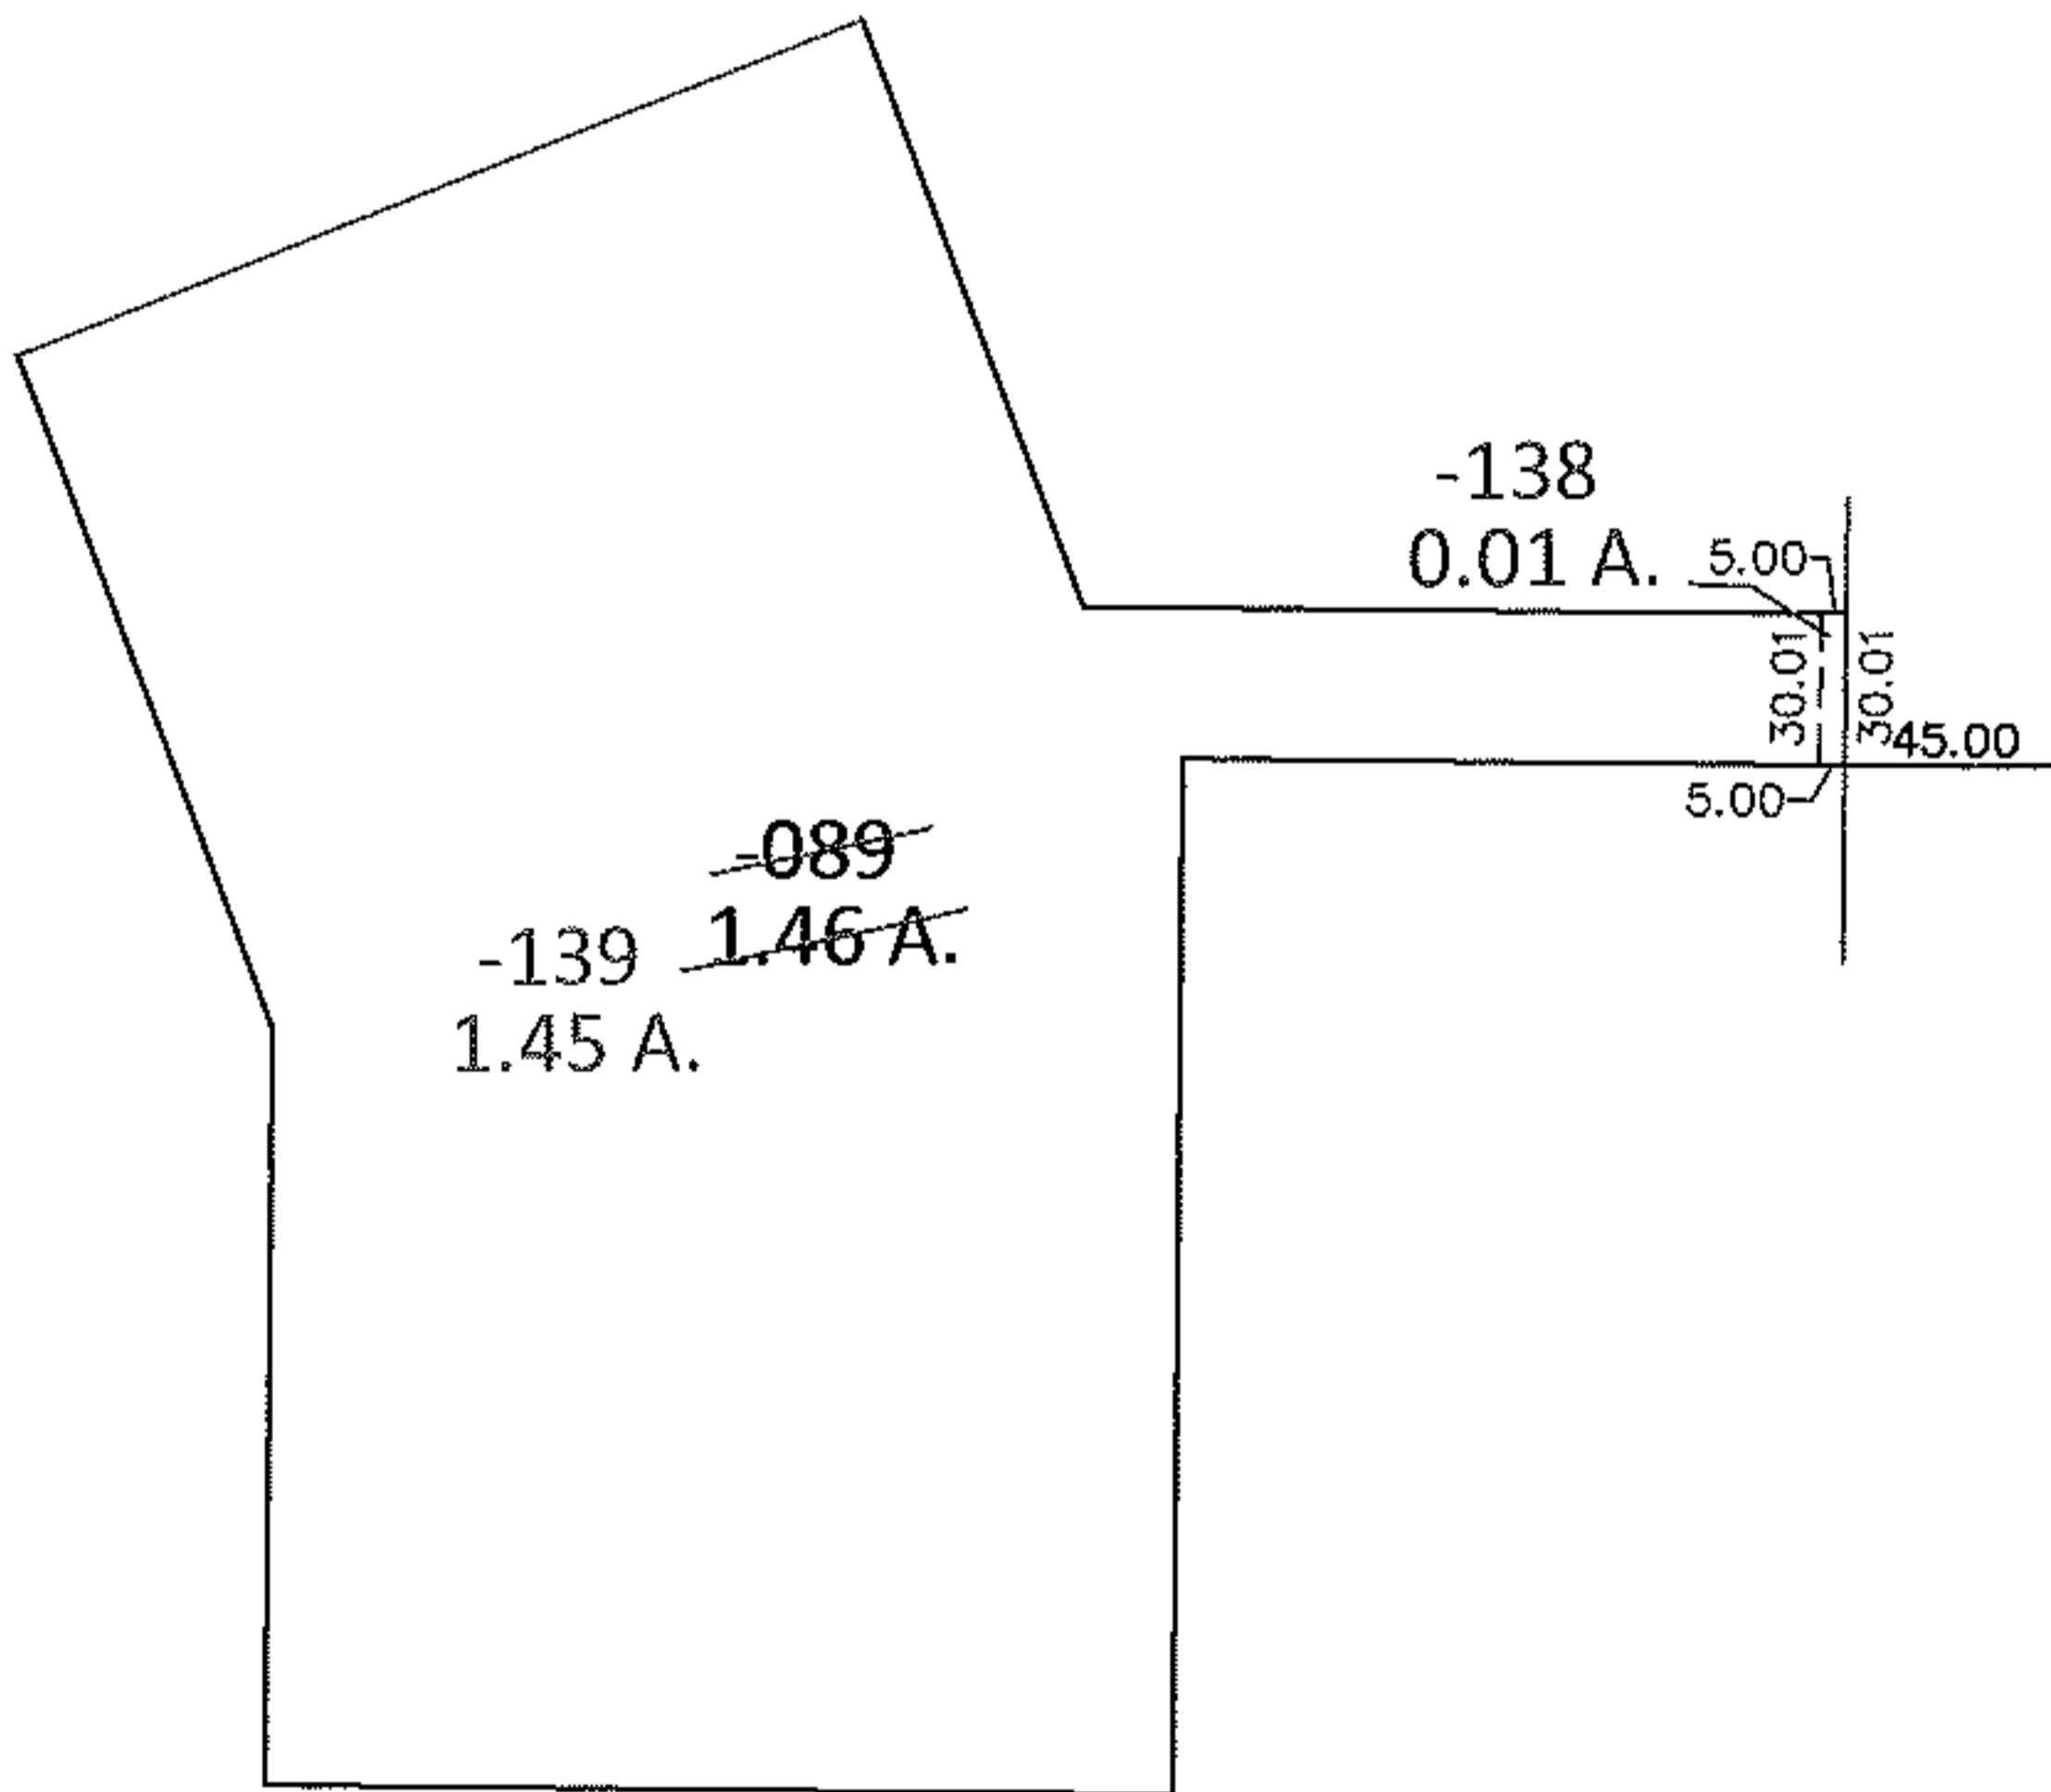


~~-089~~  
~~1.46 A.~~  
-139 1.45 A.

-138  
0.01 A. 5.00

30.01  
30.01  
45.00  
5.00

LOR-301-21.50  
31-WD

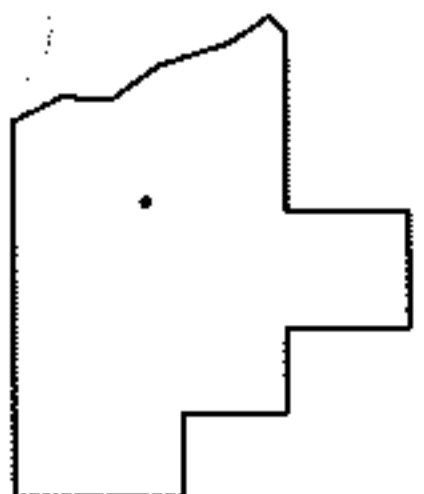

SPLITS/DEEDS PROCESSED

LORAIN COUNTY TAX MAP DEPARTMENT  
226 MIDDLE AVE. ELYRIA, OHIO

SURVEYED BY: RICHARD JOHN SWAN

CLOSURE: .00:10,000

MAP PAGE(S): 3-00-011-A

APPROVED BY: RRM DATE: 12-23-13

SCALE: 1"= 100 PRIOR INST.: DV 1379/361