

211	60 X 198	003
212	50 X 198	004
213	59 X 198	005
214	101 X 198	021
216	100 X 198	012
228	45 X 165	007
227	80 X 165	020
226	50 X 165	019
226	10 X 165	018
225	40 X 165	017
225	40 X 165	016
224	40 X 165	015
223	60 X 165	014

158
33
198


NOV 26 1979

#13002

APPROVED
LORAIN CO.
MAP DEPT.
DATE 8-20-79
PAGE 2-01-004B
BY <i>[Signature]</i>
VOID AFTER

- 1 LORAIN CITY ORDINANCE NUMBER 19-79 4th Street Vacation
- 2 LORAIN CITY ORDINANCE NUMBER 20 79 Alley Vacation
- 3 LORAIN CITY ORDINANCE NUMBER 18 79 REID AVENUE VACATION

#13002

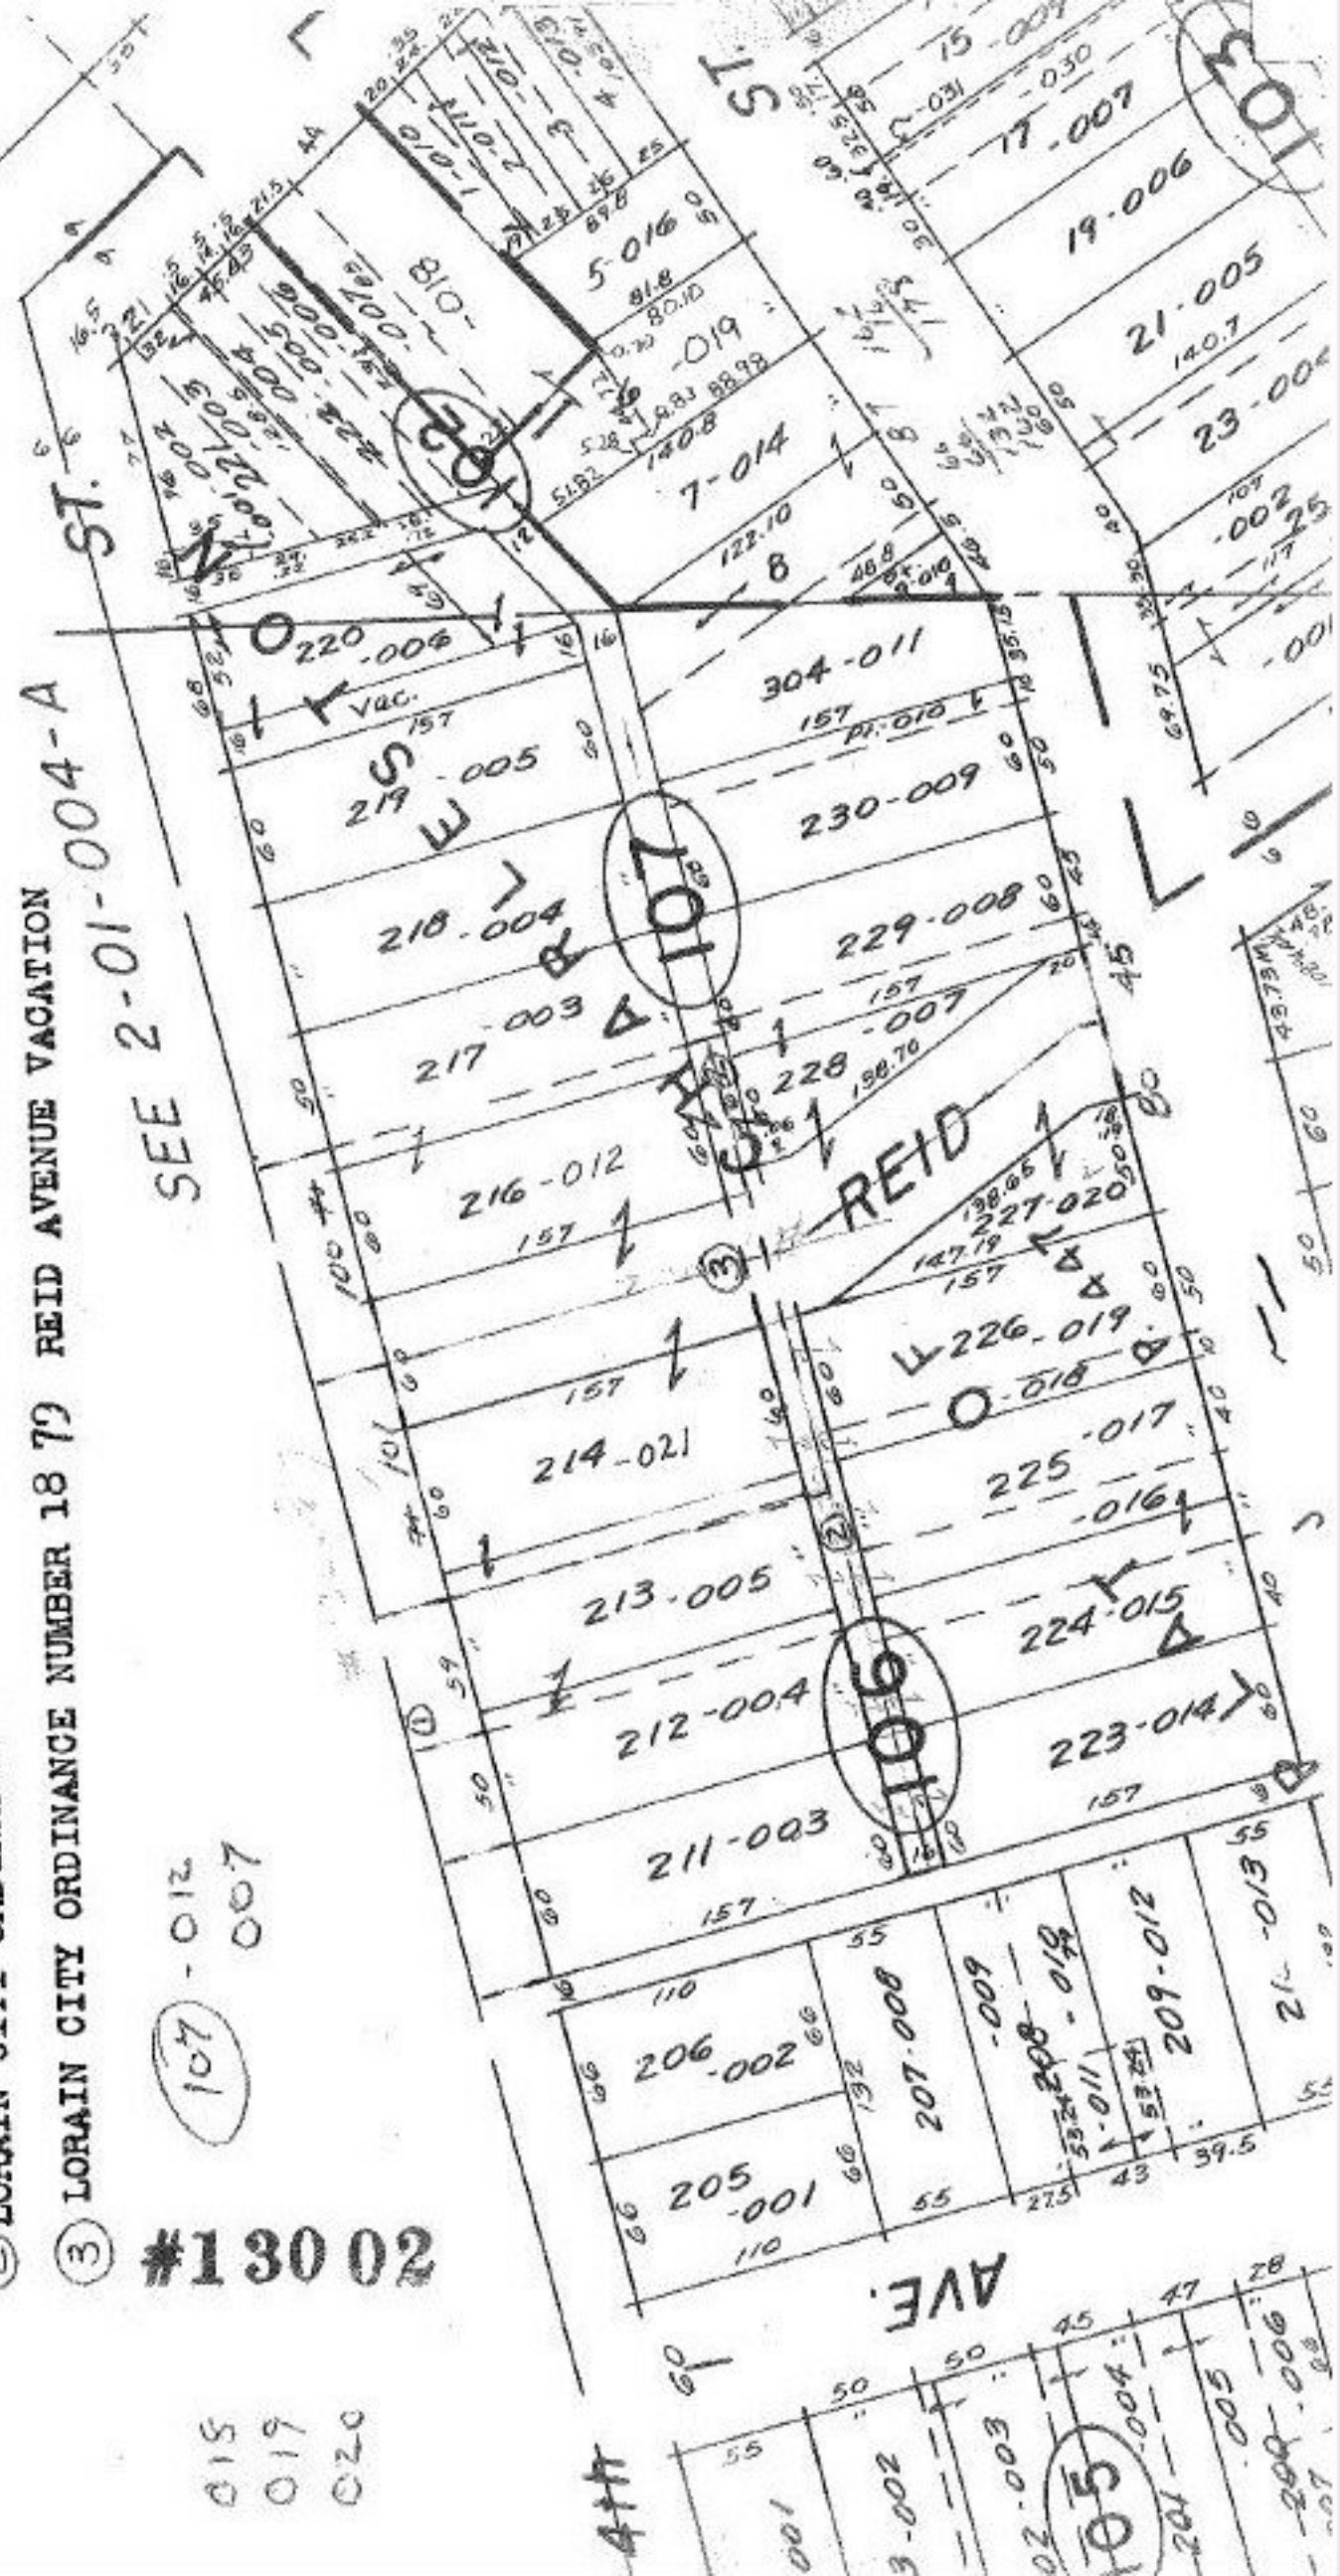

- 003 ✓
- 004 ✓
- 005 ✓
- 021 ✓
- 014 ✓
- 015 ✓
- 016 ✓
- 017 ✓

- 018
- 019
- 020

107 - 012
007

106

107

108