


NOV 26 1979

[Handwritten signature]

#13020
 APPROVED.
 LORAIN CO.
 MAP DEPT.
 DATE 8-23-79
 PAGE 2-02-017-14
 BY *[Handwritten signature]*
 VOID AFTER

SEE 2-02-024-A

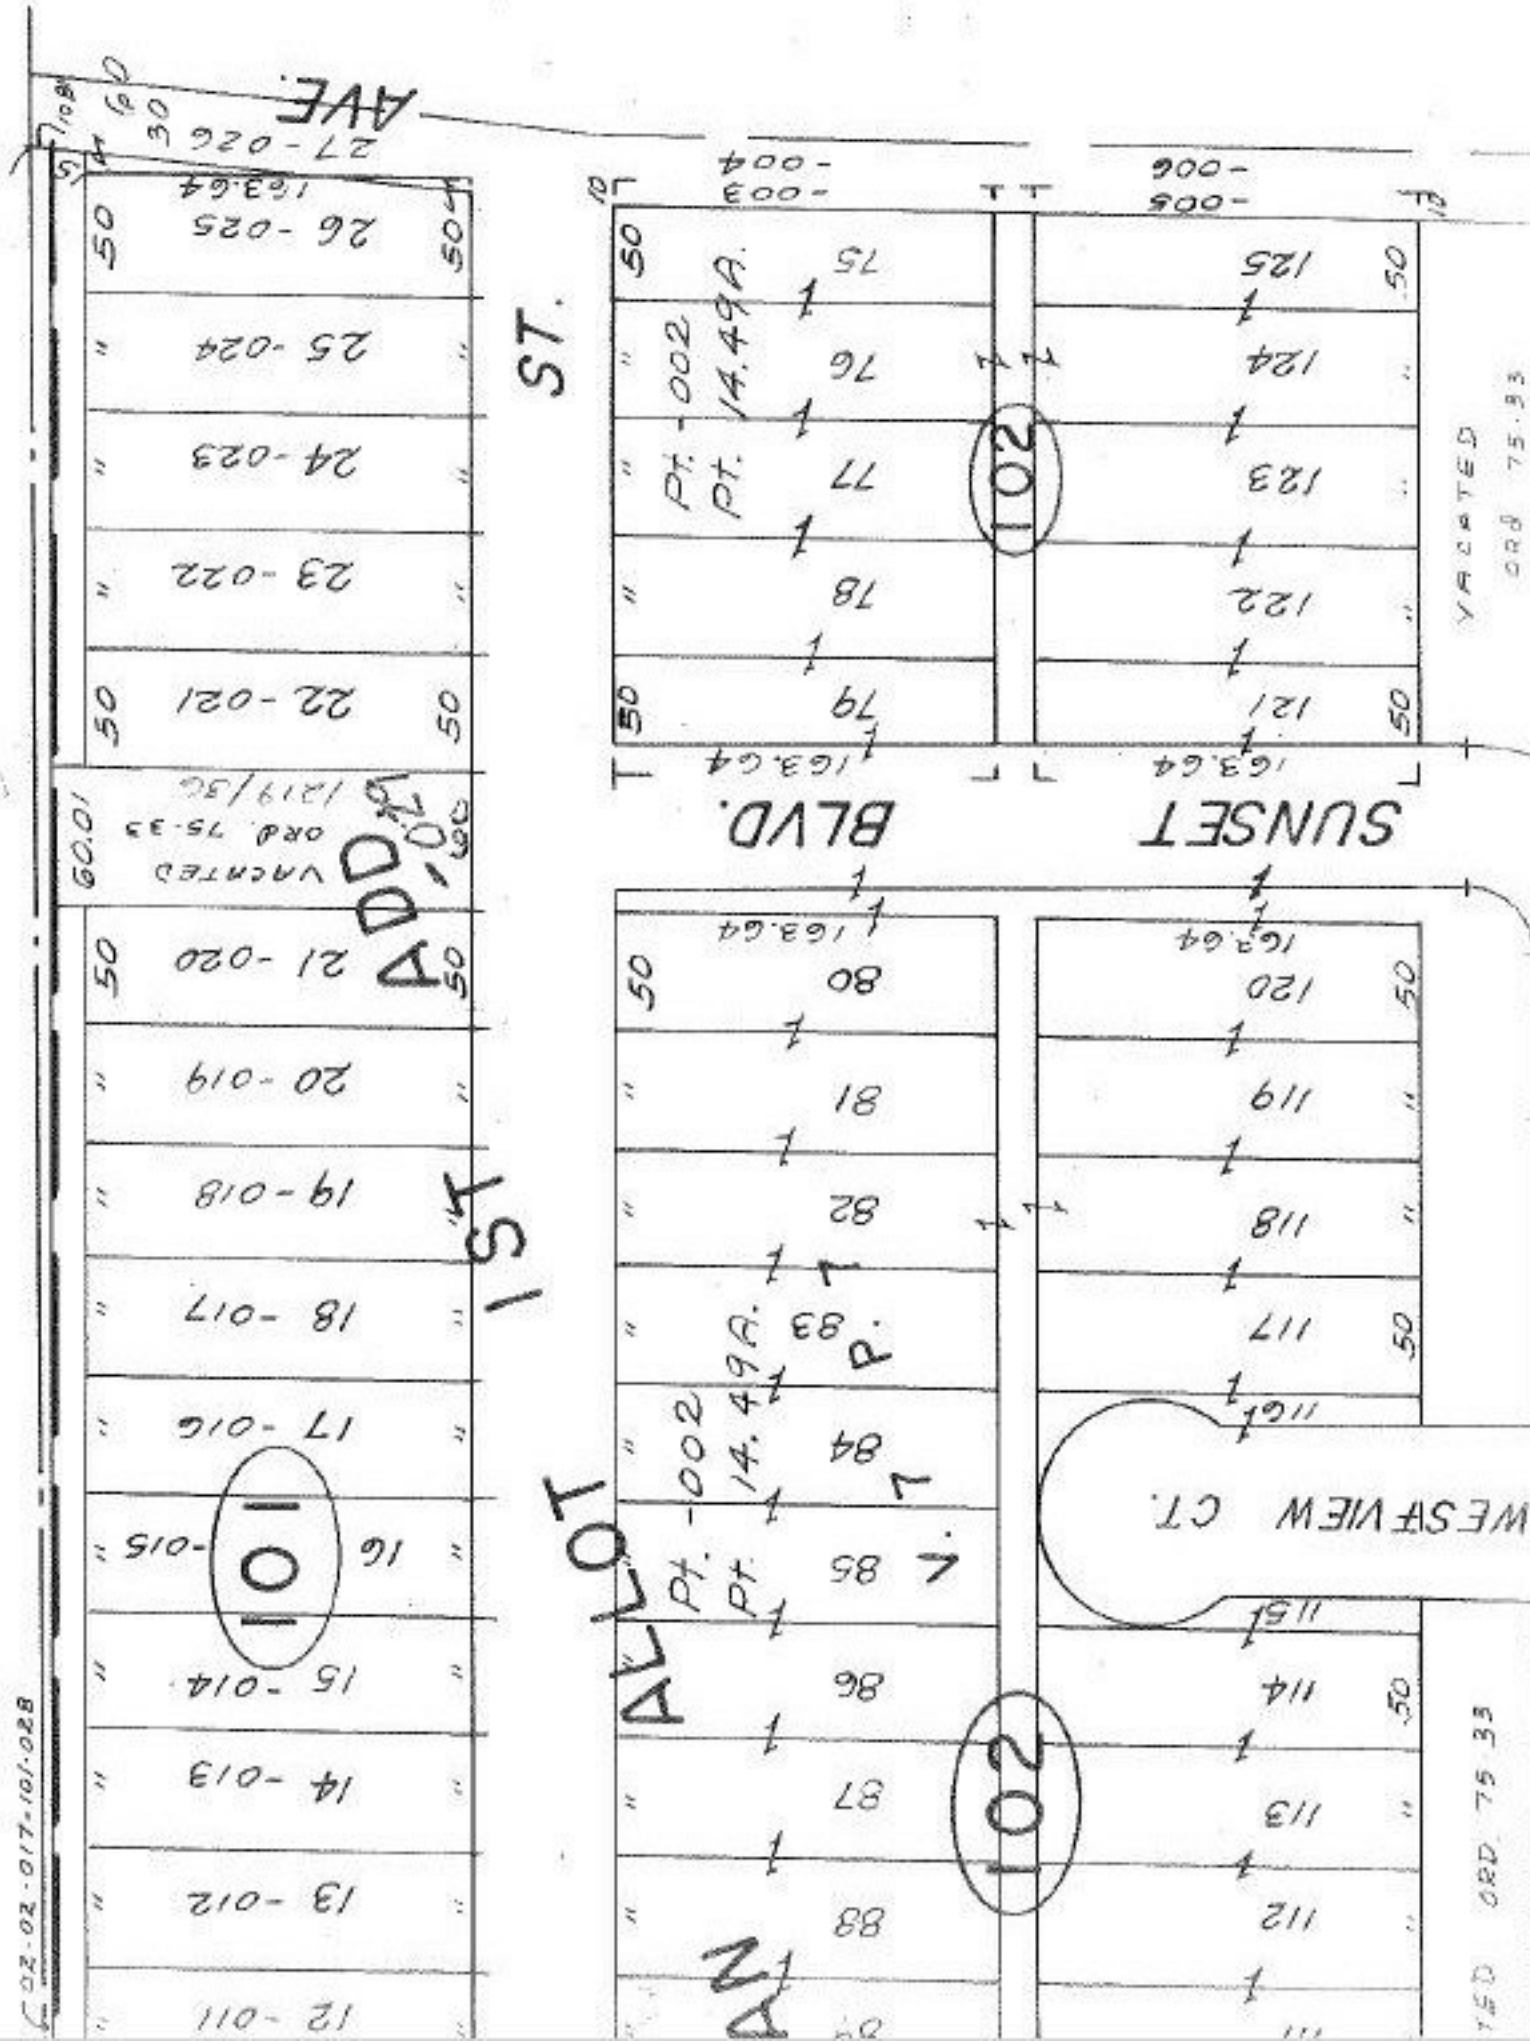

C-02-02-017-101-028