

#13025

85.70

| | |
|---------------|------------|
| #13025 | |
| APPROVED | |
| LORAIN CO. | |
| MAP DEPT. | |
| DATE | 8-27-79 |
| PAGE | A-00-011-E |
| BY | T. McMan |
| VOID AFTER | |

Pt -109
Pt 34.47A.

1.23
-57


.66
57

123

NOV 23 1979

13088

-050
.90 A.

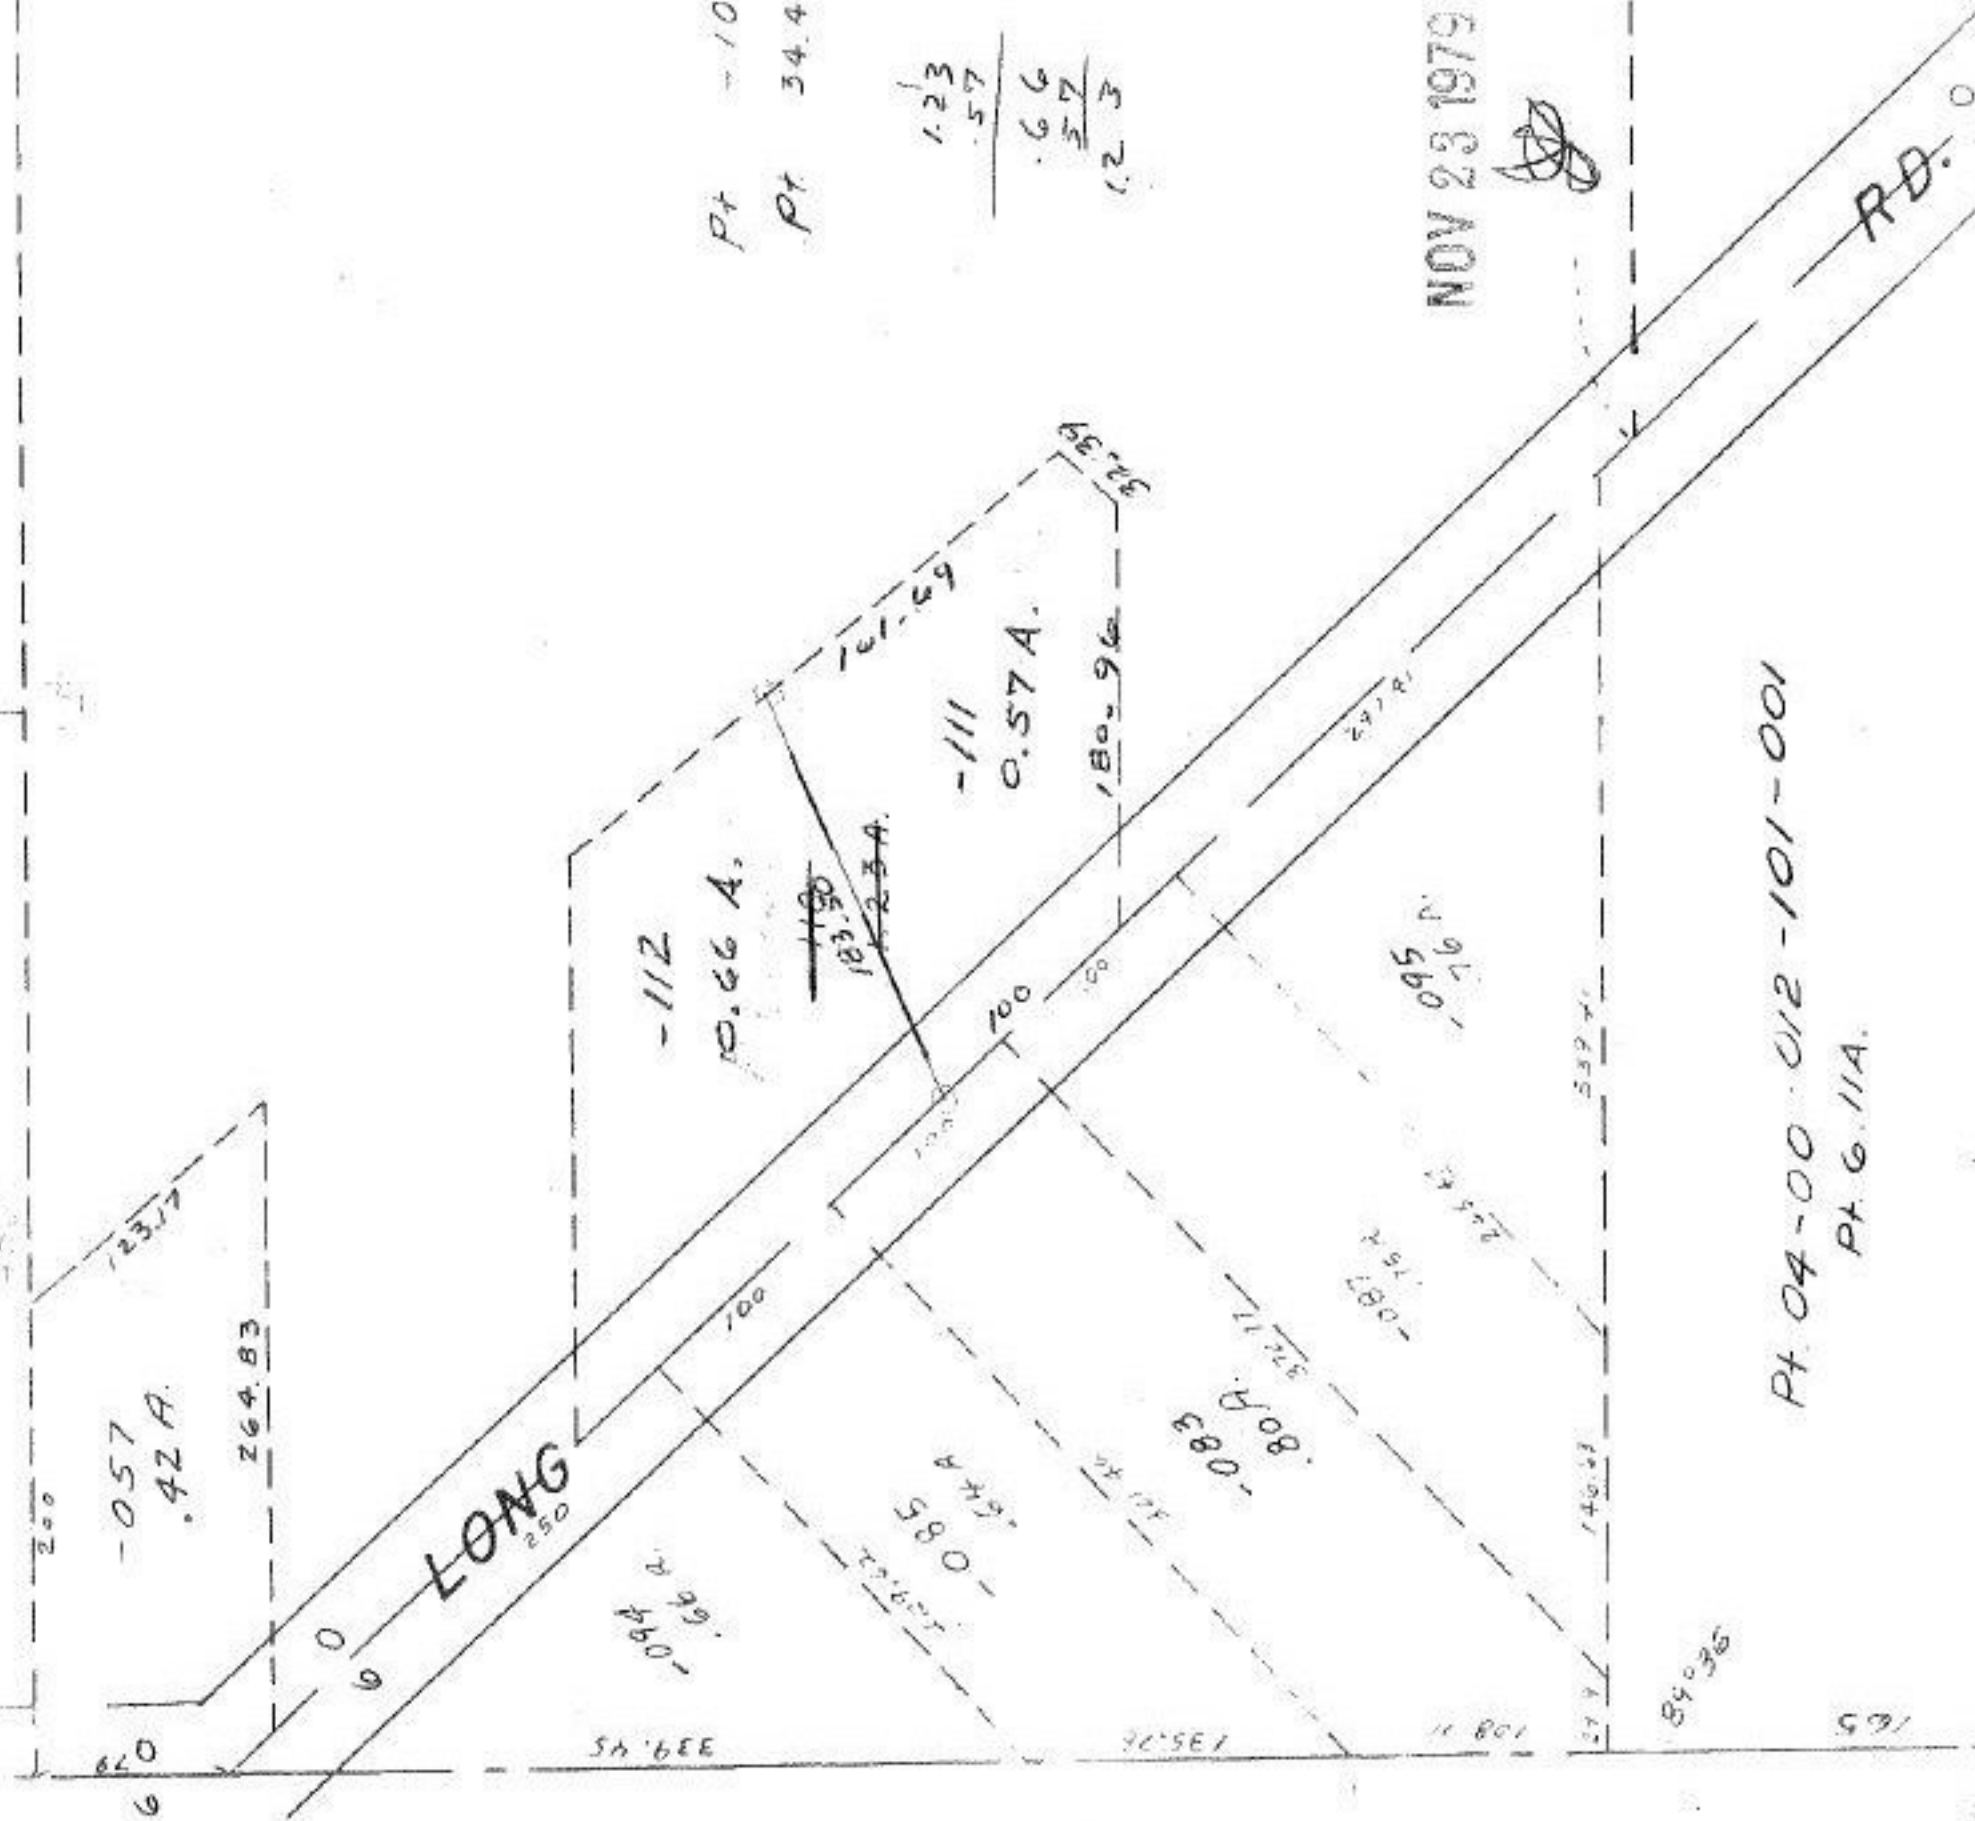

Pt. 04-00-012-101-001
Pt. 6.11A.

RD. 0