


~~034~~
25.93 A
01-00-006-101-036
~~044~~
14.30 A

101



ELAND SANDUSKY

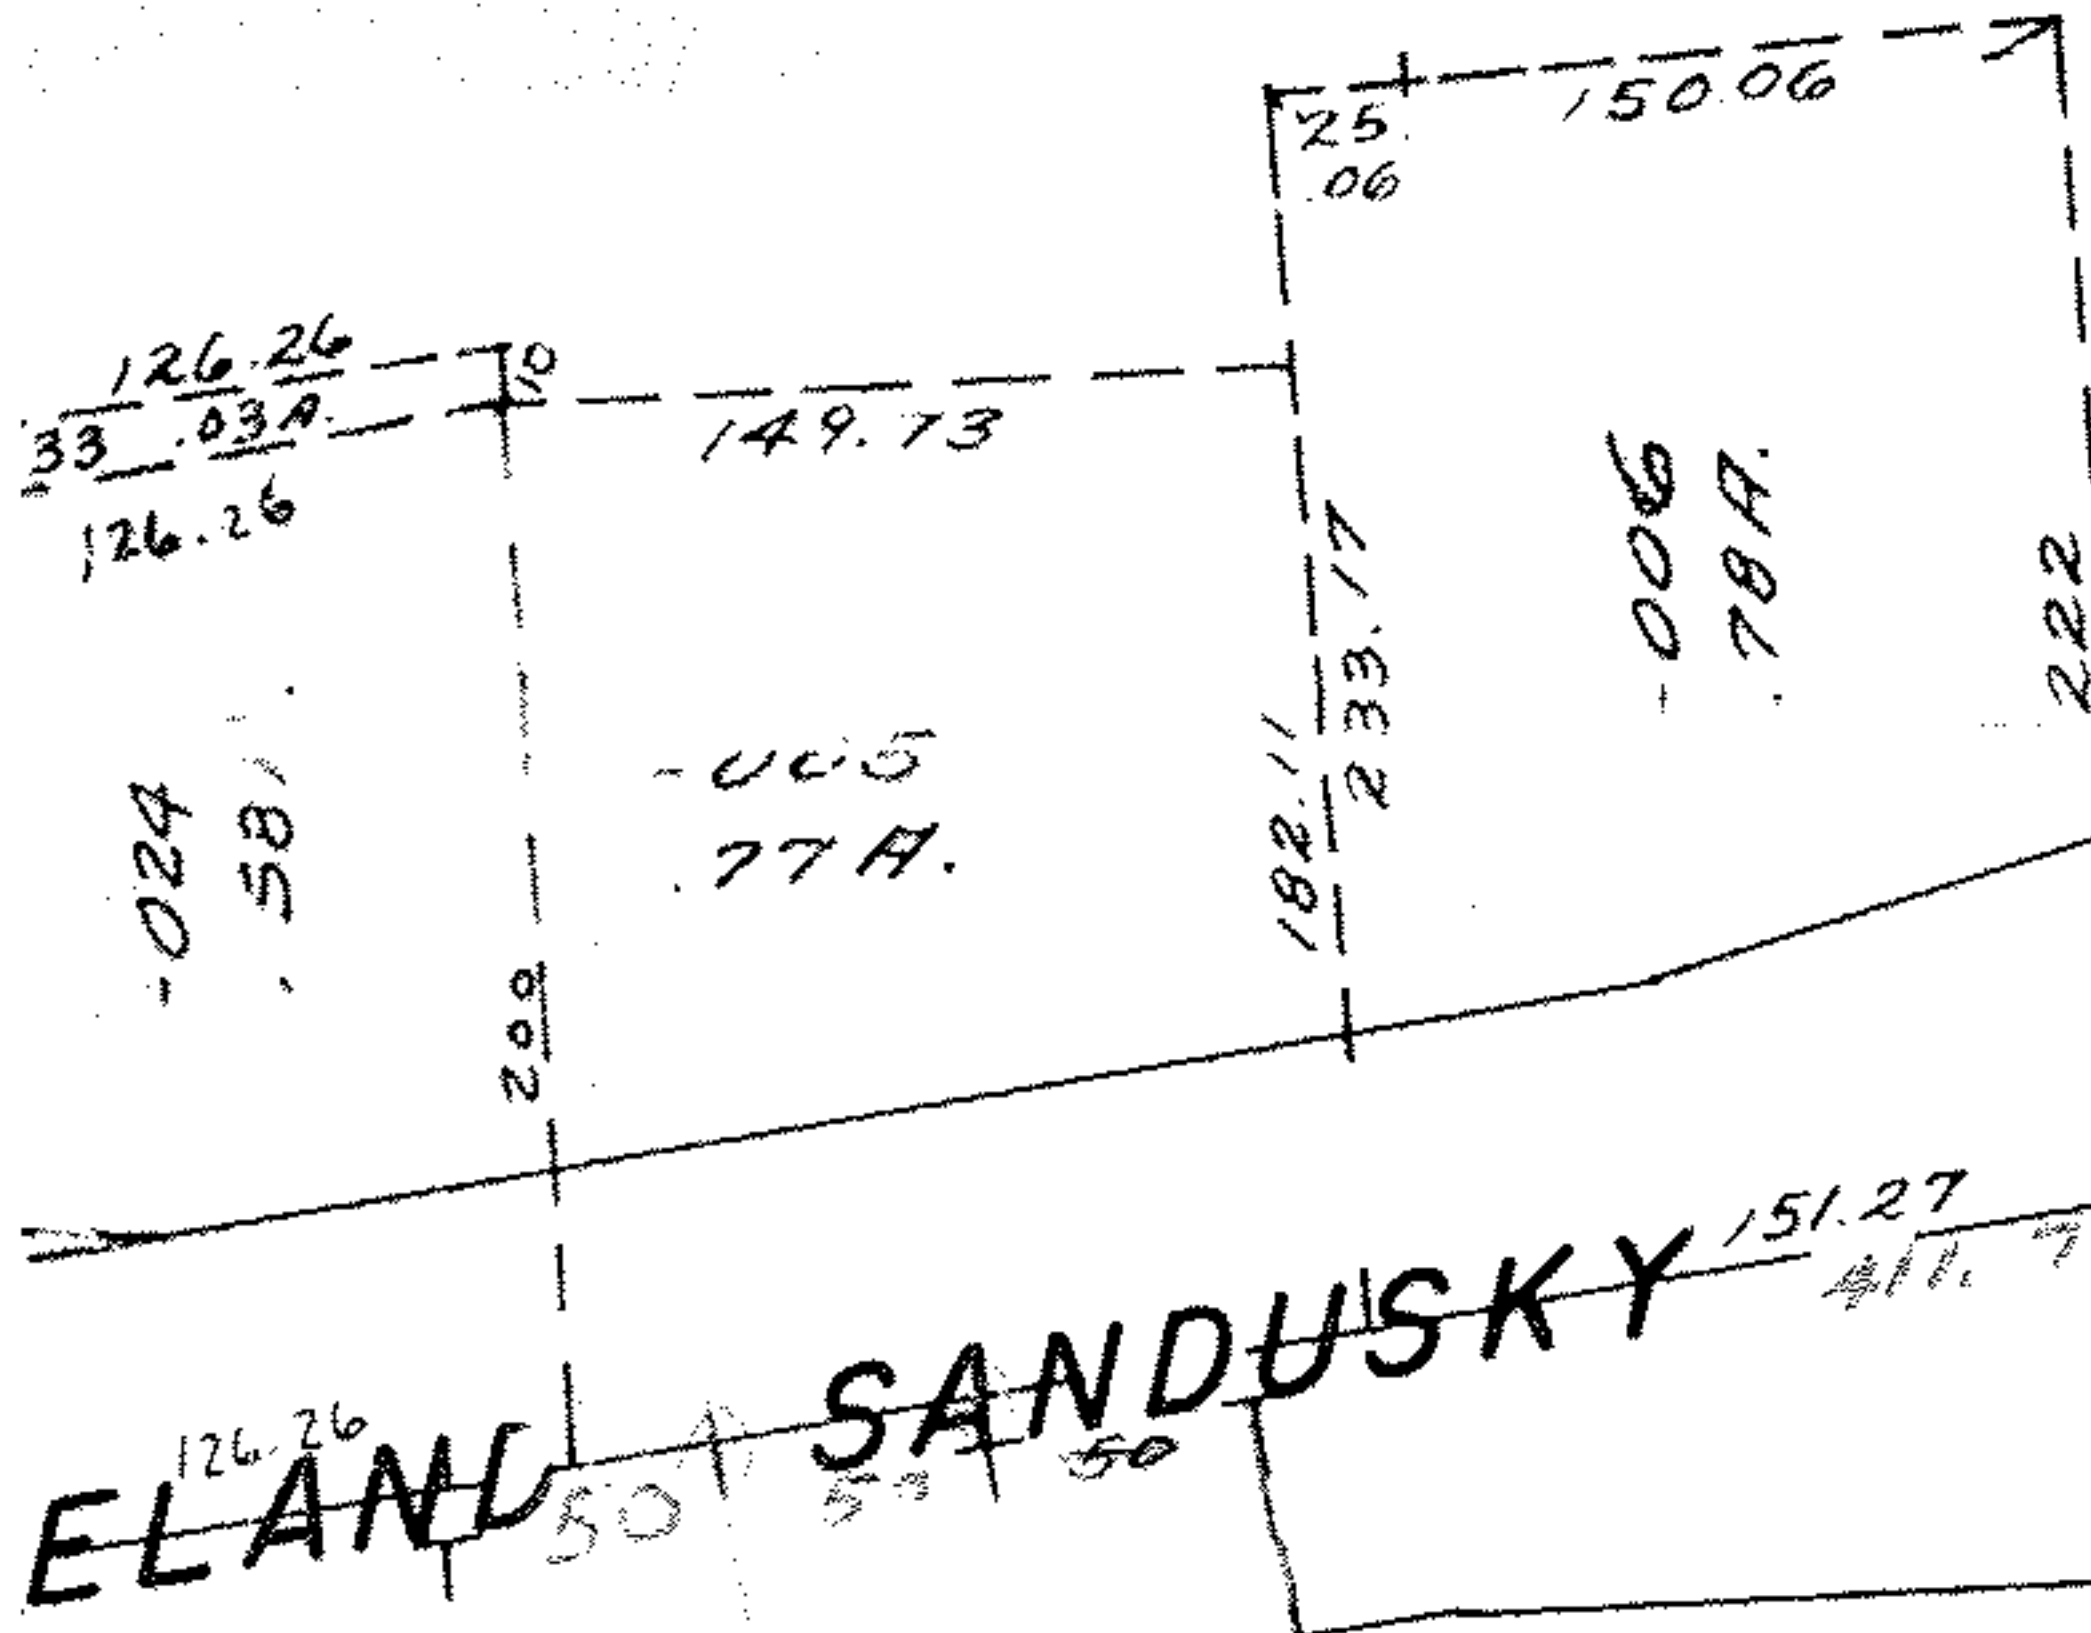

#13087

Parcel (1)

#13087

01-00-006-102-032 #13039

7.70 A.
T.M.
11-23-79

APPROVED	
LORAIN CO.	
MAP DEPT.	
DATE	9-4-79
PAGE	1-00-006A
BY	Carolyn J
VOID AFTER	13039

Page To be redrawn.

837.55
981.18

102

AVE.

RISHMAN

103

104

AVE.

NICHOLSON

(LIBE

01-00-006-104-005

-026

0