


#13054

SEE 2-02-01

02-02-017-101-028

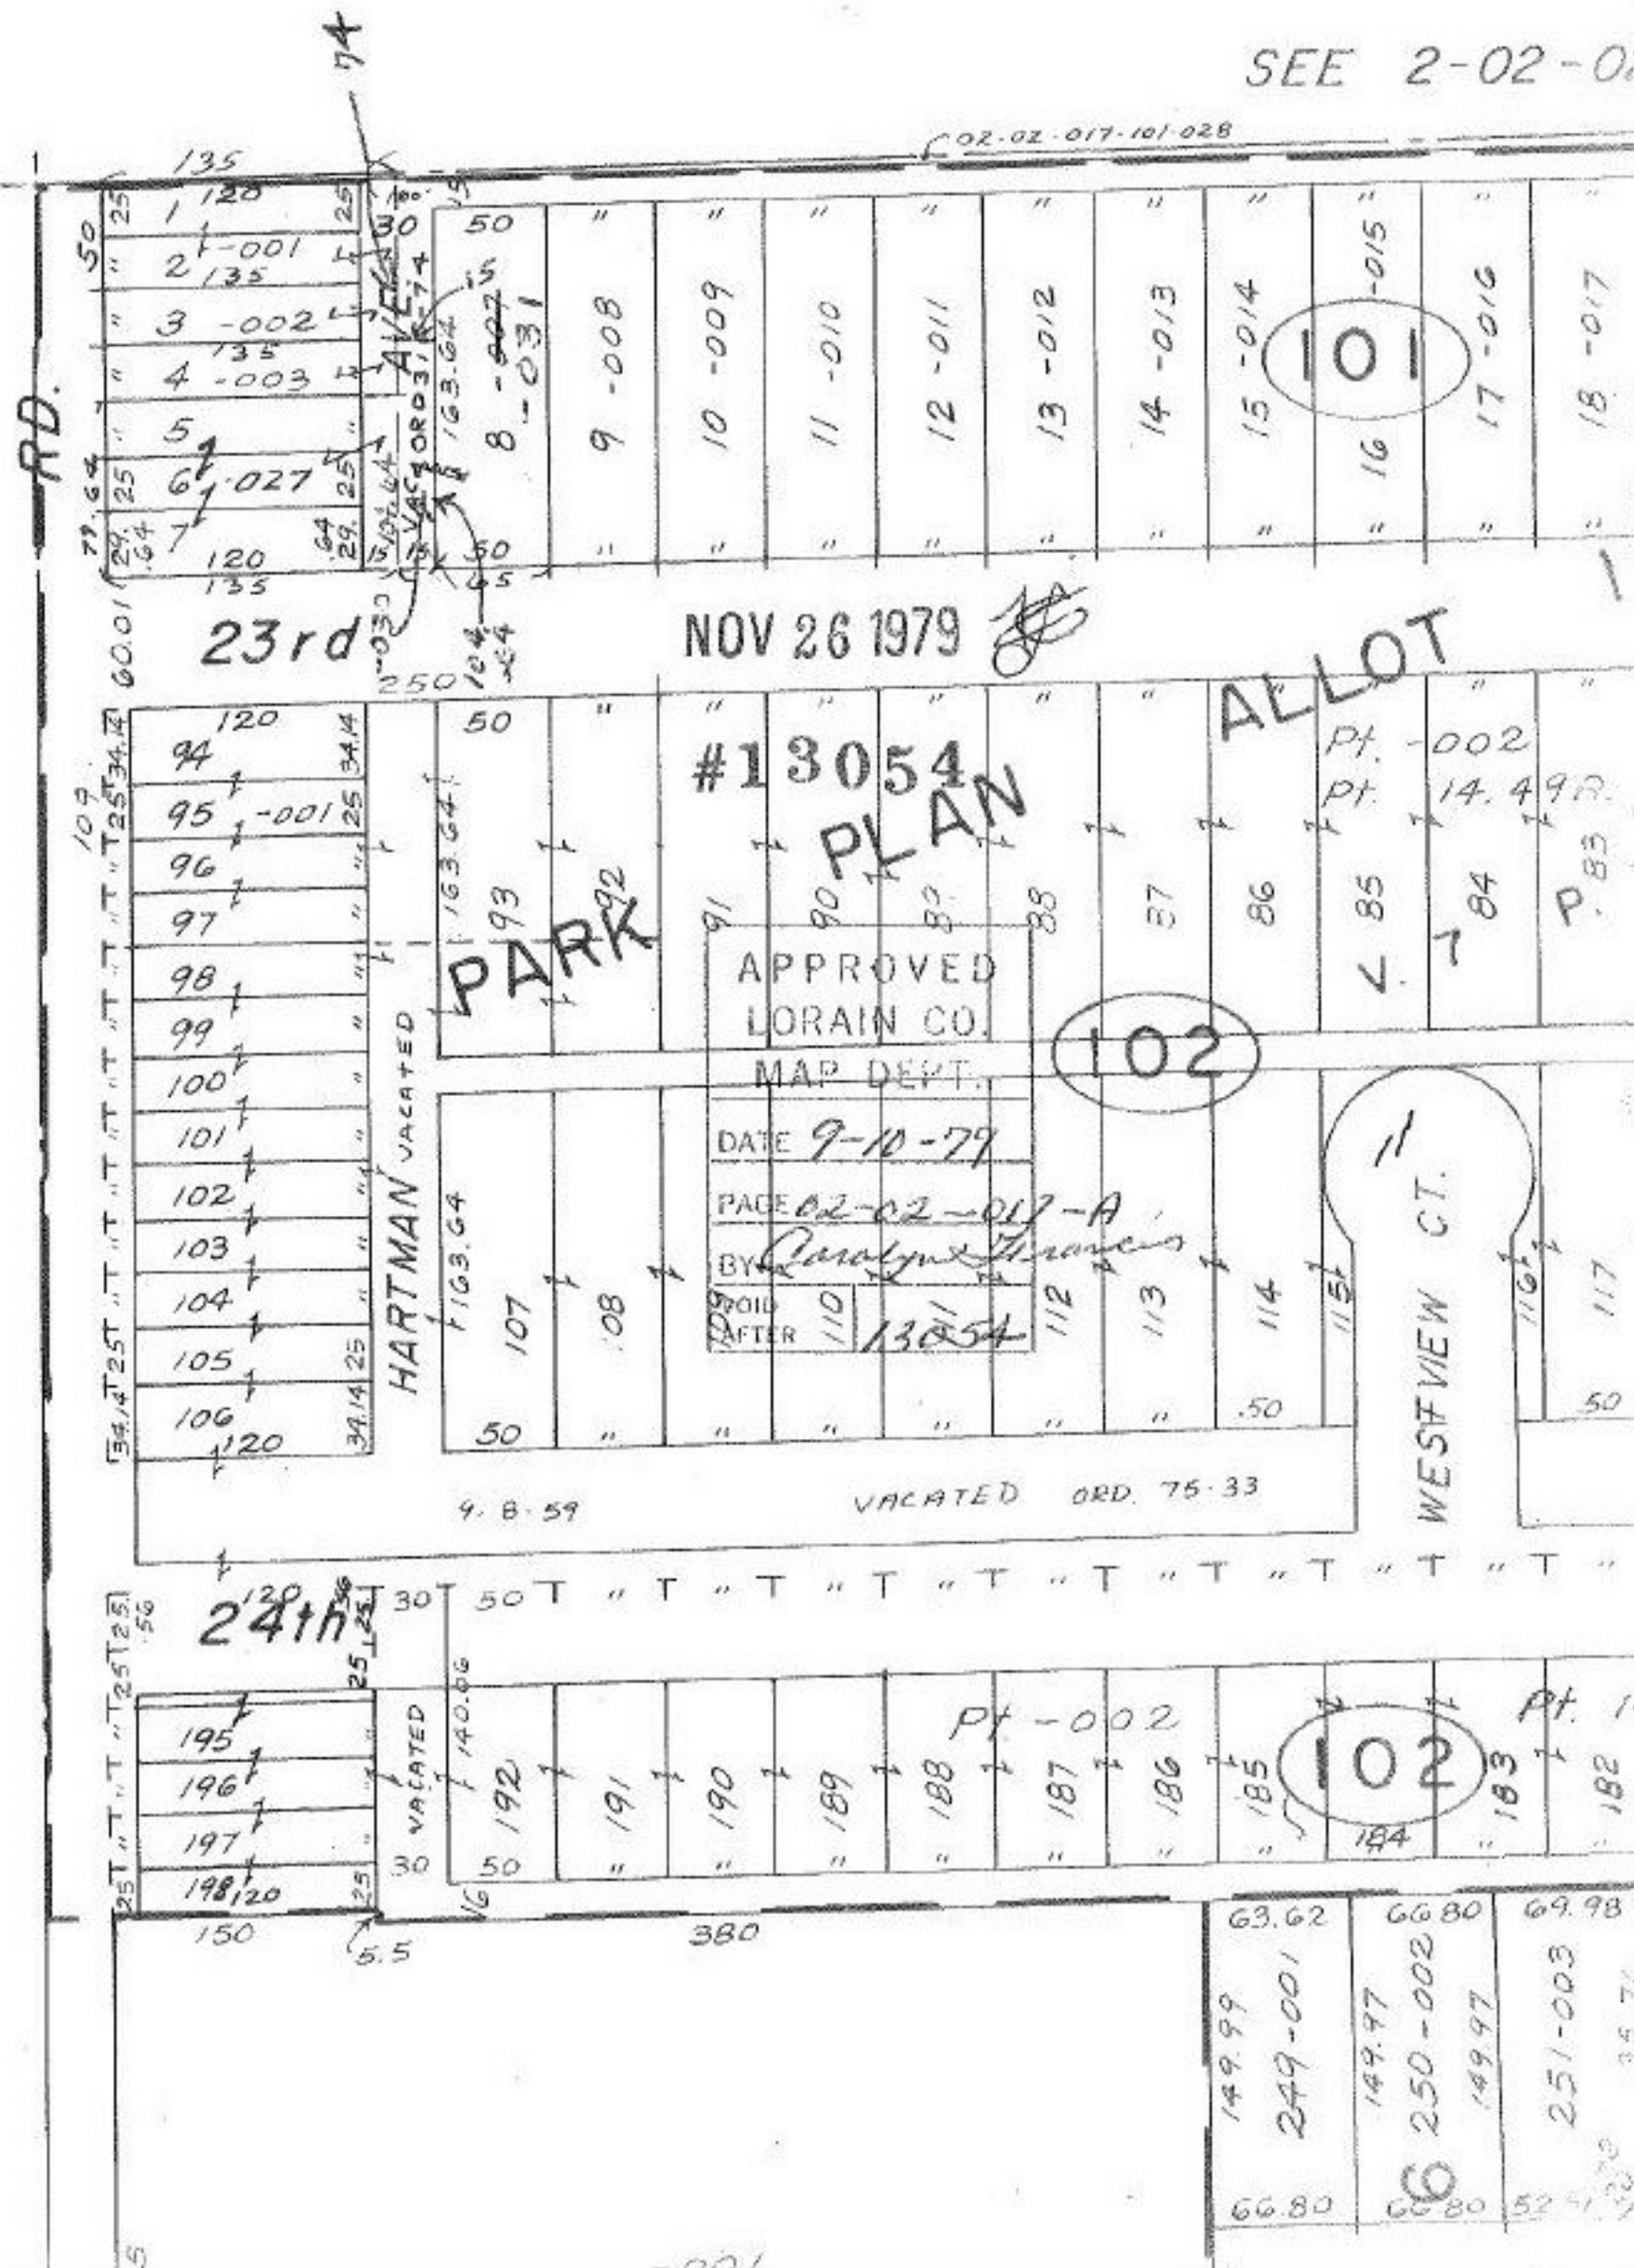

23rd

NOV 26 1979

#13054
PLAN

ALLOT

PARK

APPROVED
LORAIN CO.
MAP DEPT.

102

DATE 9-10-79

PAGE 02-02-017-A

BY *Quayle Francis*

VOID AFTER 110 13054

WESTVIEW CT.

HARTMAN VACATED

9.8.59

VACATED ORD. 75-33

24th

102

149.99	63.62	66.80	69.98
249-001		250-002	
149.97		149.97	
66.80	66.80	52.5	35.71
		251-003	