


#13100

Pl. 17-307

SEE 7-00-026-C

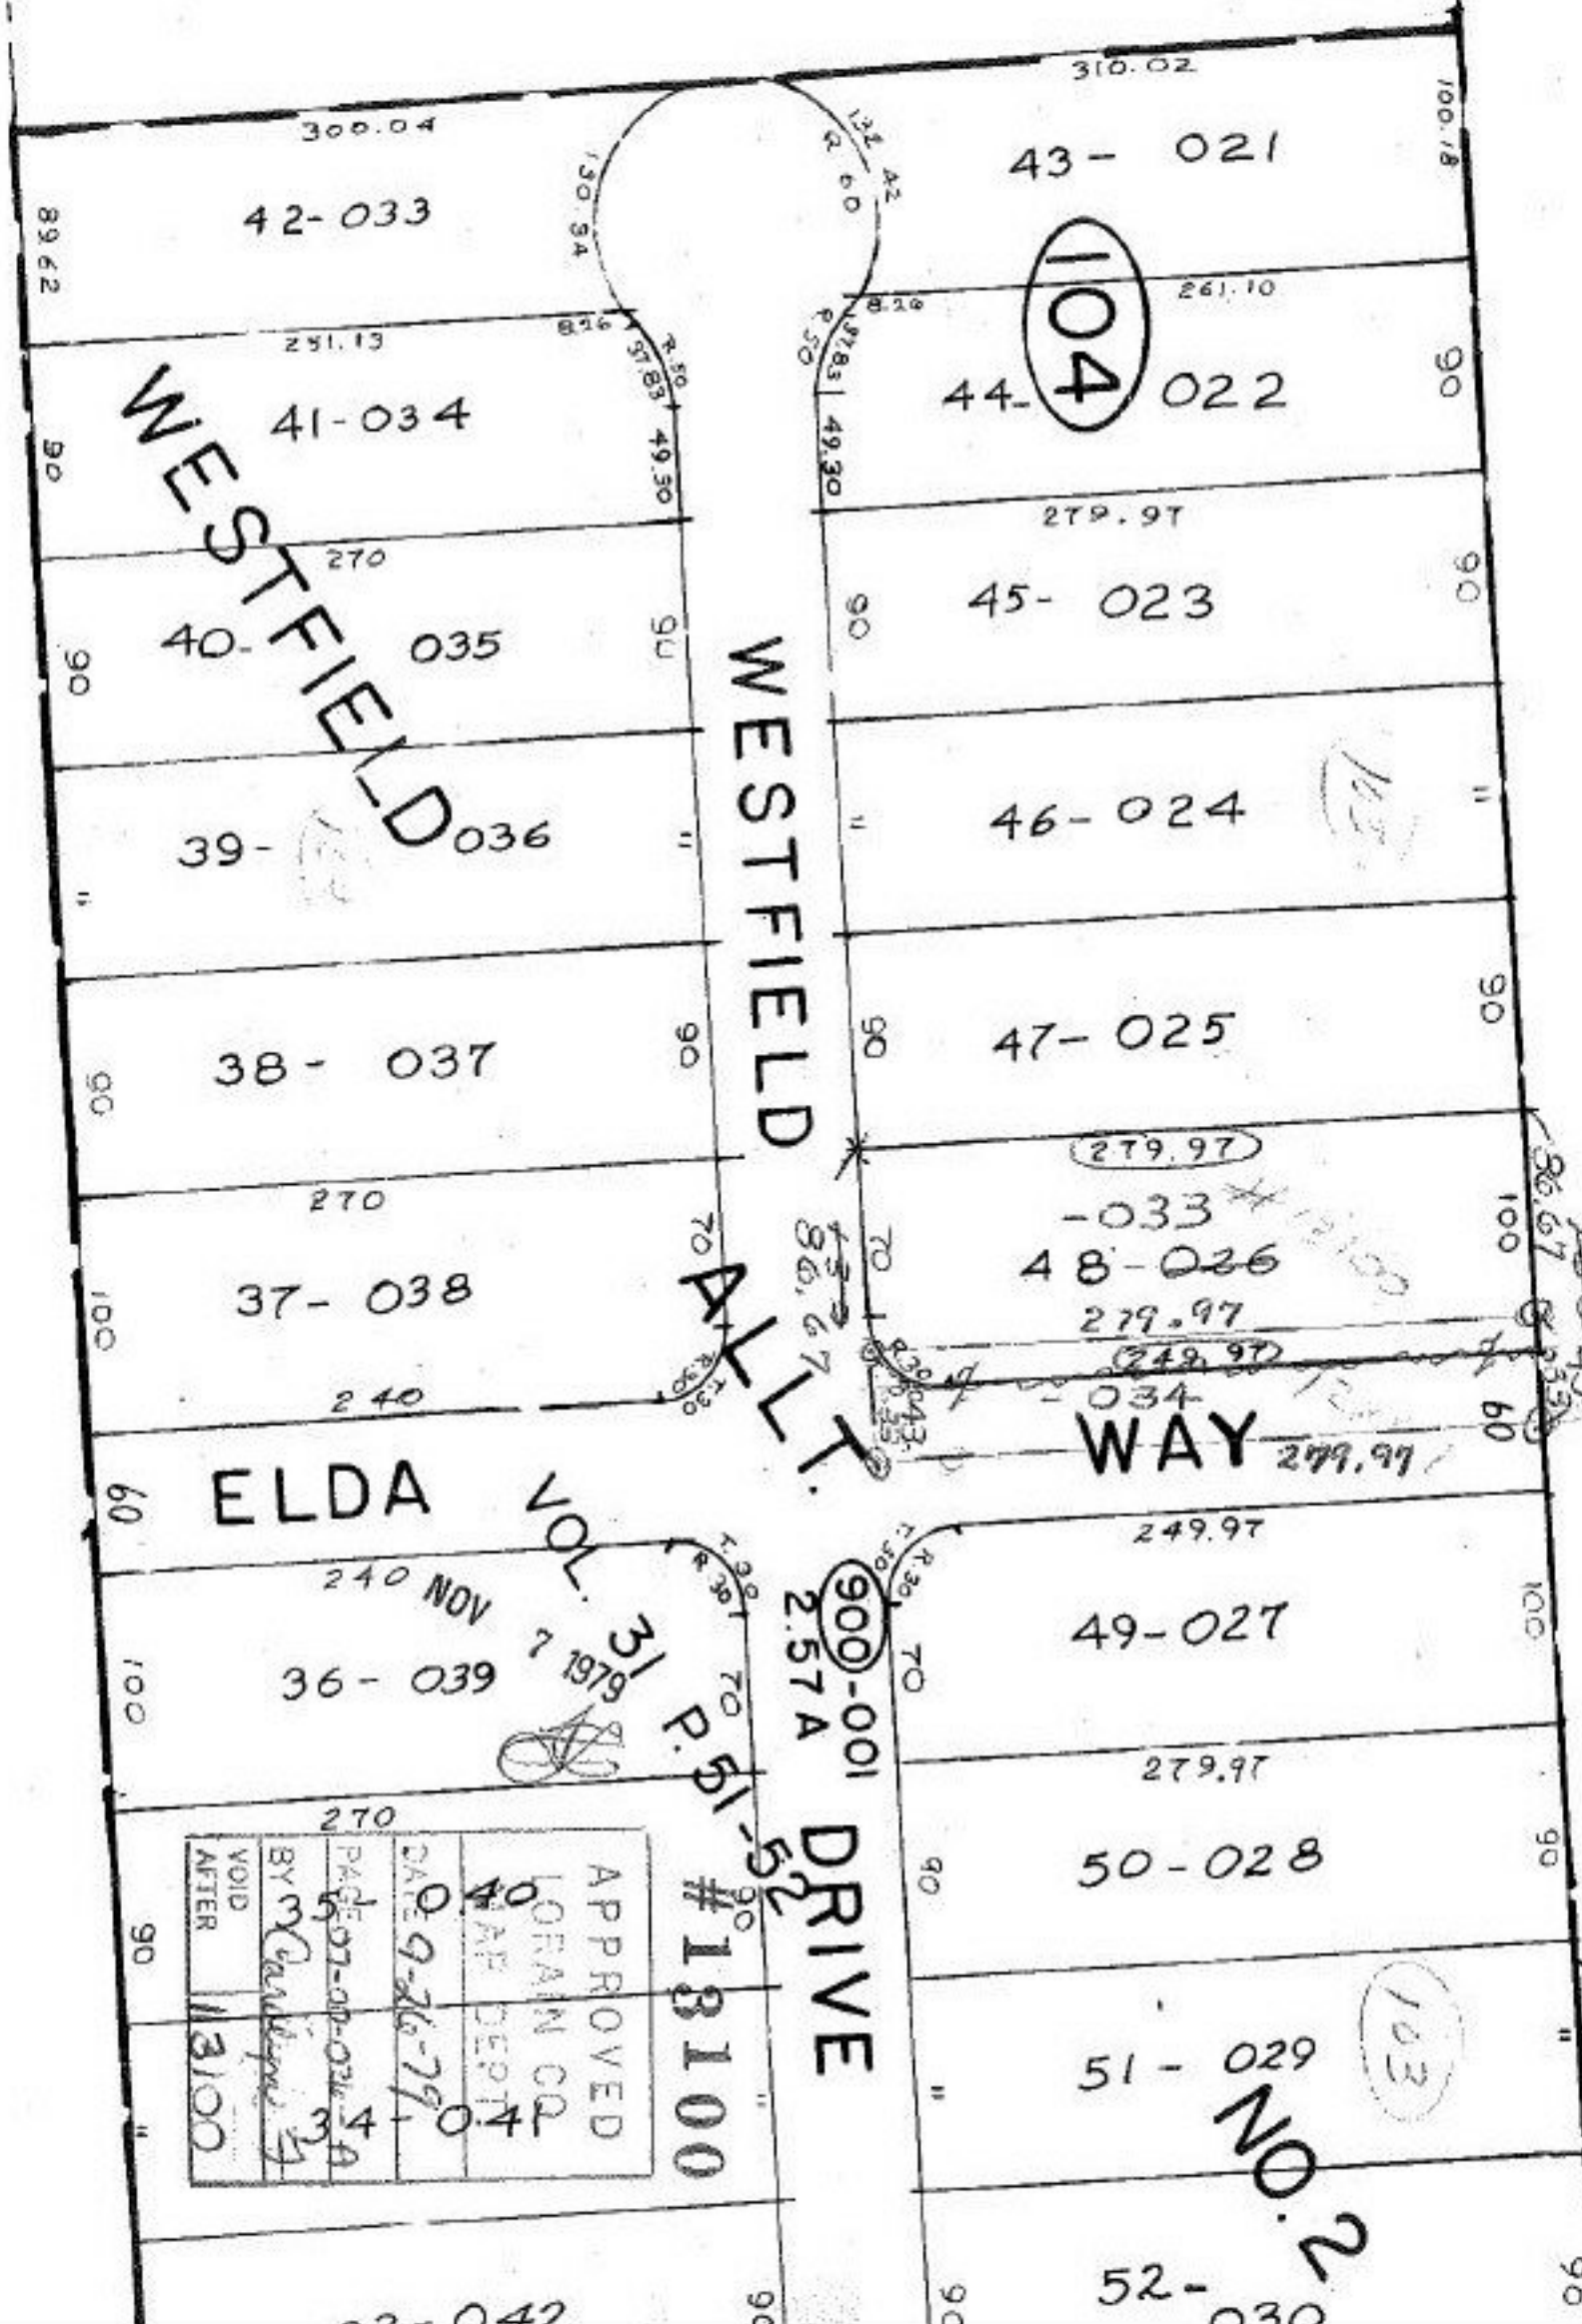

WESTFIELD

WESTFIELD

WESTFIELD

ELDA

WAY

DRIVE

APPROVED
 LORAIN CO.
 MAP DEPT.
 DATE 9-26-79
 BY M. [Signature]
 PAGE 07-00-034
 VOID AFTER 13100

#13100

900-001
2.57A

NO. 2

86.67 x 279.97
43.33 x 279.97
279.97

103

104

42-033

41-034

40-035

39-036

38-037

37-038

36-039

43-021

44-022

45-023

46-024

47-025

48-026

49-027

49-027

50-028

51-029

52-030

300.04

291.13

270

270

240

240

270

310.02

261.10

279.97

279.97

279.97

249.97

279.97

249.97

279.97

89.62

90

90

90

90

100

60

100

90

90

100.78

90

90

90

90

100

60

100

90

90

90

130.54

49.30

90

90

70

70

90

90

131.42

49.30

90

90

70

70

90

90

8.26

49.30

90

90

70

70

90

90

36.67

43.33

100

100

90

90