


617.

#13112
-066
10.03A.

NOV 23 1979

#13112

APPROVED LORAIN CO. MAP DEPT.	DATE 10-1-79	G
	PAGE 4-00-013	
	BY Carolyn J.	
VOID AFTER	13112	

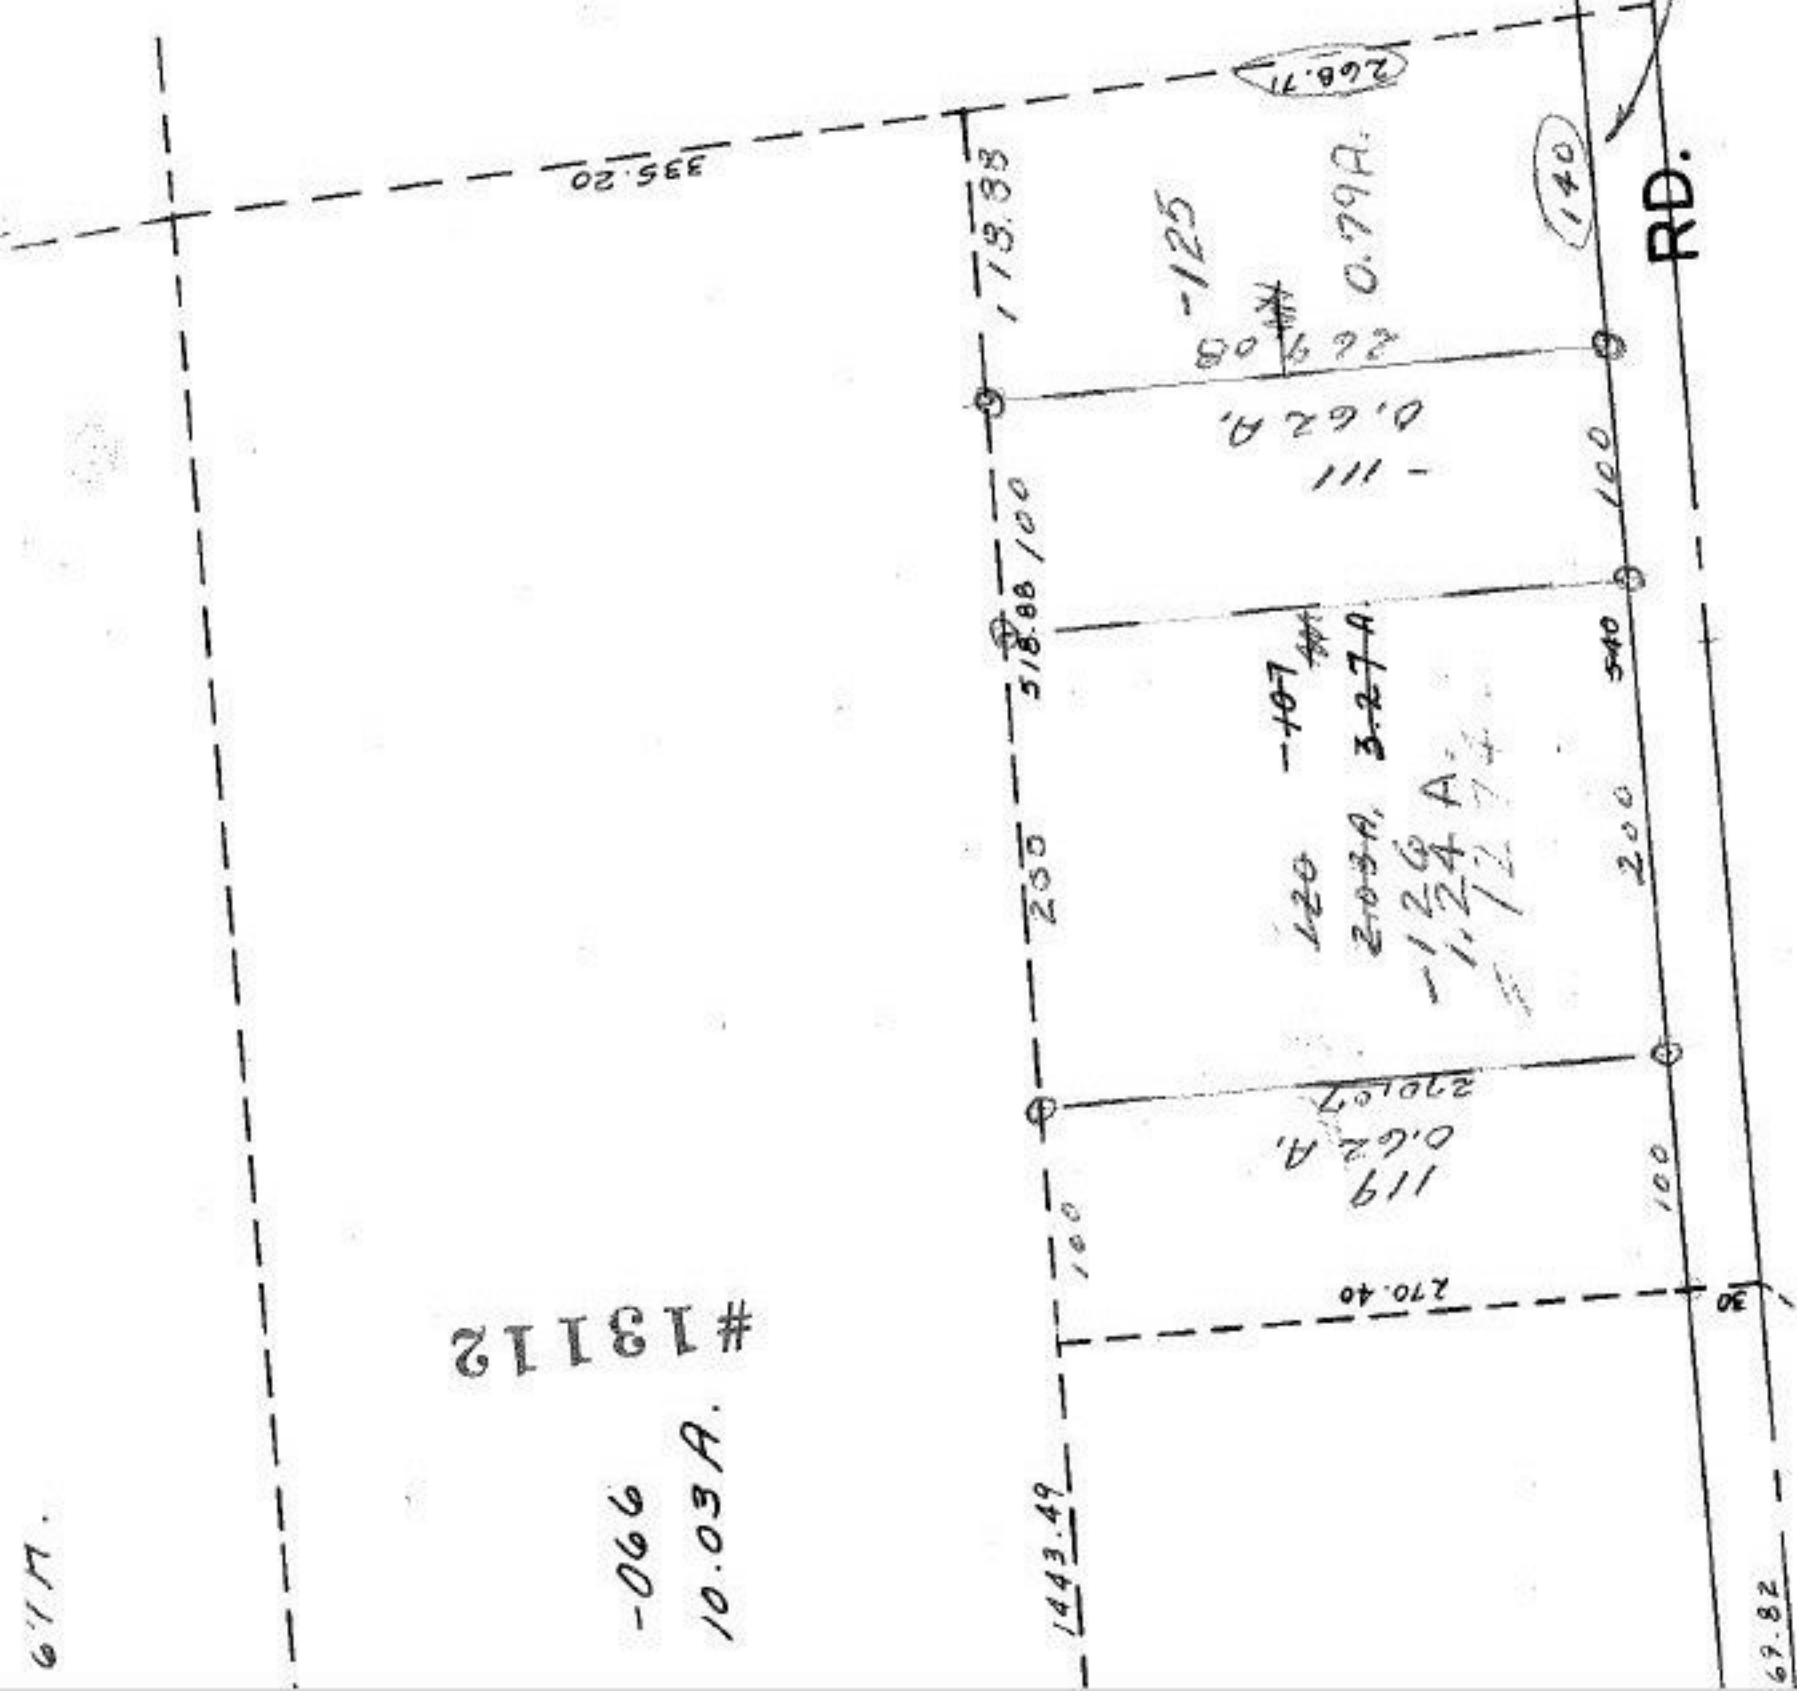

LORAIN CITY