


#13133

100.	150
50	15
<hr/>	
150X	165

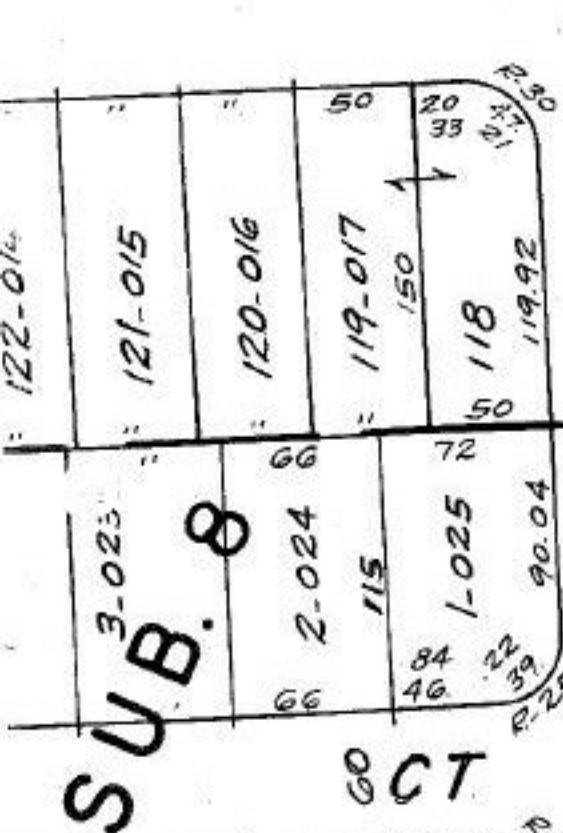

NOV 12 1979

#13133

