




WEST RIVER

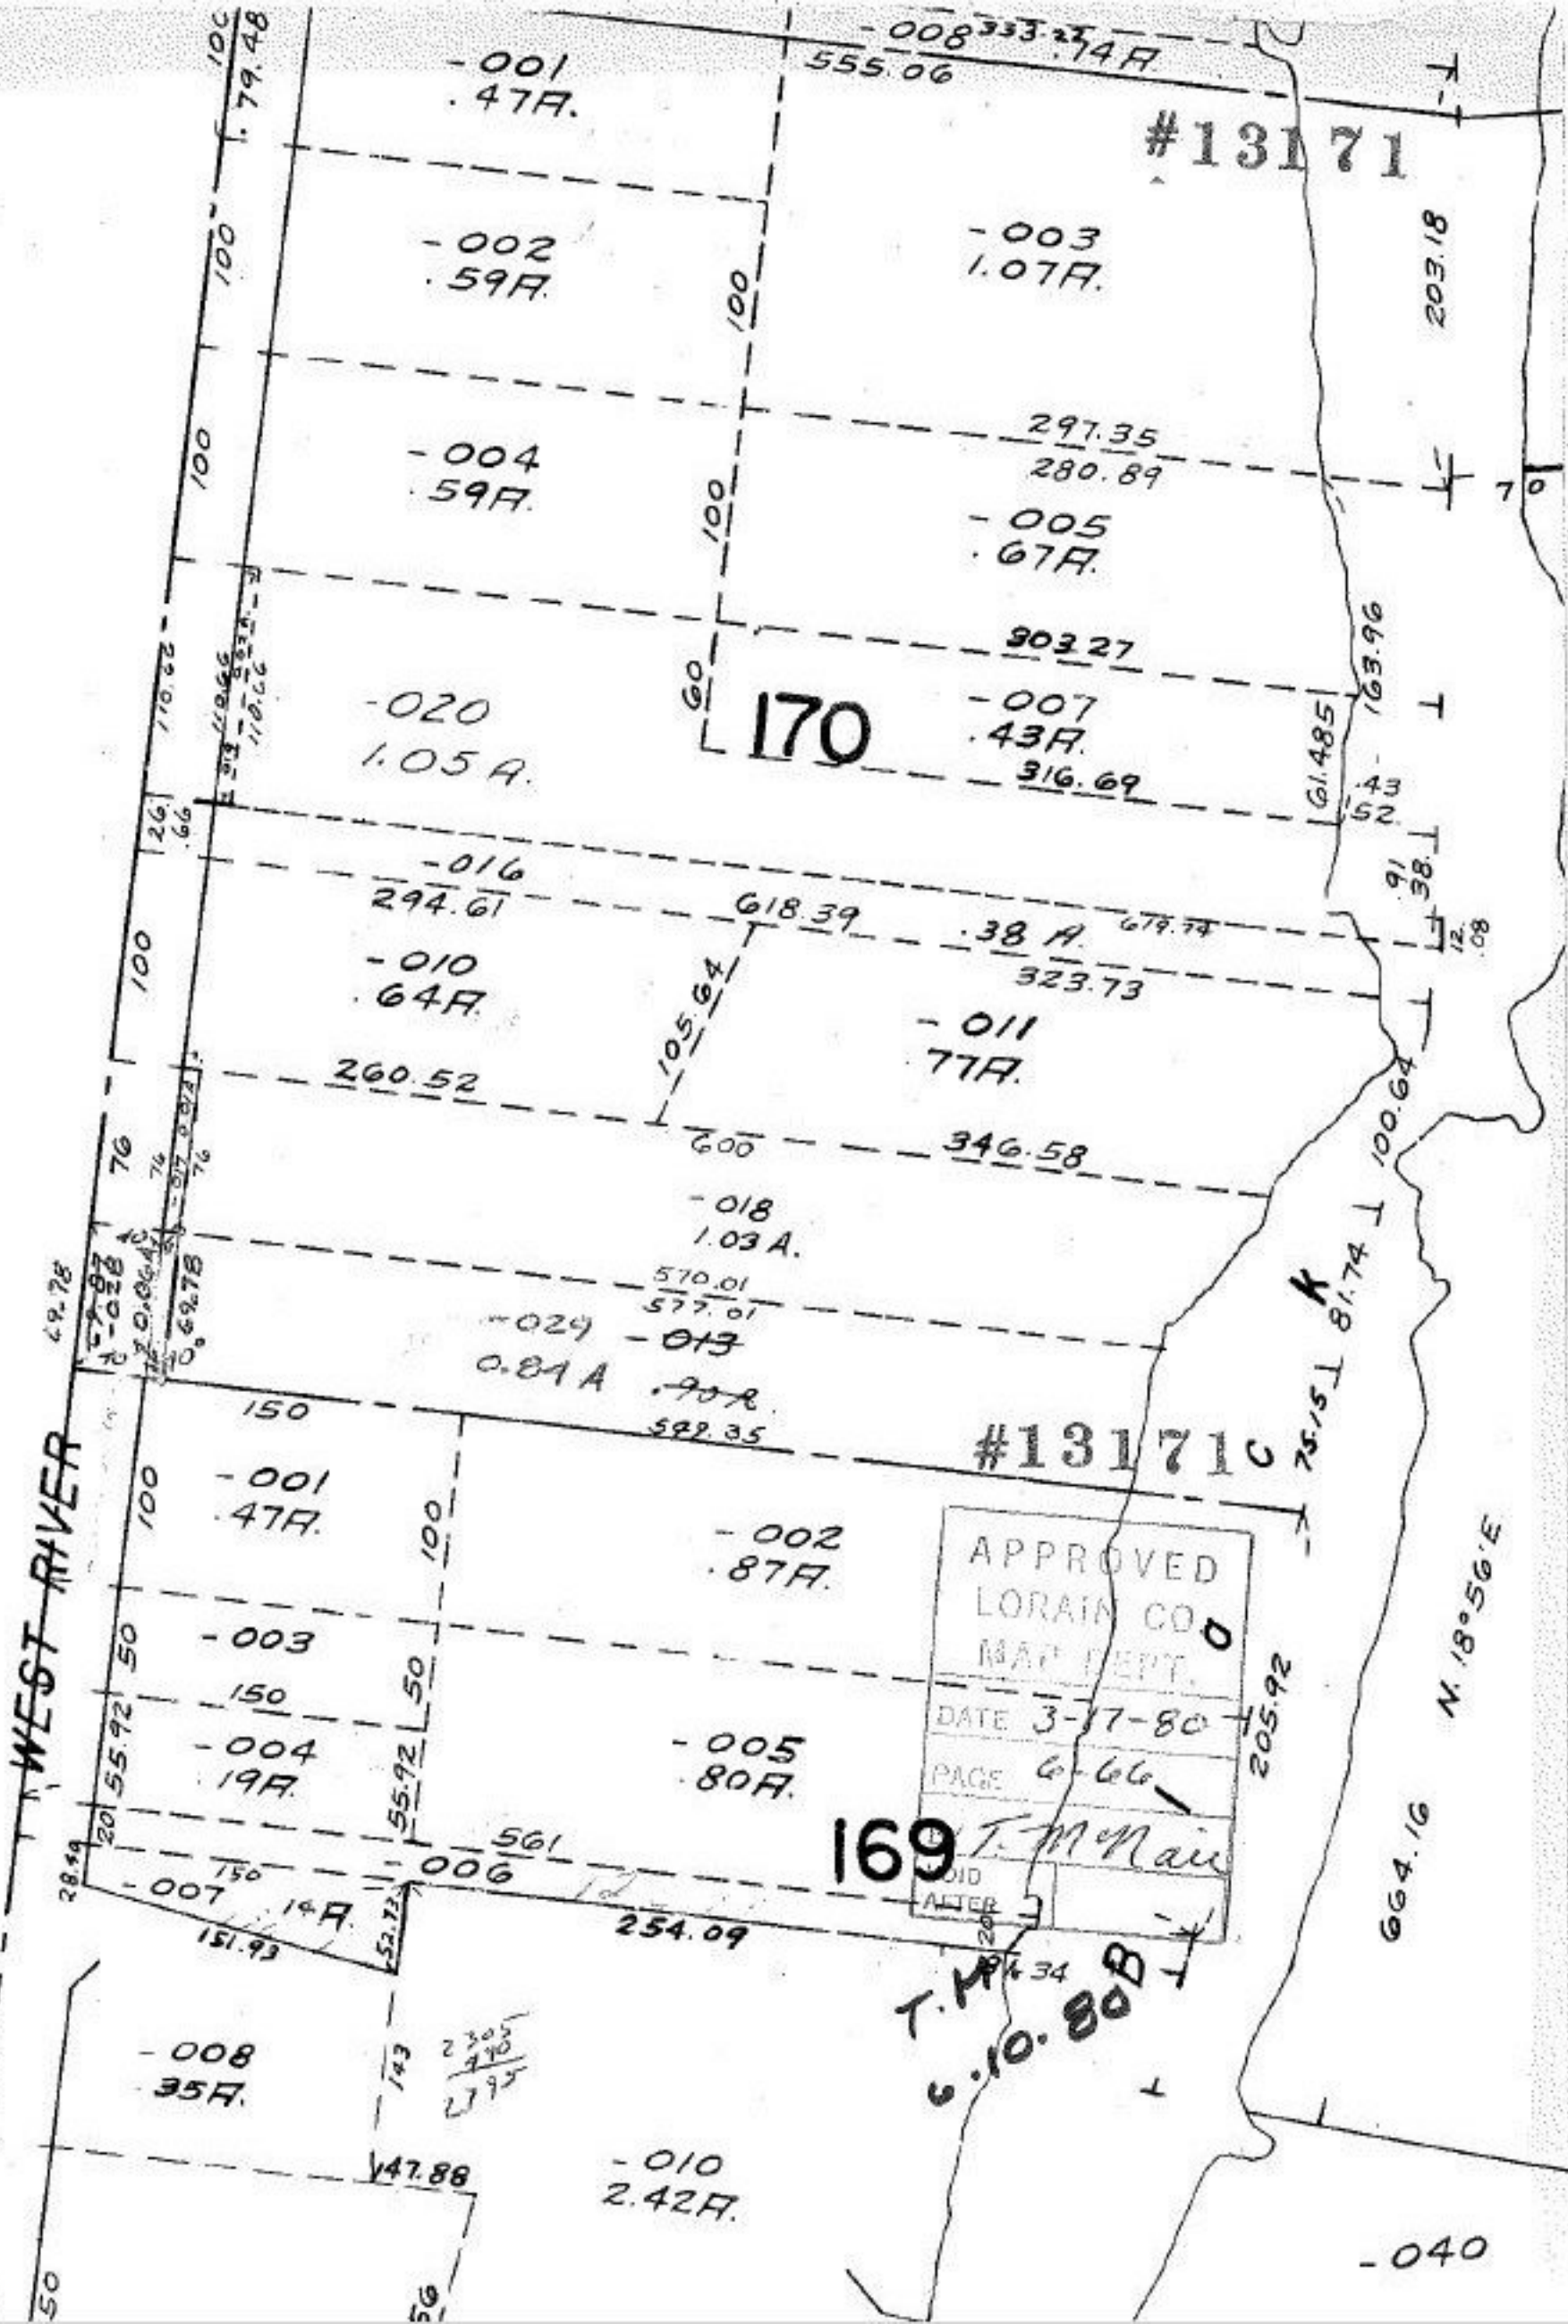

APPROVED
LORAIN CO.
MAP DEPT.
DATE 3-17-80
PAGE 6-66
T. M. McNeil
VOID
ALTER

T. M. McNeil
6-10-80

664.16 N. 18° 56' E

-040