


#13192

87.92 58.63 87.98 58.67 117.38 148.80 88.12 58.77 176.38 117.65 58.84 58.84

SHEFFIELD FRENCH CREEK

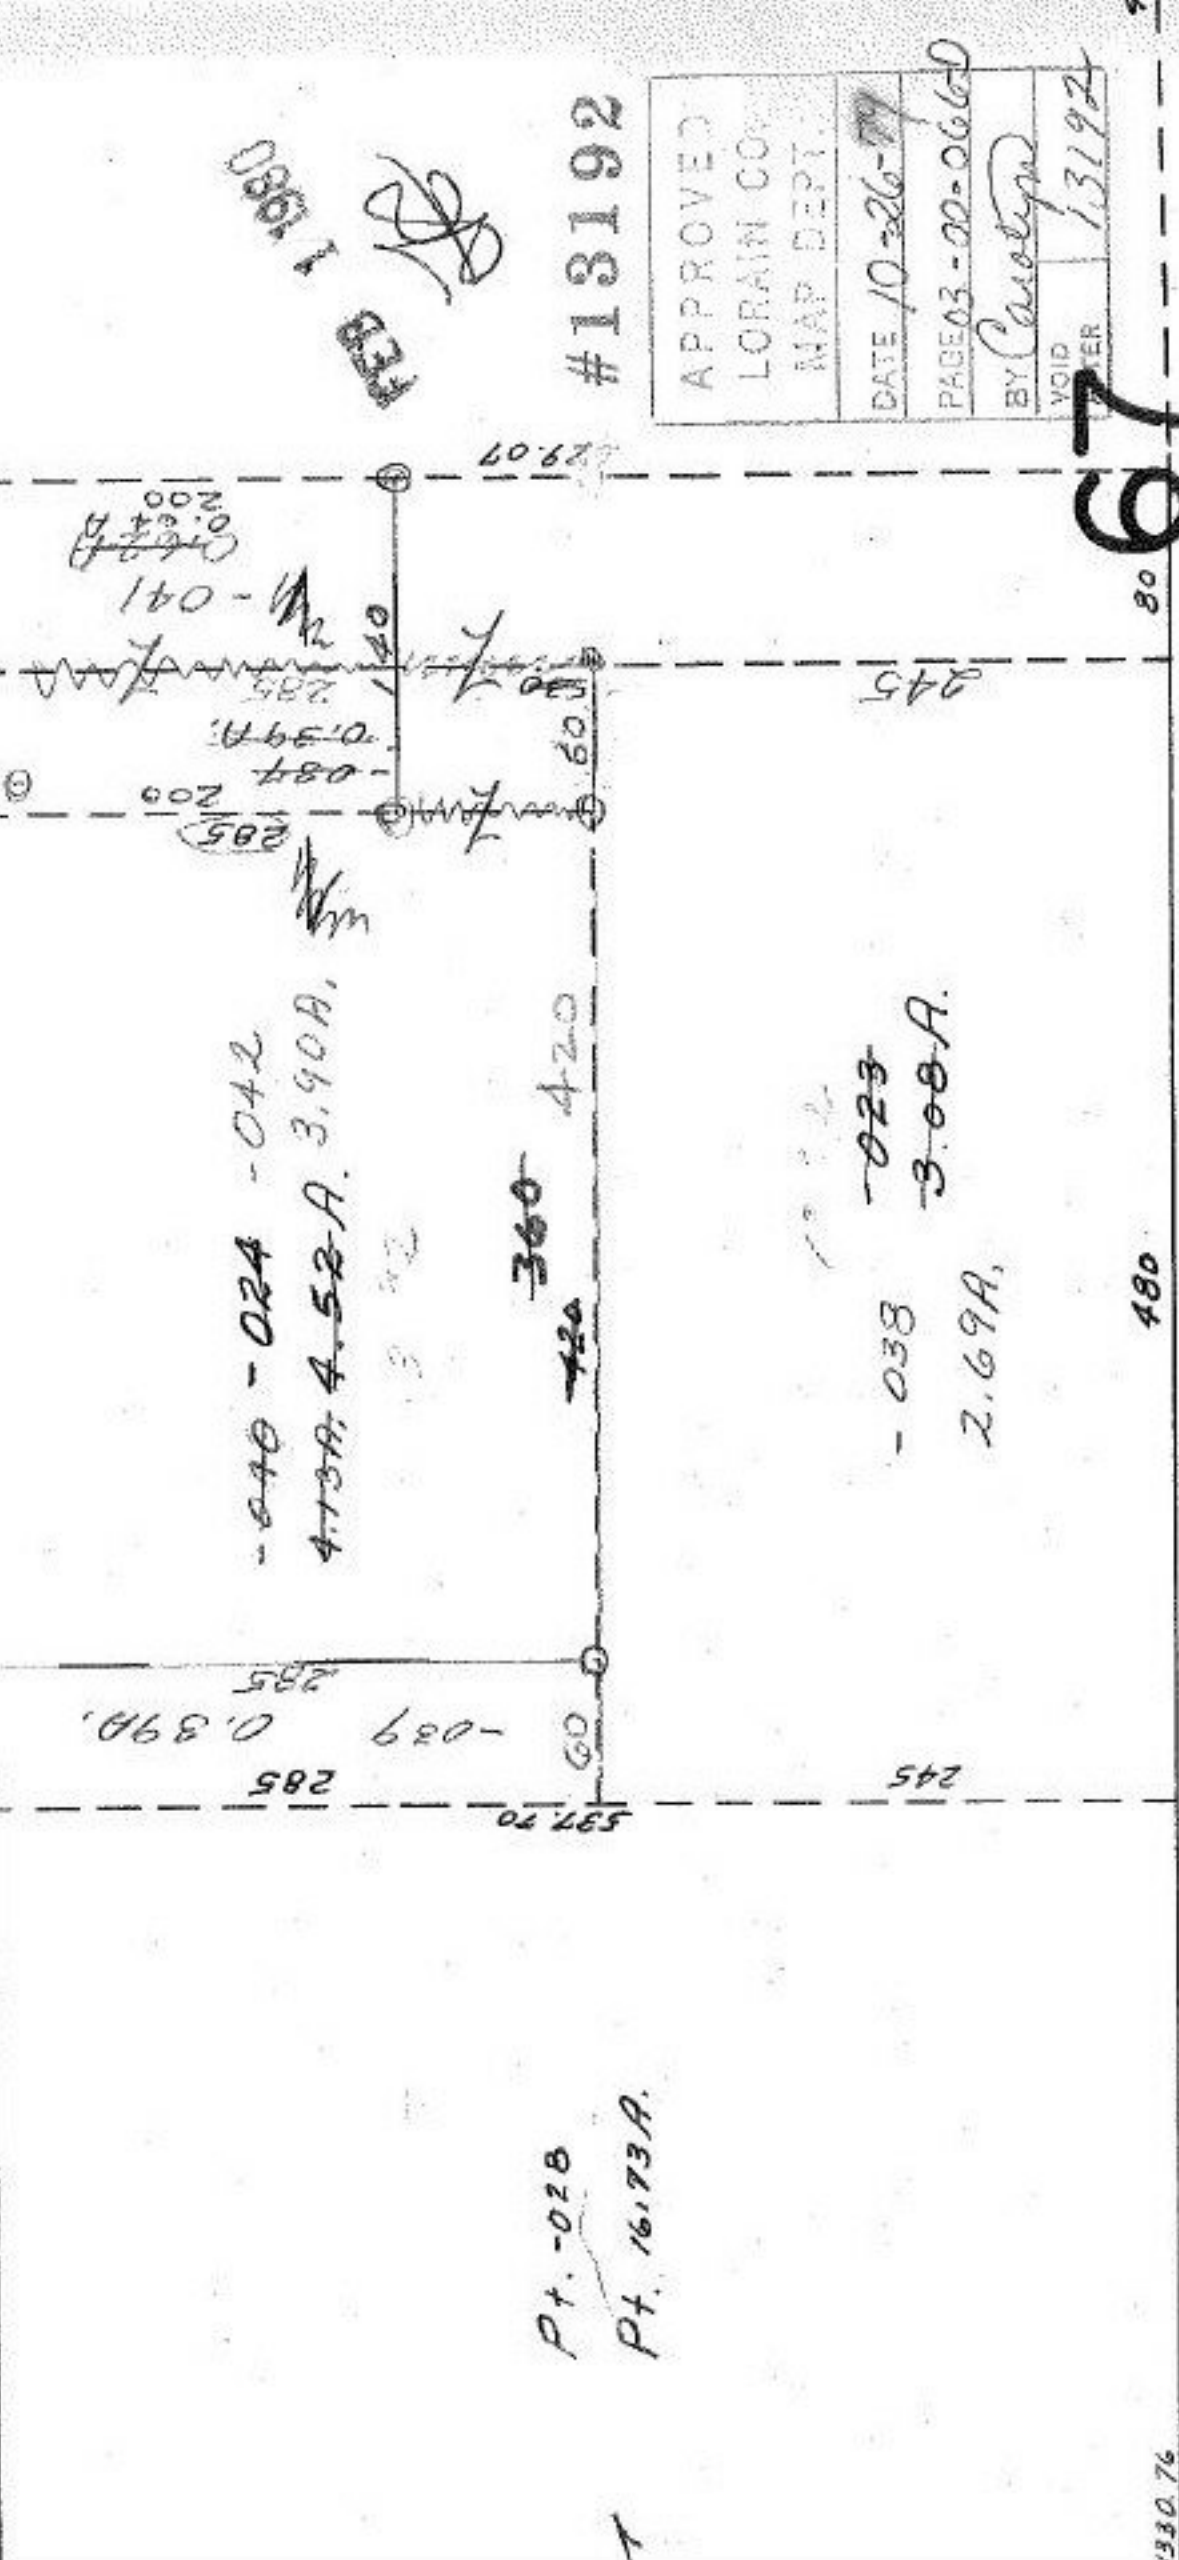

Pt. -02B  
Pt. 16.73A.

#13192

APPROVED
LORAIN CO.
MAP DEPT.
DATE 10-26-77
PAGE 03 - 00 - 066-D
BY Carolyn
VOID AFTER 13192

67