

SEE 3-00-103-B

DALLAS

4014-023	4019-042
4015-024 120	4018-043 120
4016-025 120.02	4017-044 120.02

LO 60


4058-023	4063-043
4059-024 120	4062-044 120
4060-025 120.02	4061-045 120.02

ALE 60

4102-023
4103-024 120
4104-025 120.02

19th 135.60 100 245.31 50

#13195

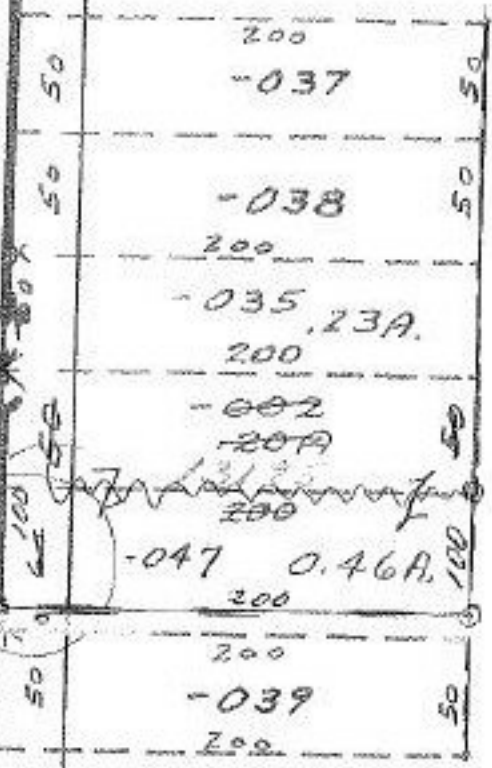


-044
5.86A
048
5.60A



794.13

-009
4.49A

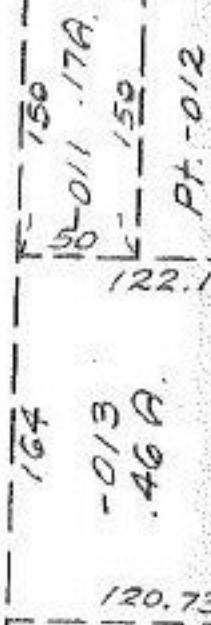

801.03

#13195



APP. FILED
 L. J. ...
 ...
 DATE: 10-29-79
 PAGE: 3-00-103-A
 BY: Carolyn H.
 VOID AFTER: 13180

115

NOV 24 1979

915.50

435.55

245.31

482.05
332.03

-003
3.22A

251.24