

#13198



#12843

#13198

~~093~~  
53.80 A.

- 100  
50.57 A.

~~093~~  
51.13 A

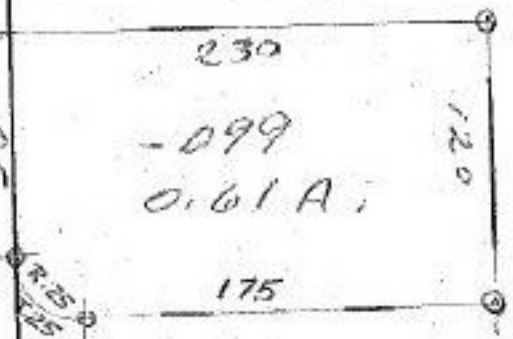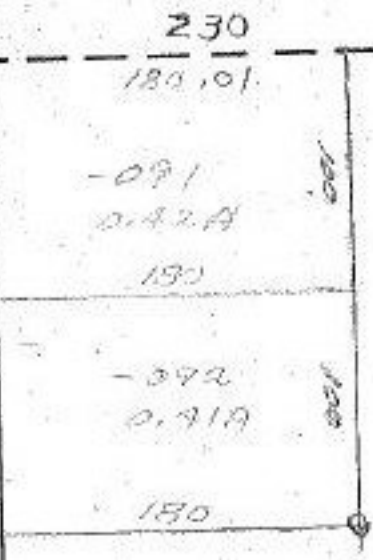

*[Handwritten signature]*

#13198

NOV 23 1979

|                     |
|---------------------|
| APPROVED            |
| LORAIN CO.          |
| MAP DEPT.           |
| DATE 10-31-79       |
| PAGE 4-00-003 F     |
| BY <i>Cavallaro</i> |
| VOID AFTER 1/3/98   |

X SHEFFIELD - FRENCH CREEK  
301.26

SEE 4-00-002-B 12931

RD.