


#13206

~~-067~~ -069
~~37.67 A.~~ 35.46 A.

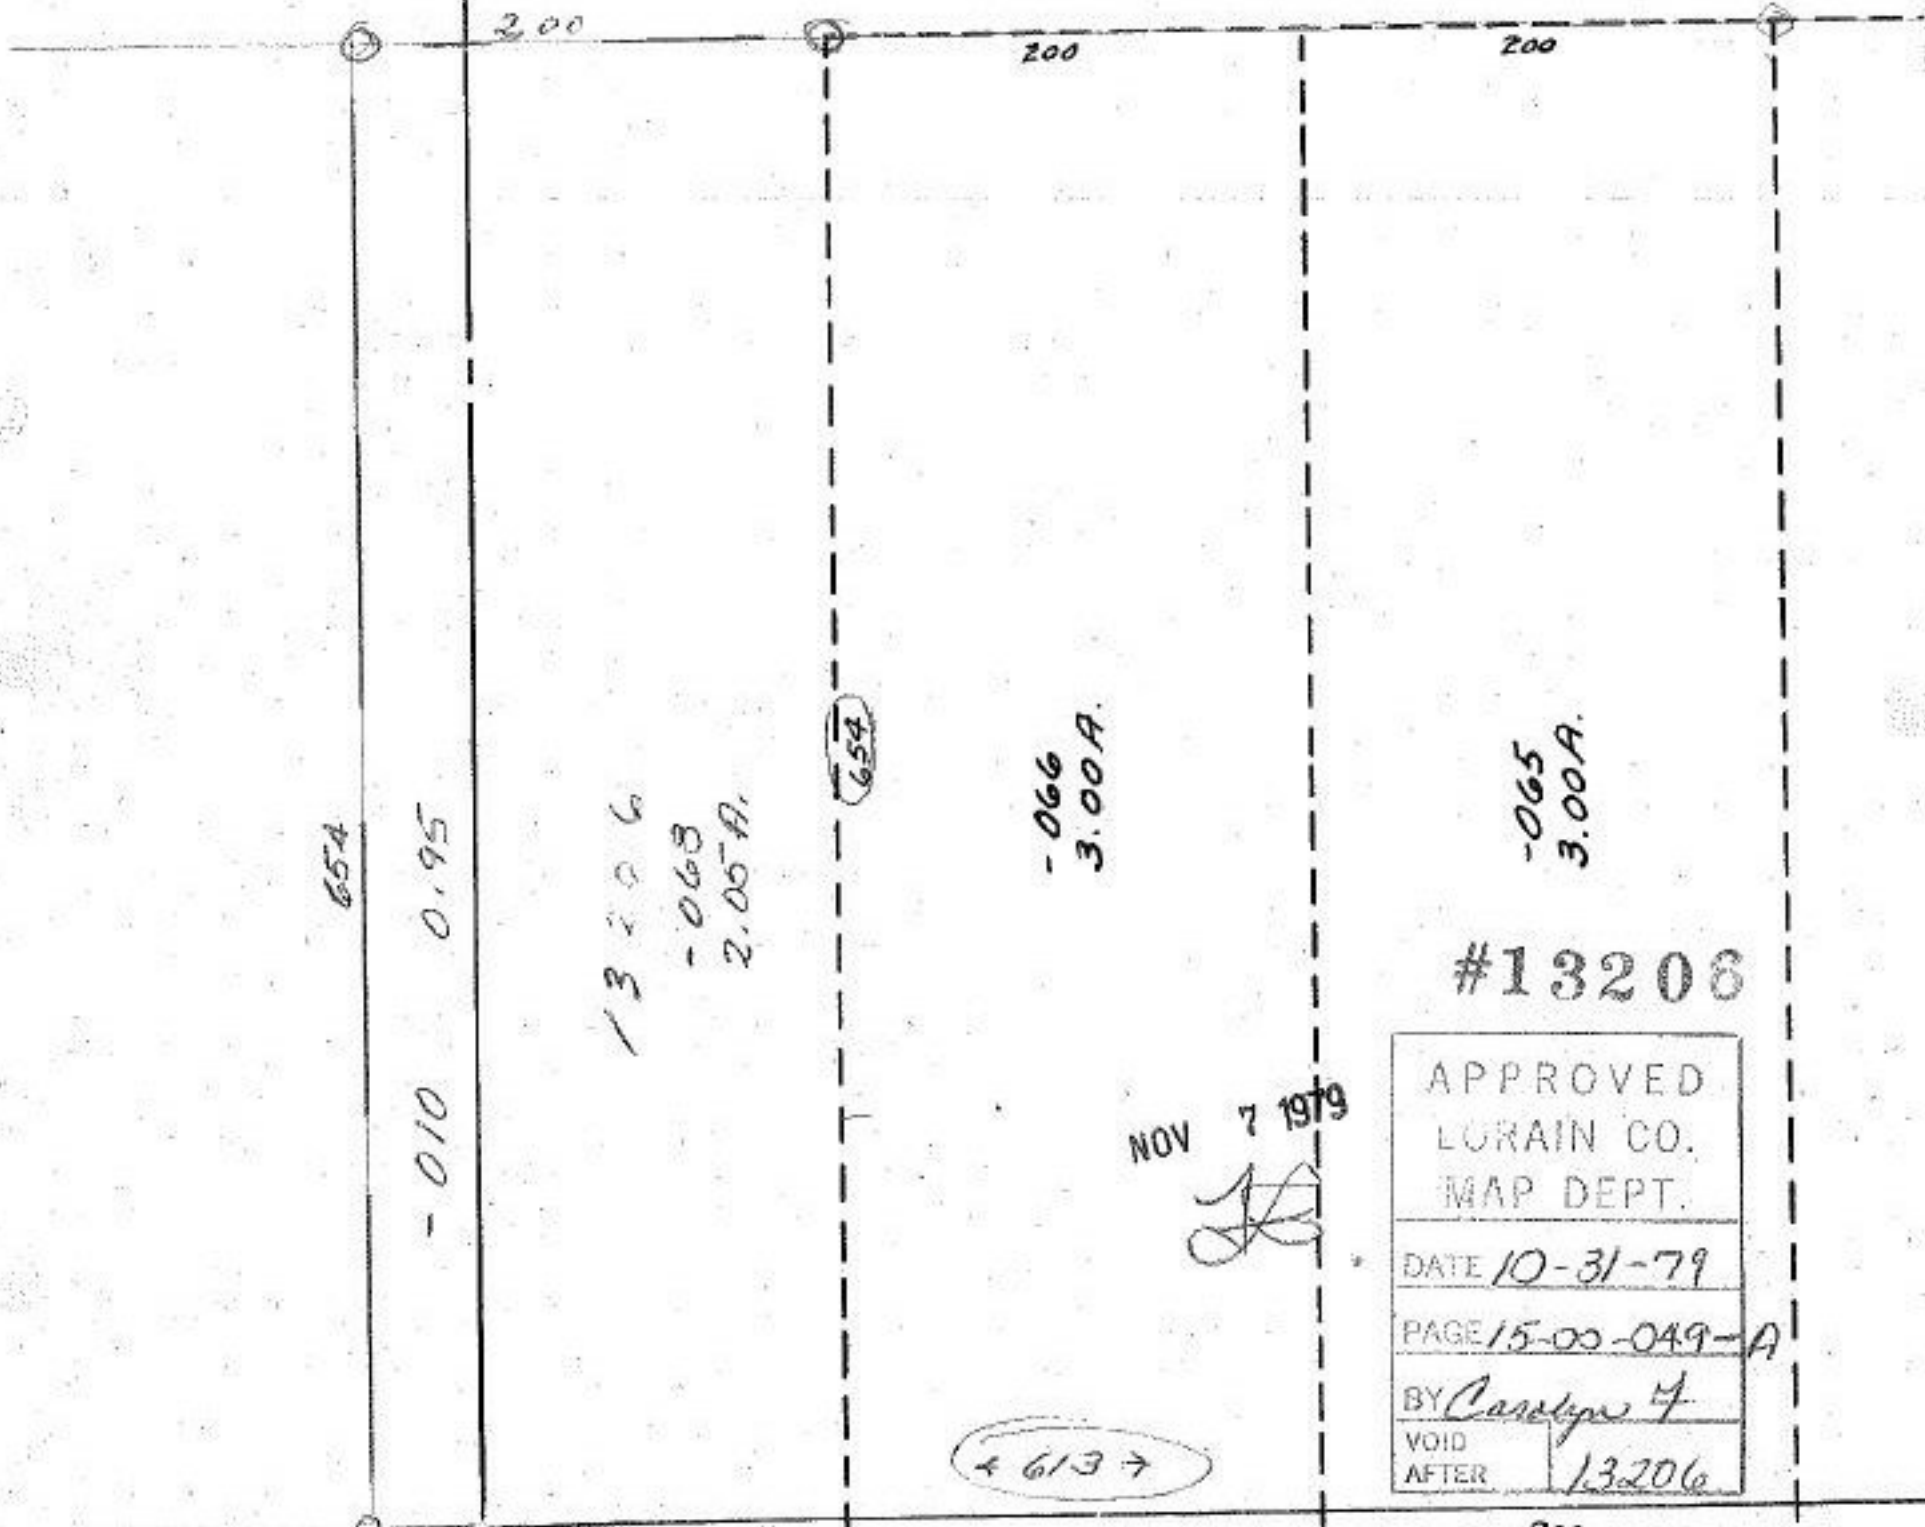

#13206

NOV 7 1979

APPROVED
LORAIN CO.
MAP DEPT.
DATE 10-31-79
PAGE 15-00-049-A
BY Carolyn F.
VOID AFTER 13206

613

60 WAKEMEN - LAGRANGE - RICHFIELD

SEE 15 - H