


#13207

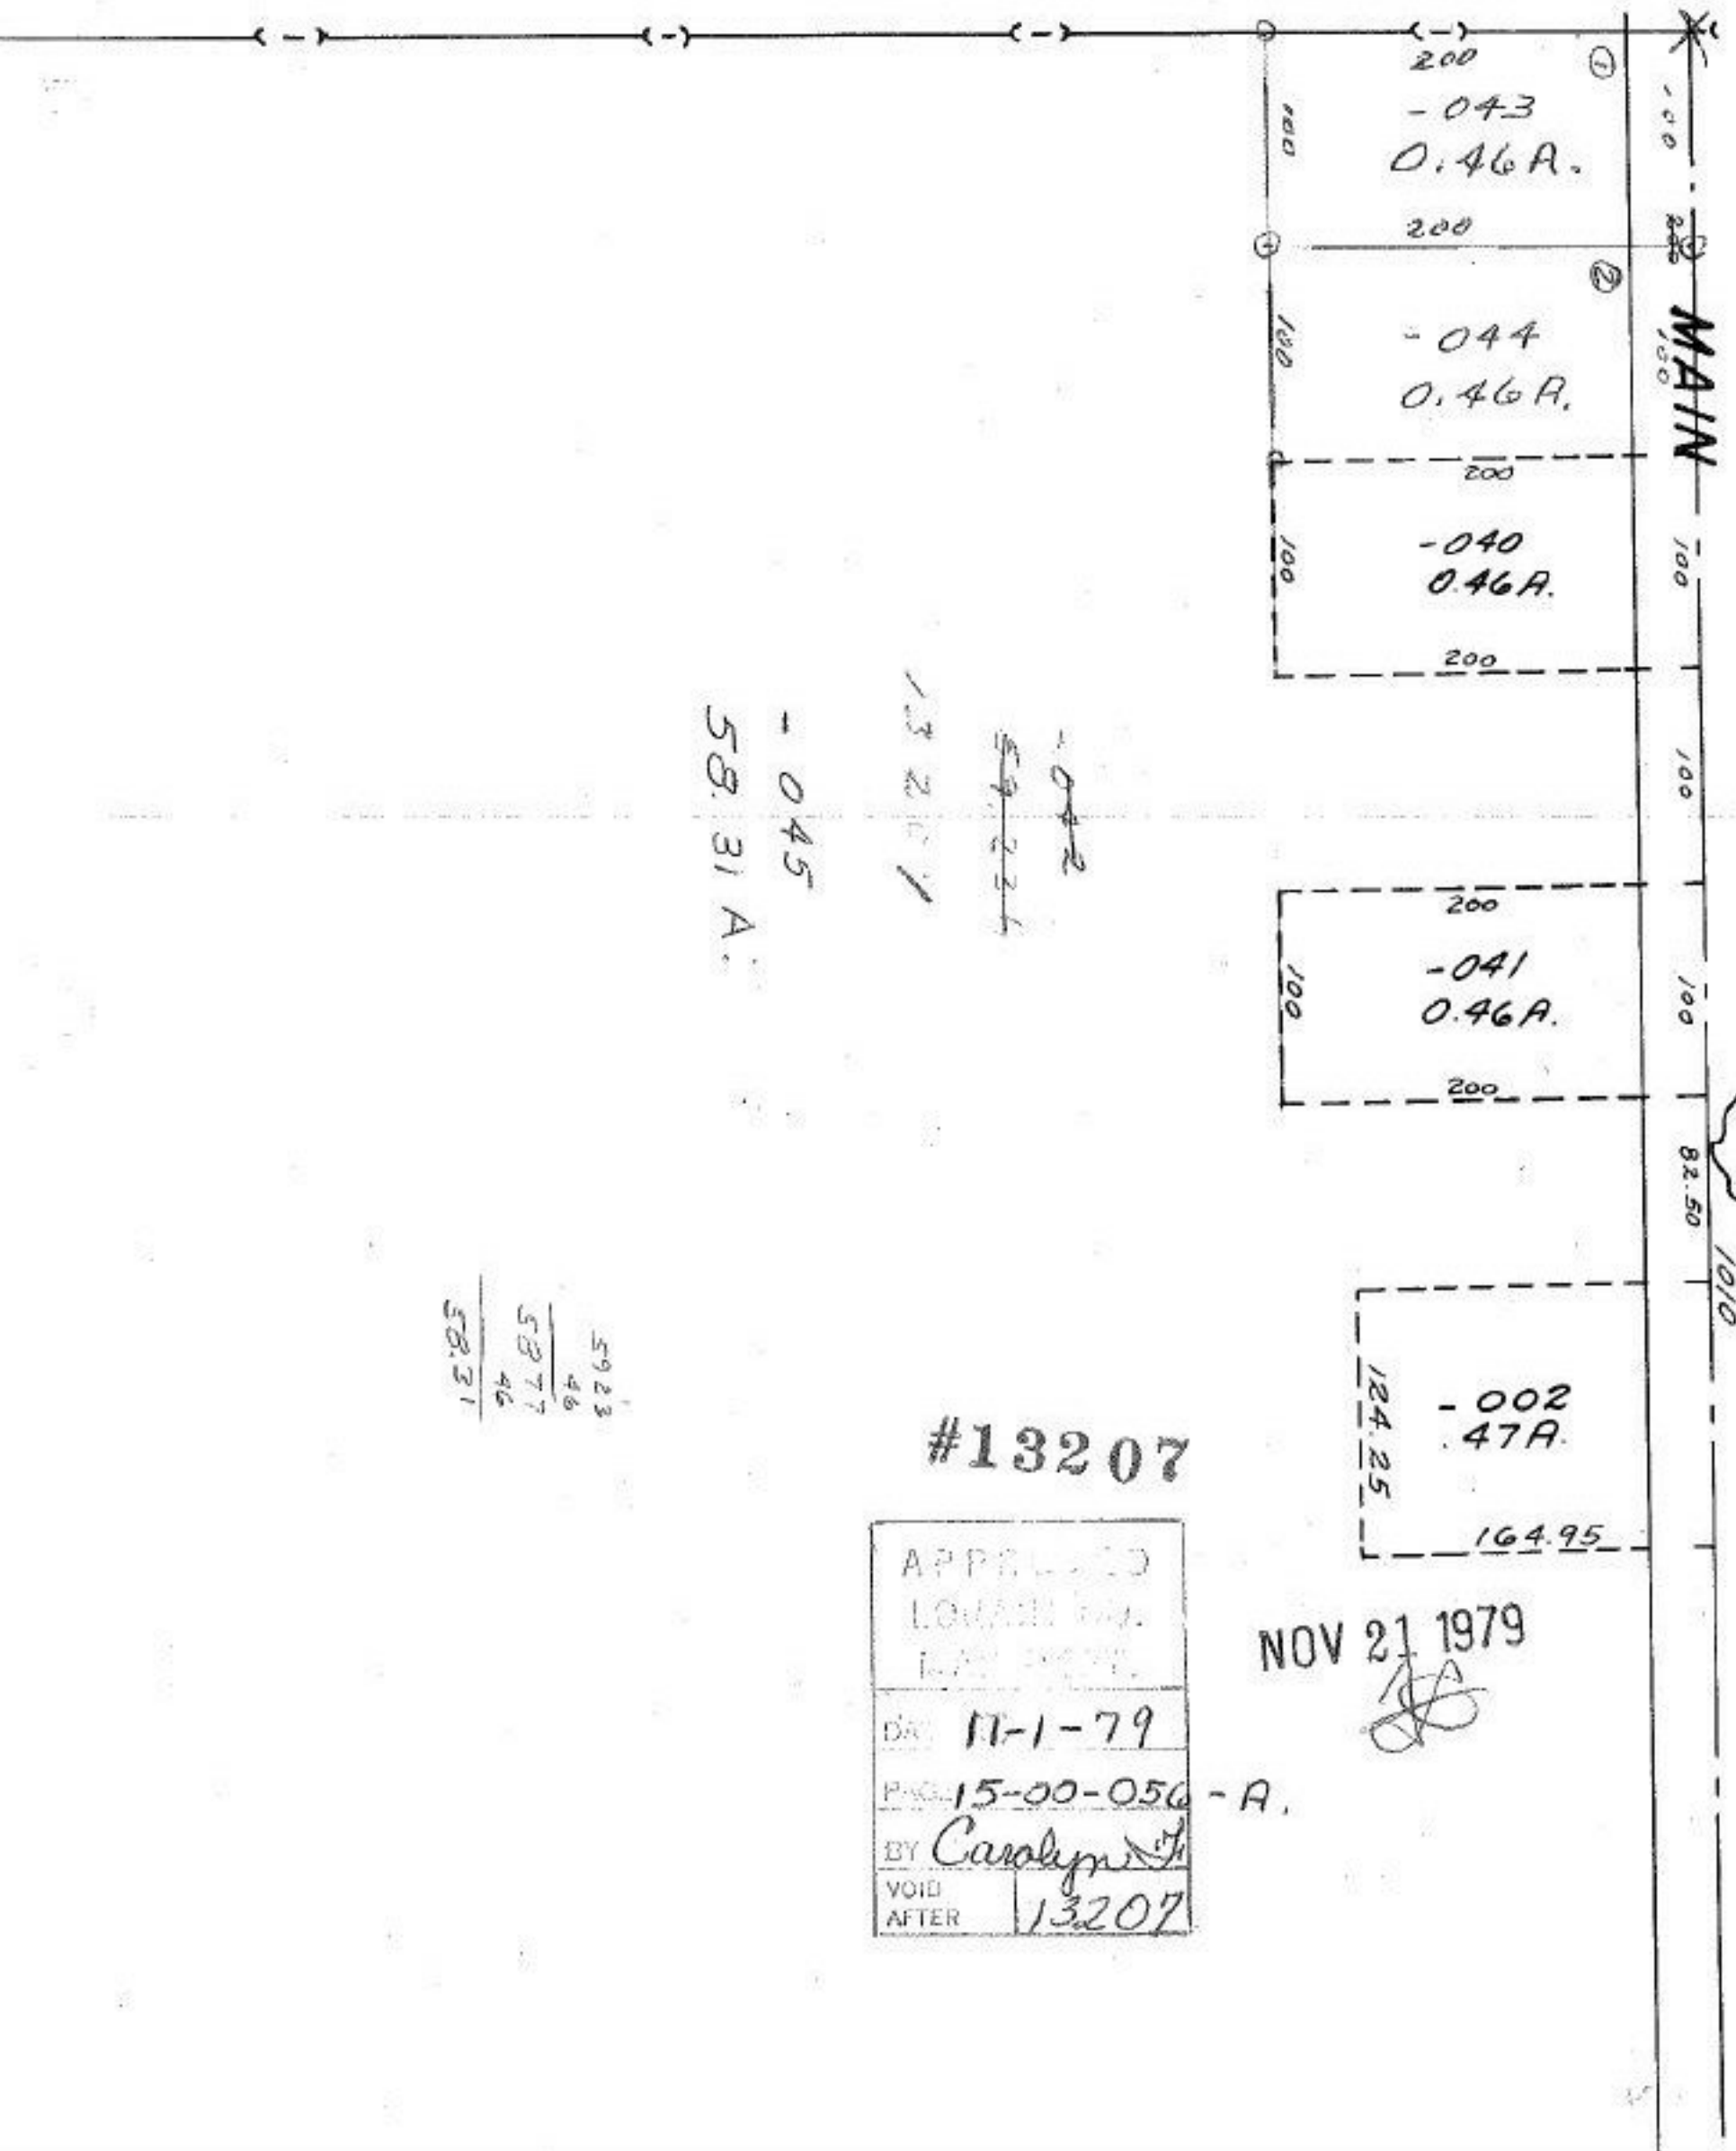

~~- 042~~
~~59.224~~
 132.07
 - 045
 58.31 A.

59.23
 46
 58.77
 46
 58.31

#13207

APPROVED	
LOANED BY	
DATE	
DATE	11-1-79
PROJECT	
15-00-050 - A.	
BY <i>Carolyn J.</i>	
VOID AFTER	13207

NOV 21 1979
[Signature]

303 SEE 15-00-045-A
 1010