


#13215

PECK - WADSWORTH

1162.54

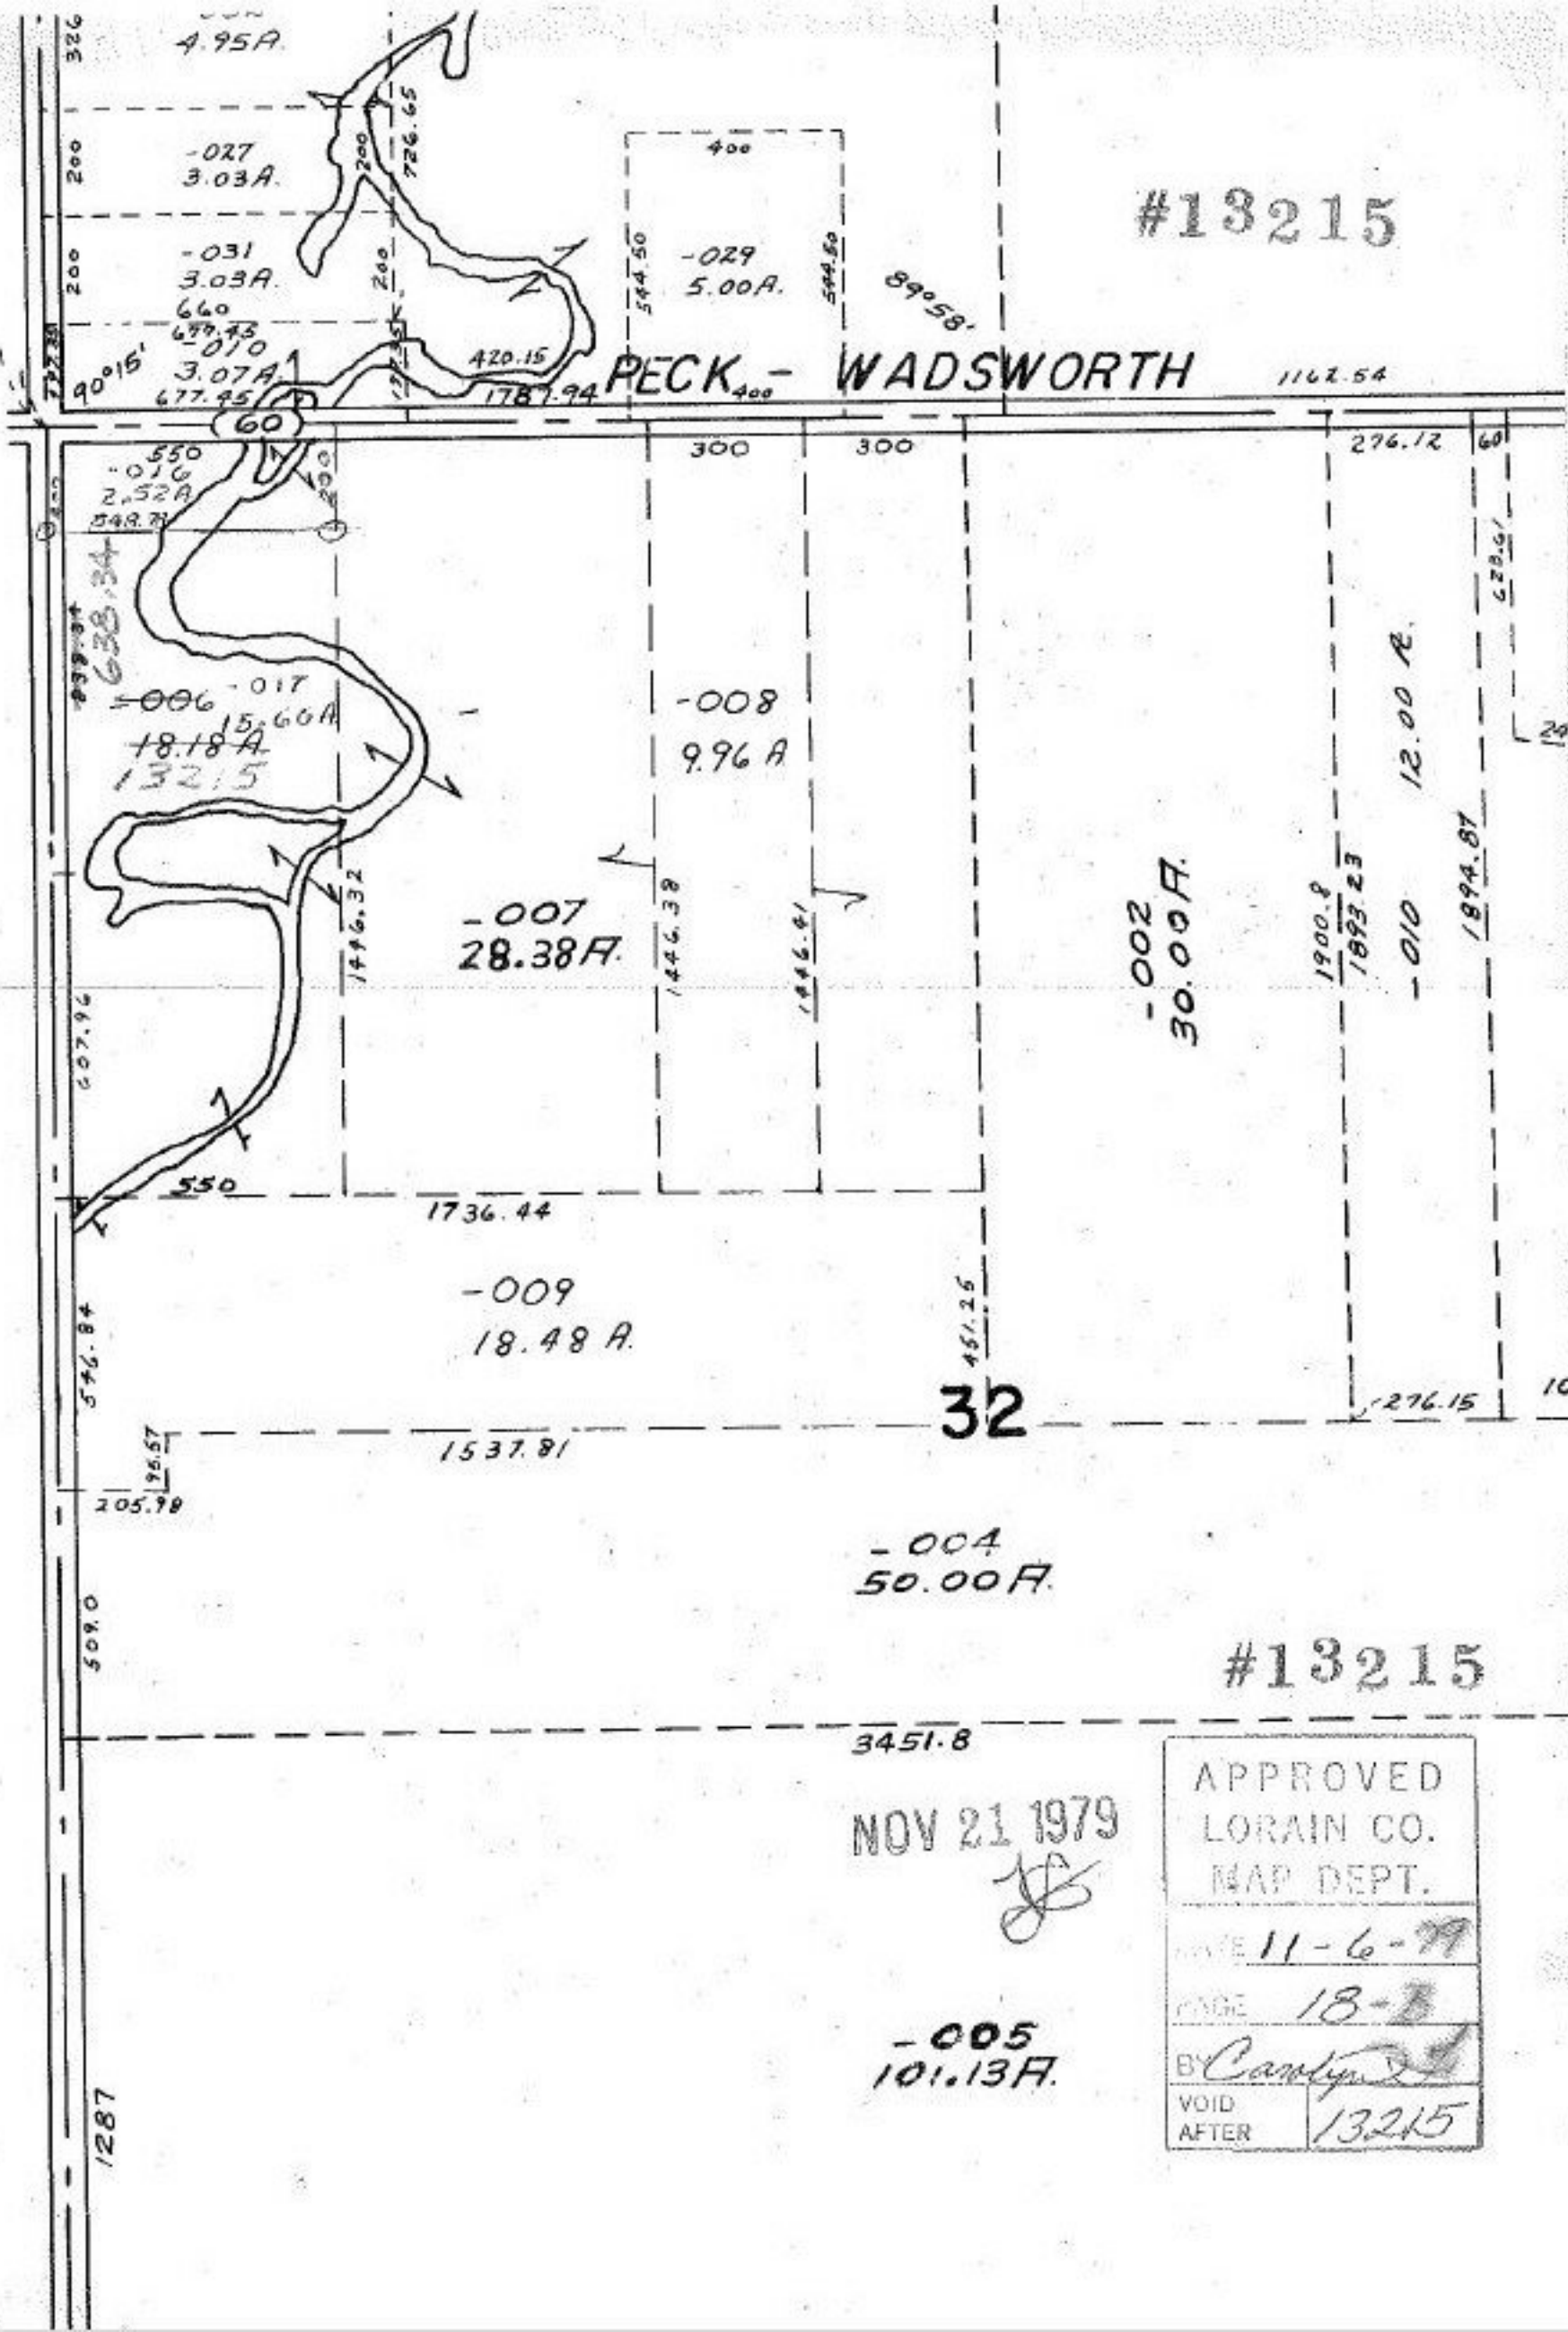

SEE 18-A

#13215

NOV 21 1979

[Handwritten signature]

-005
101.13F.

APPROVED	
LORAIN CO.	
MAP DEPT.	
DATE	11-6-79
PAGE	18-2
BY	<i>[Handwritten signature]</i>
VOID AFTER	13215