


#13220

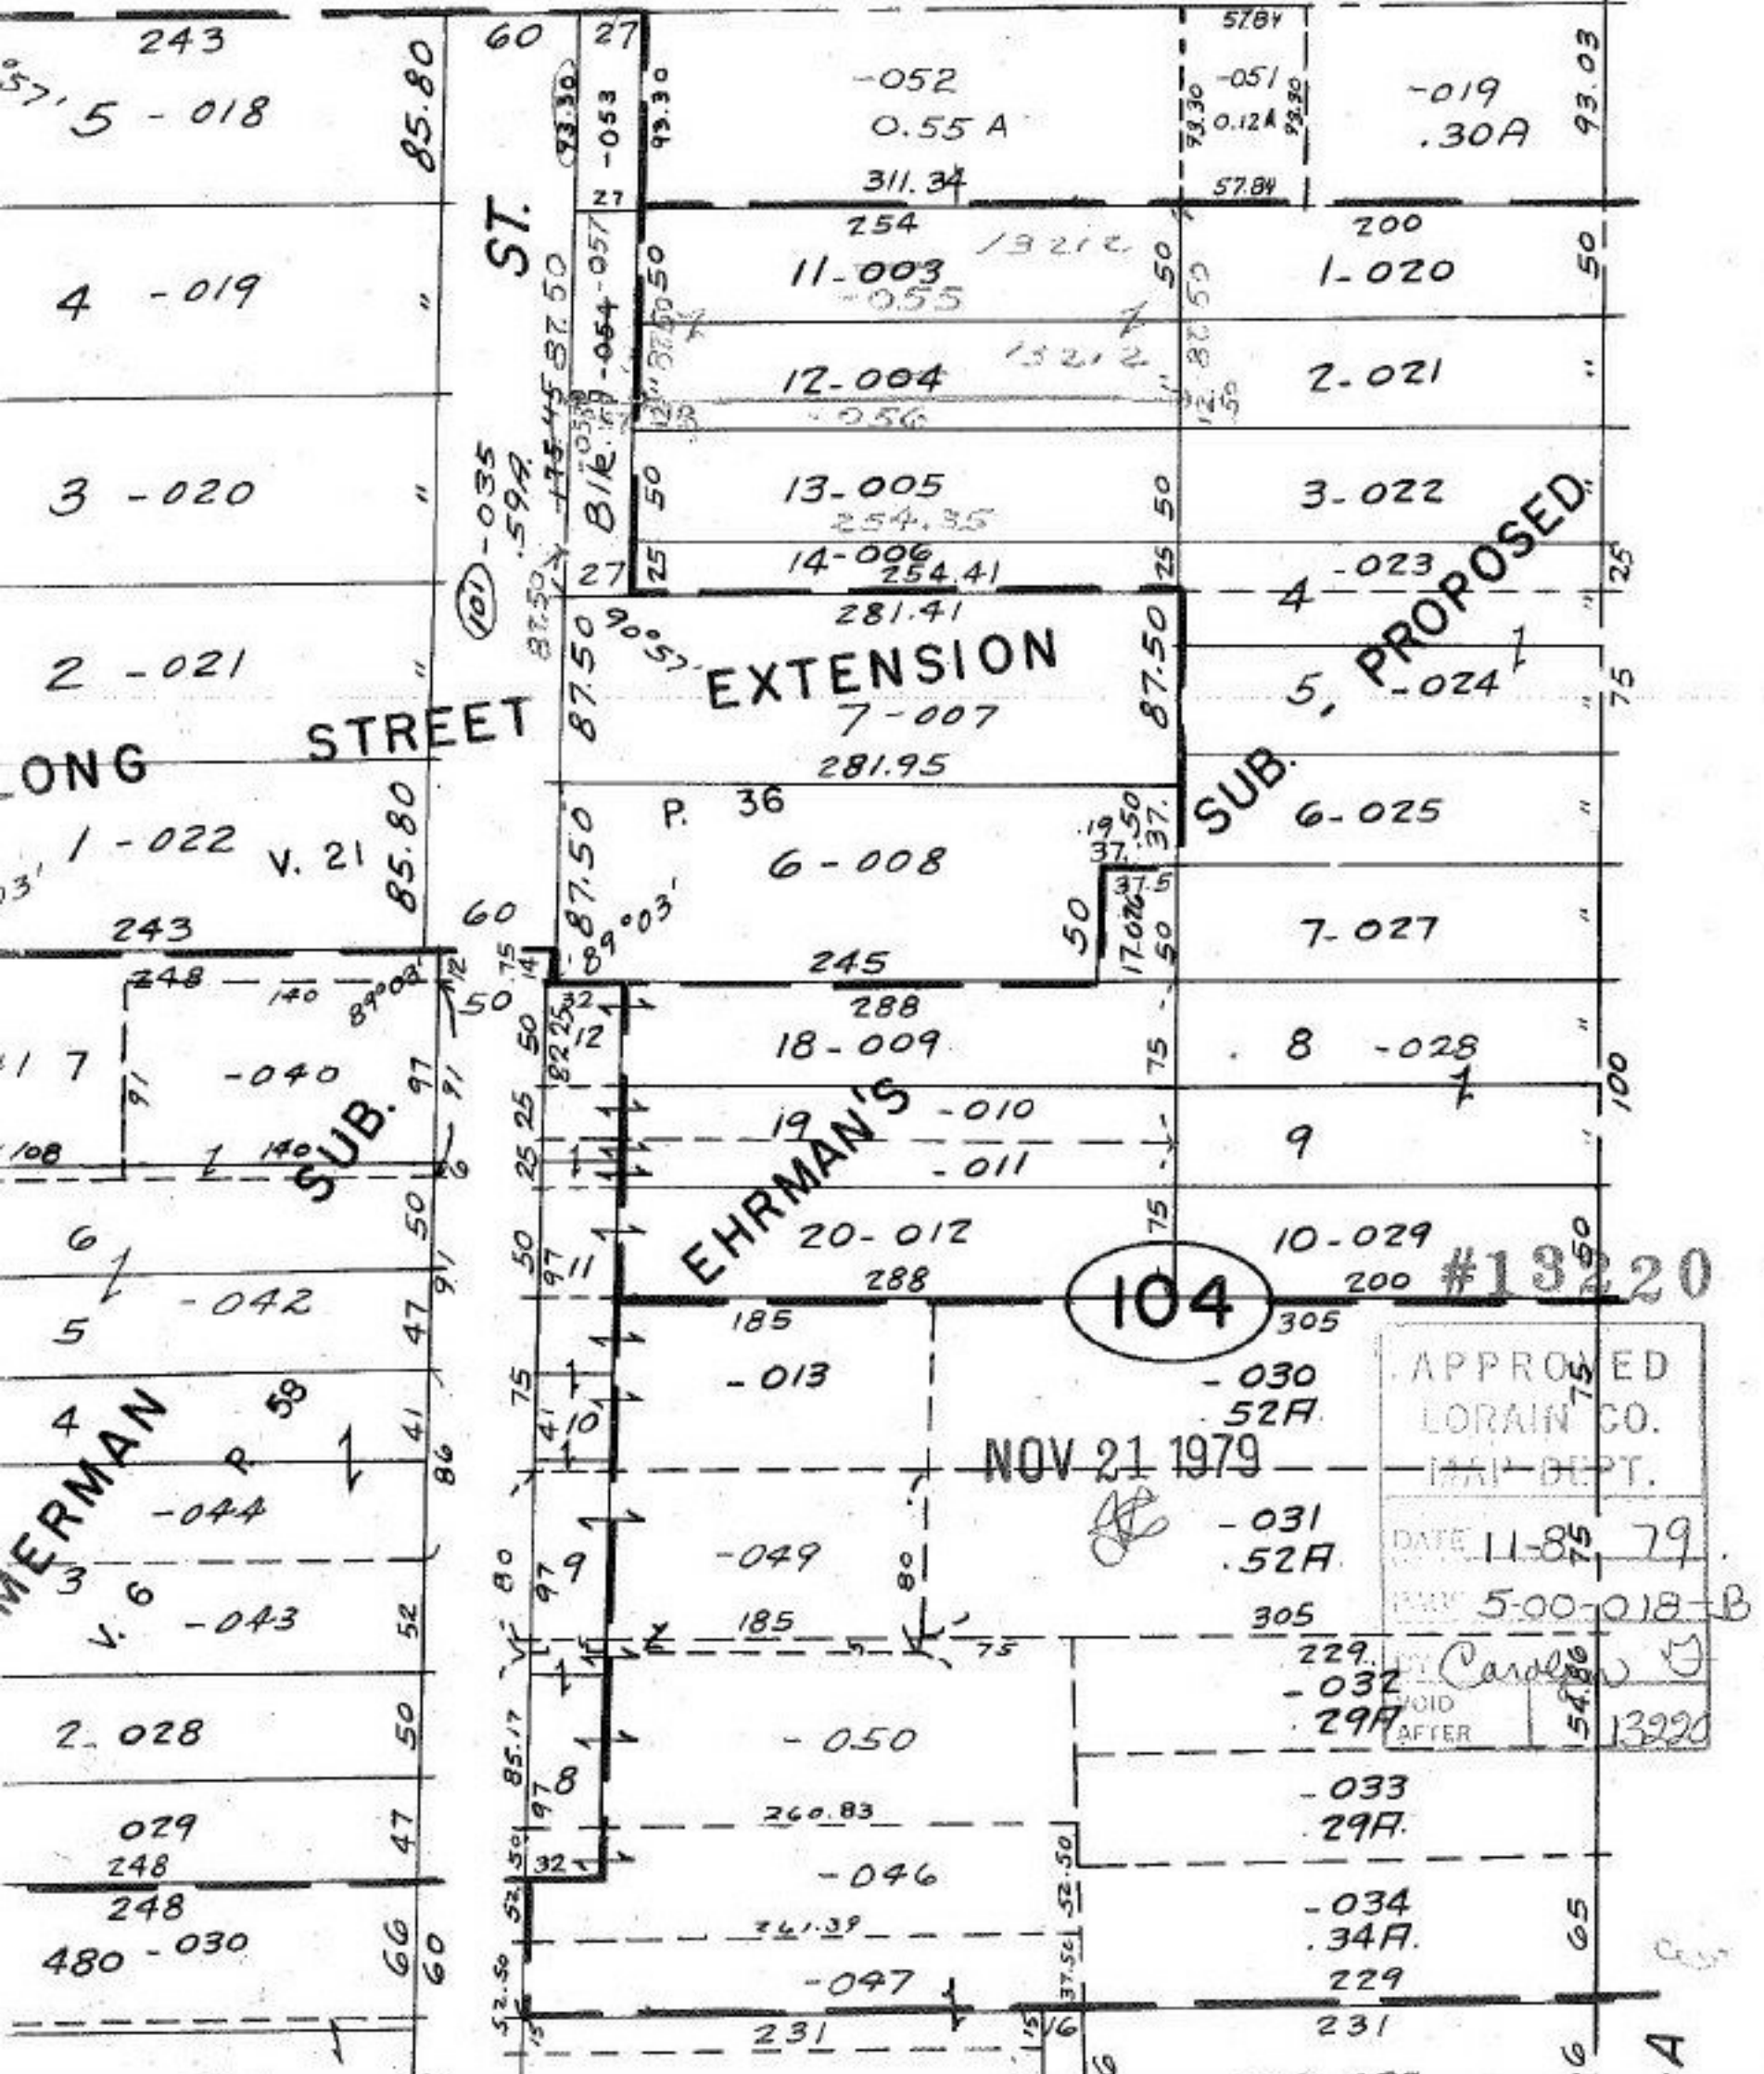

EXTENSION

SUB. PROPOSED

EHRMAN'S

104

NOV 21 1979

APPROVED  
LORAIN CO.  
PLAT DEPT.  
DATE 11-85 79  
BY 5-00-018-B  
Carole  
VOID AFTER 5486 13220

#13220