


#13223

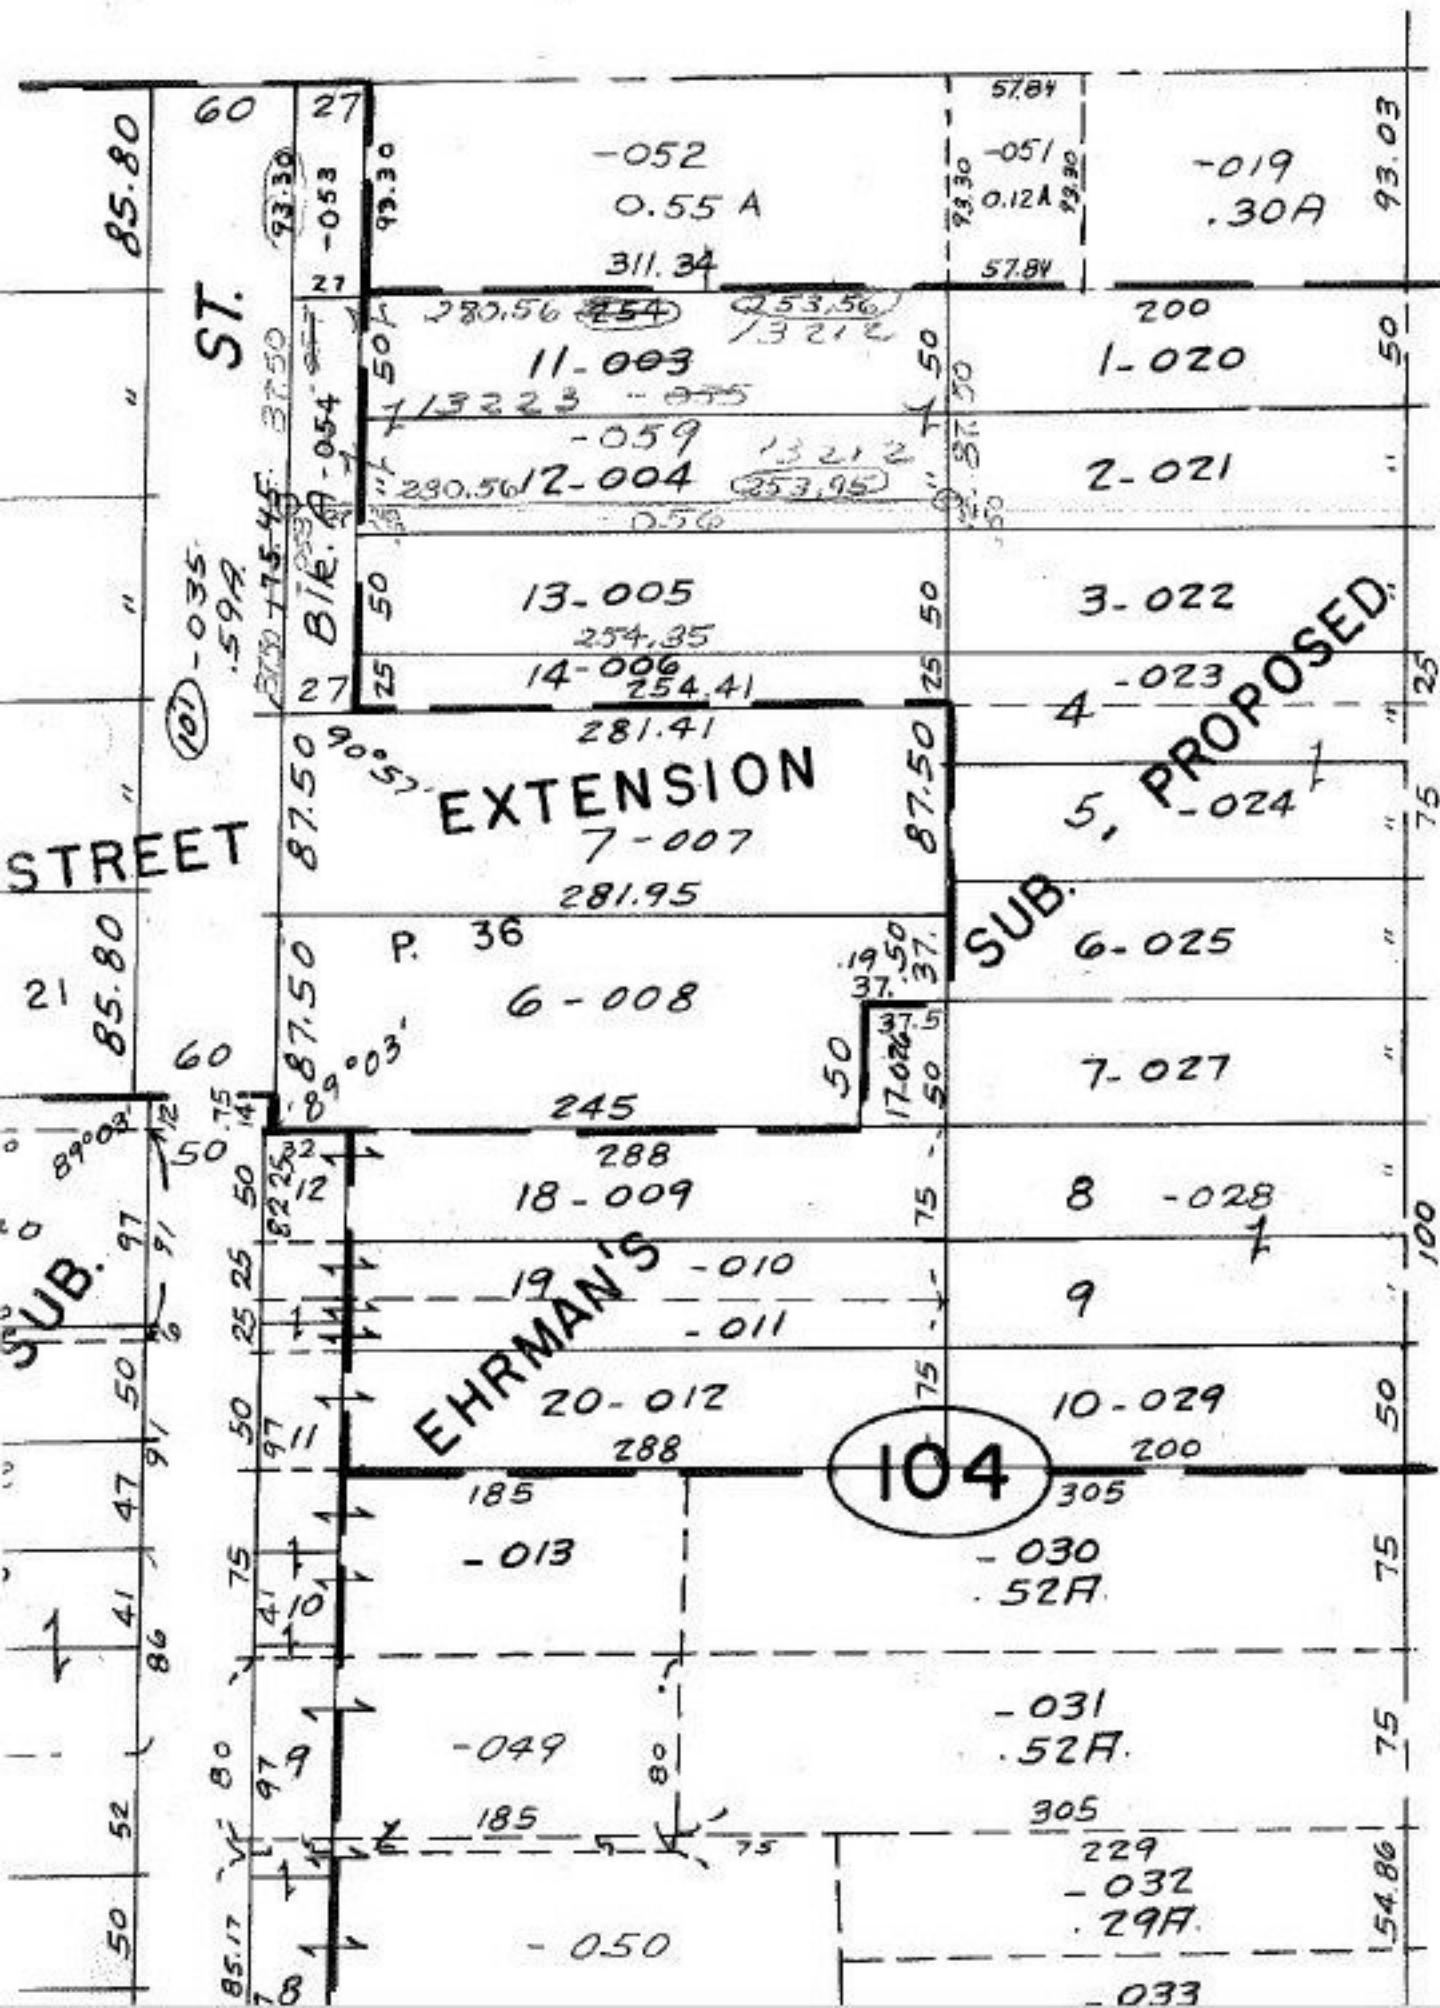

#13223

APPROVED
LORAIN CO.
MAP DEPT.
DATE 11-9-79
PAGE 5-00-018-B
BY Carolyn
VOID AFTER 13223

NOV 21 1979

[Signature]