

DEDICATION


GARGASZ STREET

COOPER - FOSTER - PARK - RD!

259 - 01	127.69	62
258 - 032	127.97	62
257 - 037	128.07	62
256 - 034	128.80	65
255 - 035	129.89	93.05

130	129.89	87.93
1.02A	316.26	259.68

254 SUB.	169.85	65
239	119.41	40
238 - 005 VOL	89.31	40
301 PG	150.86	65
240 - 016	141.29	65
241	131.73	65
242 - 014	128.26	65
243 - 013	99.23	65
244	65.02	65
6	128.26	60
226 - 036	134.66	60
227 - 037	134.67	60

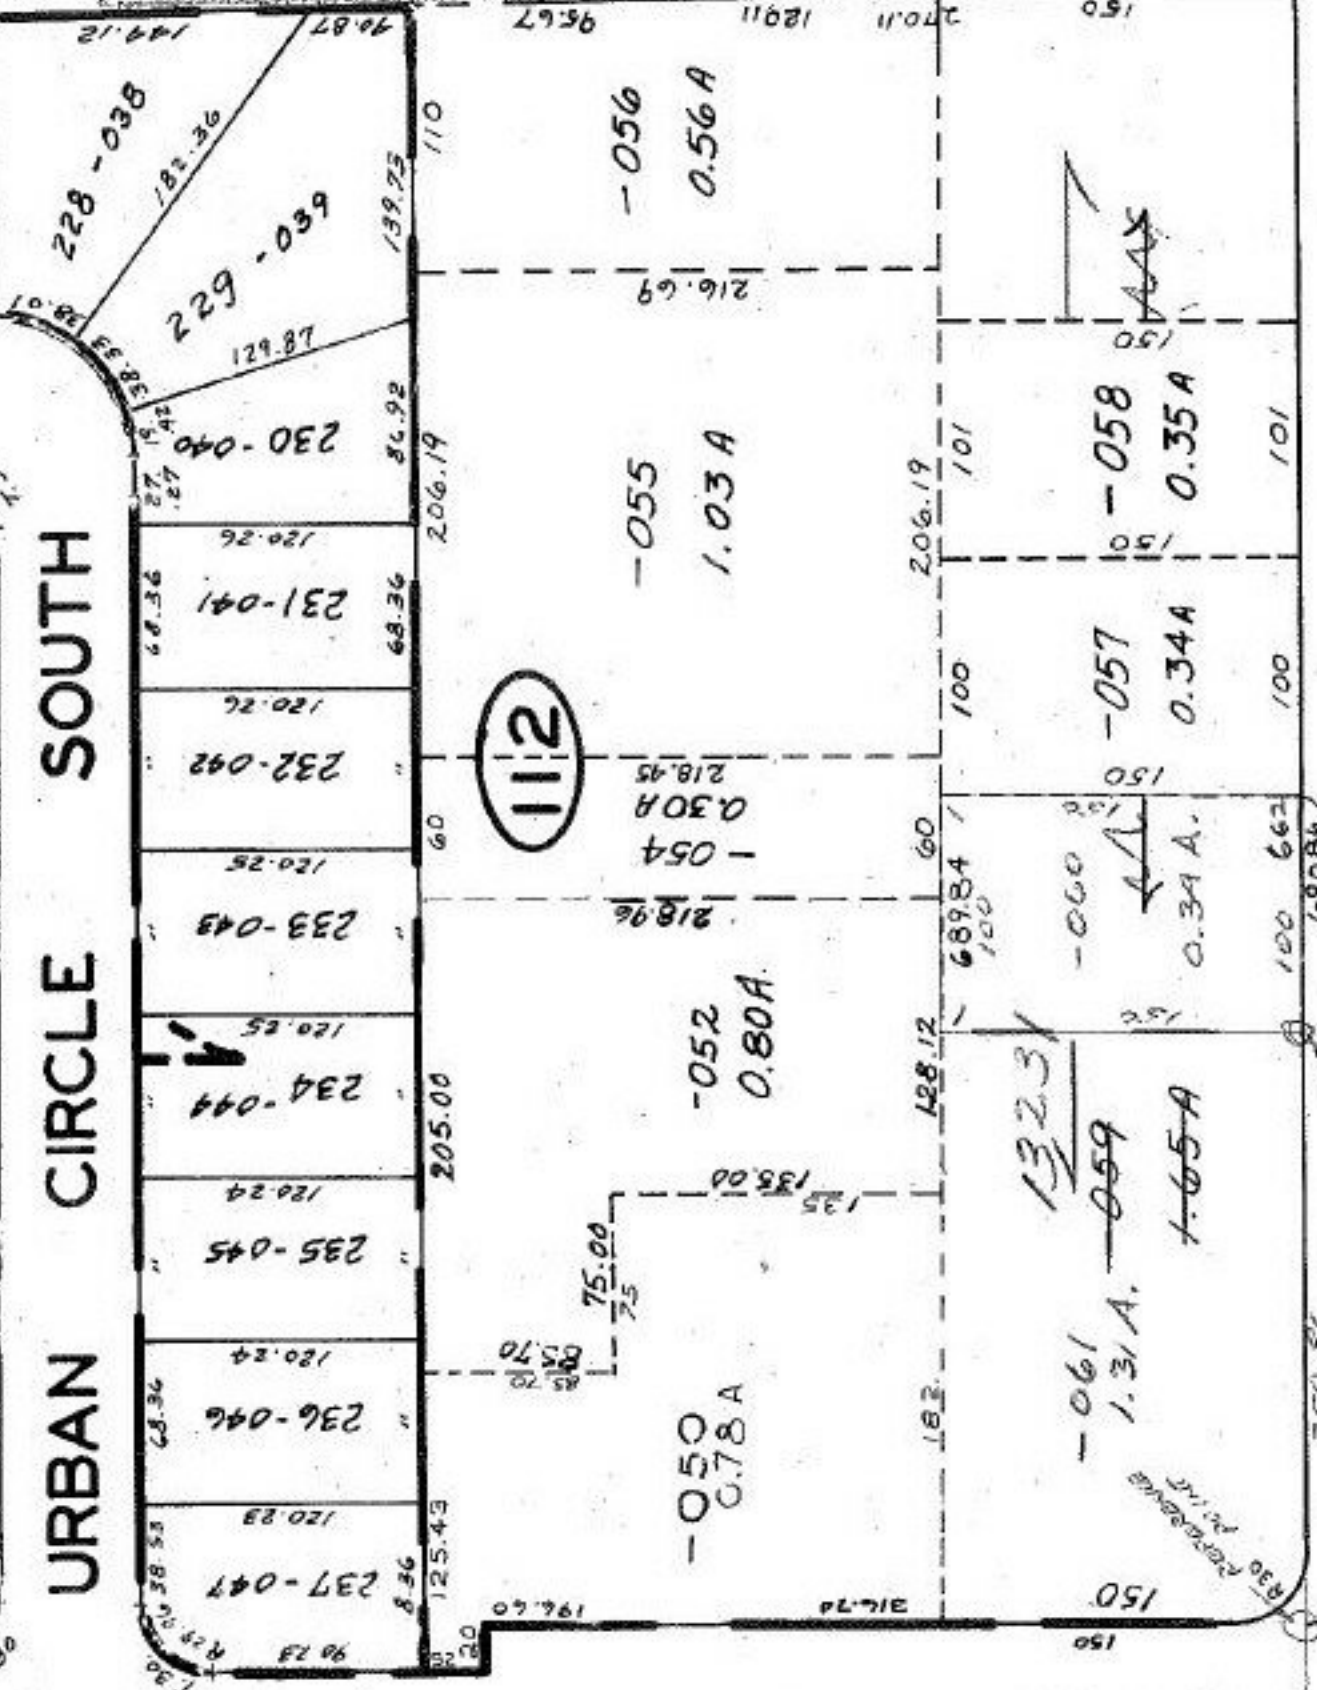

#13231  
 APPROVED  
 LORAIN CO.  
 MAP DEPT.  
 DATE 11-13-79  
 PAGE 02-02-004-B  
 BY T. McMillan  
 13231

NOV 26 1979  
 365 78

1.65  
 1.34  
 1.31  
 1.34  
 1.03