


#13234

3/23/76 15

104 65  
104

11-21-79  
CHANGES IN ROAD MADE  
PER A. KOEPP SURVEY  
INFORMATION OF  
COUNTY ENGINEER BY  
A.P. JEANGLA

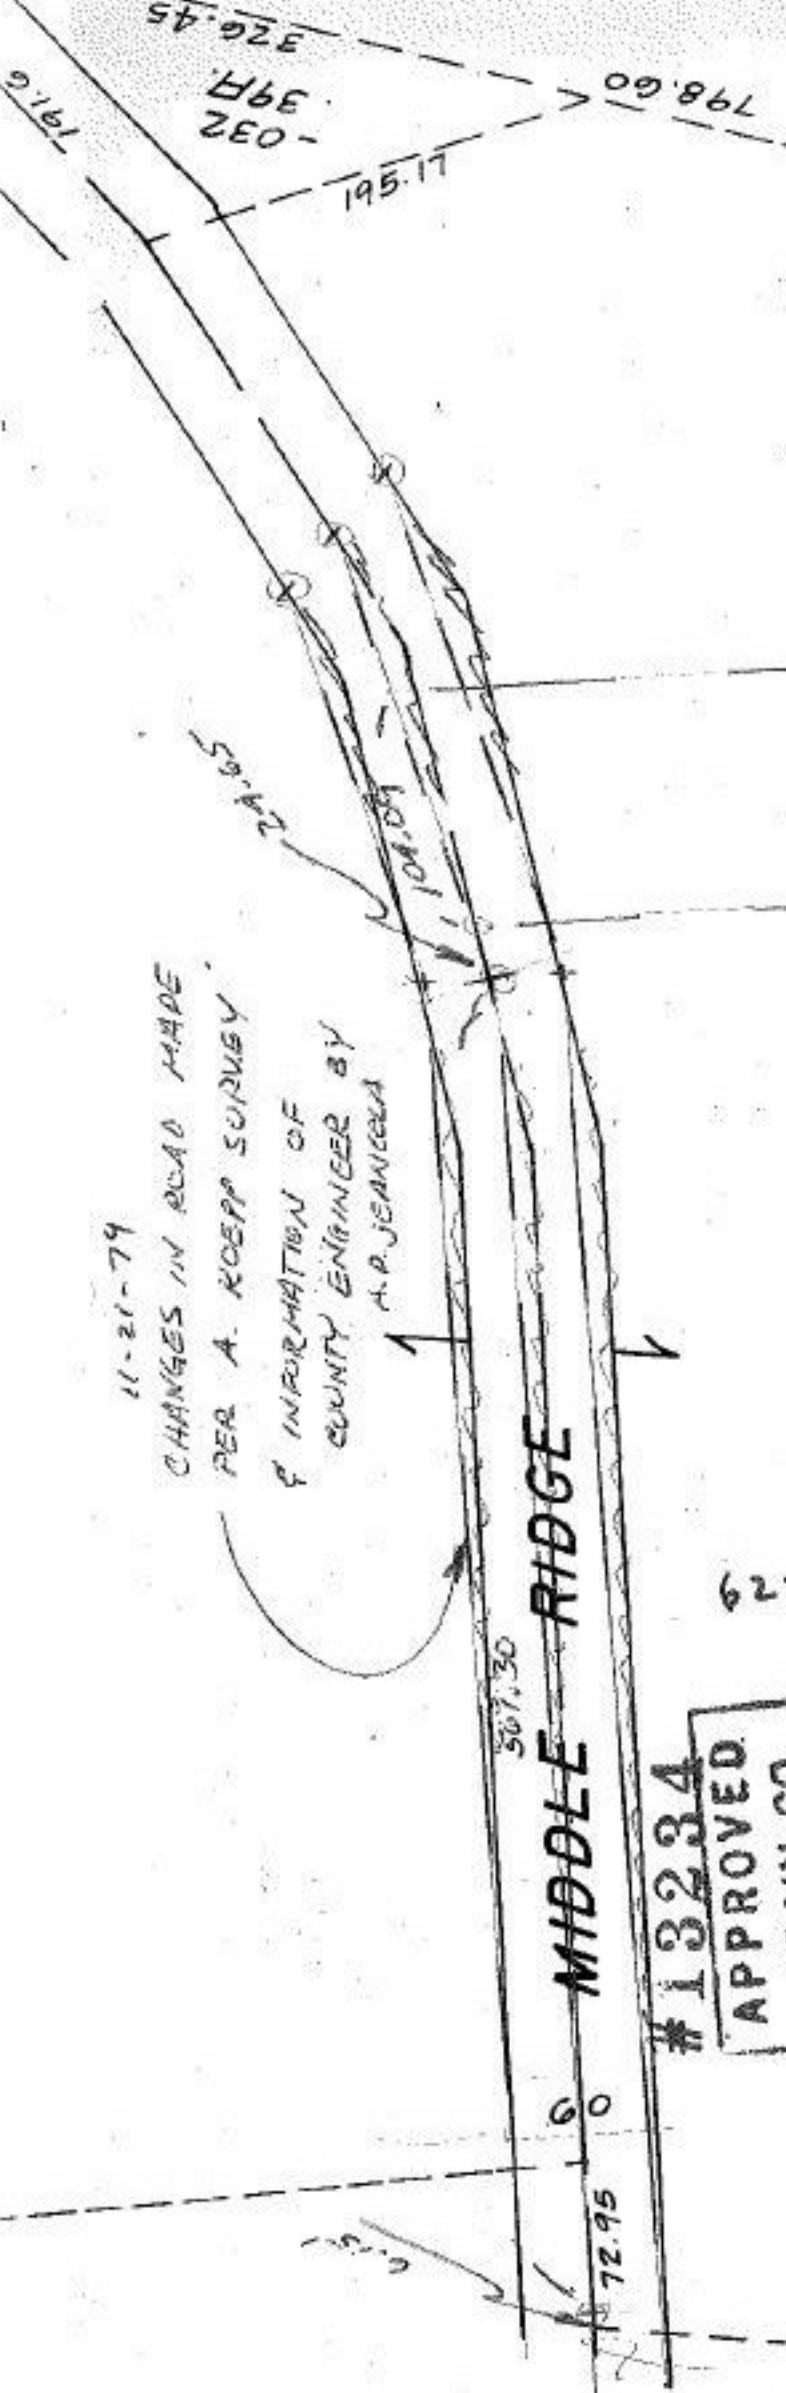

473.50  
-065  
1.14 A.  
518.20

101.24  
415.80

62-9-21  
TH

#13234
APPROVED
LORAIN CO.
MAP DEPT.
DATE 11-23-79
PAGE 5-00-045-B
BY T. McNamee
VOID AFTER

-066  
31.11 A.  
~~062~~  
32.25A  
136.34

32.25  
1.14  
31.11  
1.19  
32.25

SEE 5-00-045-A